


#1413

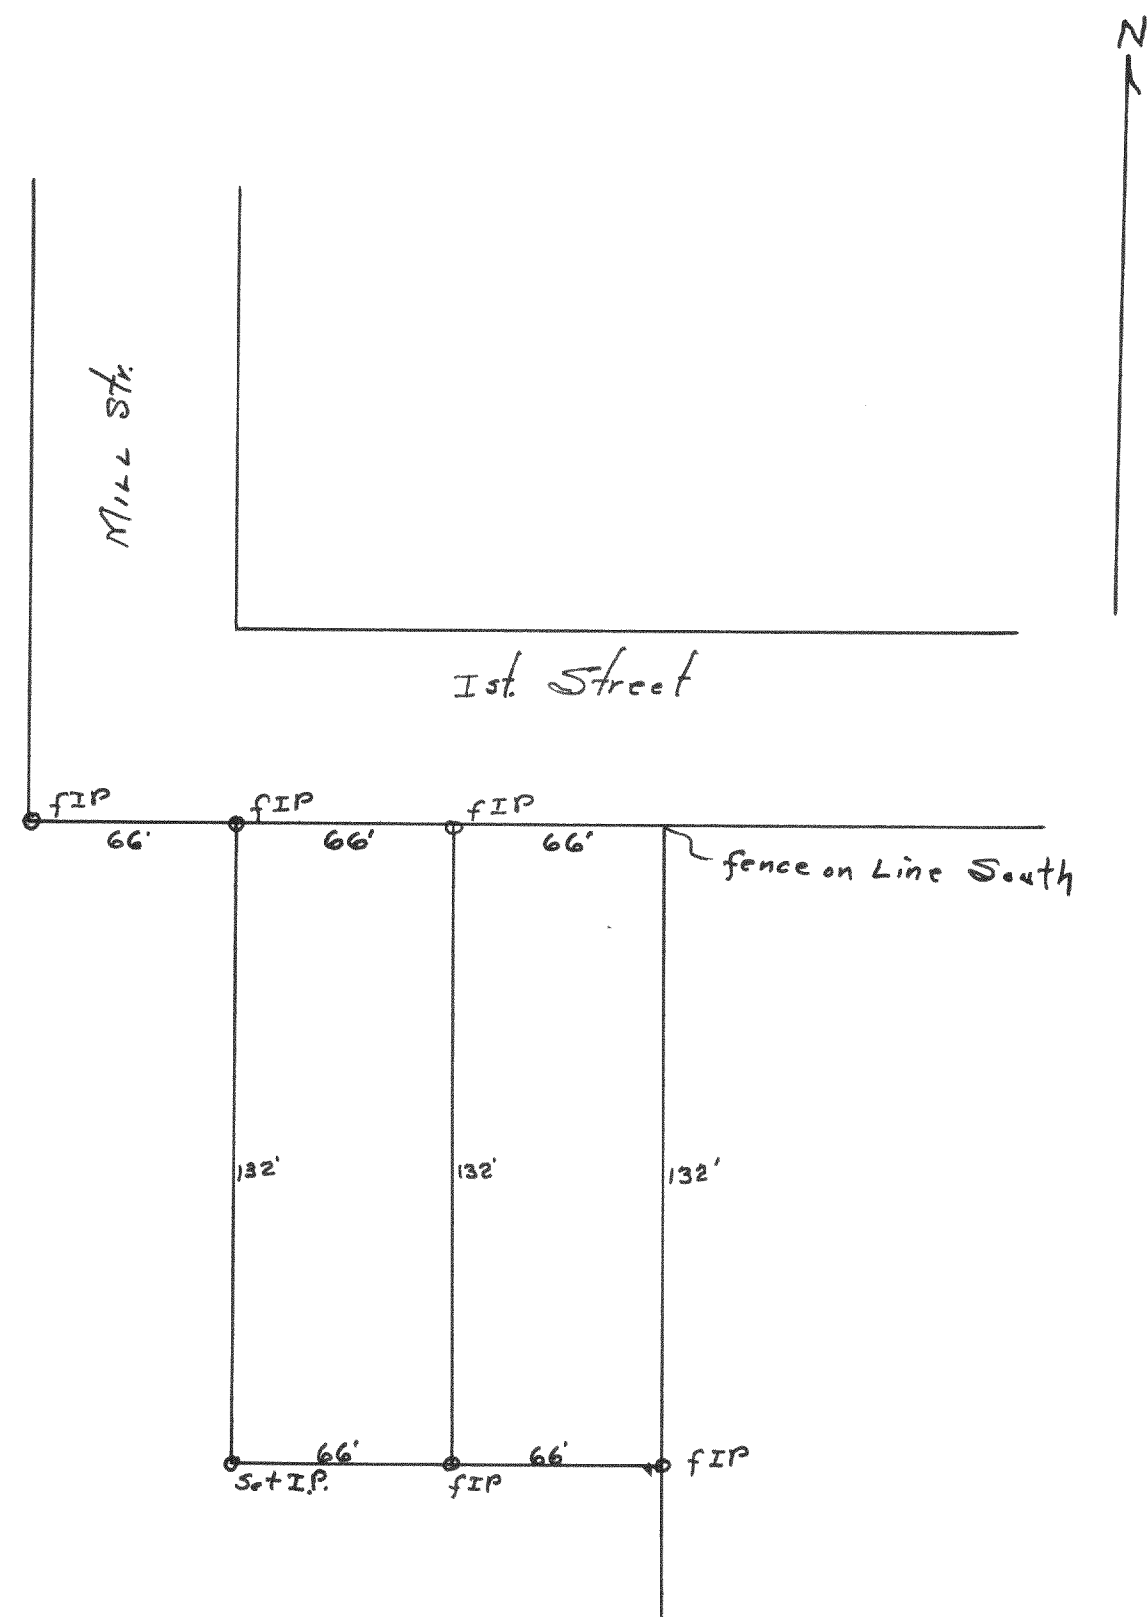


Plot of survey of 2 parcels of land
located in Section 35, Village of
Seneca City.

Jan. 12, 1943

Lloyd S. Jensen
County Surveyor

#1414

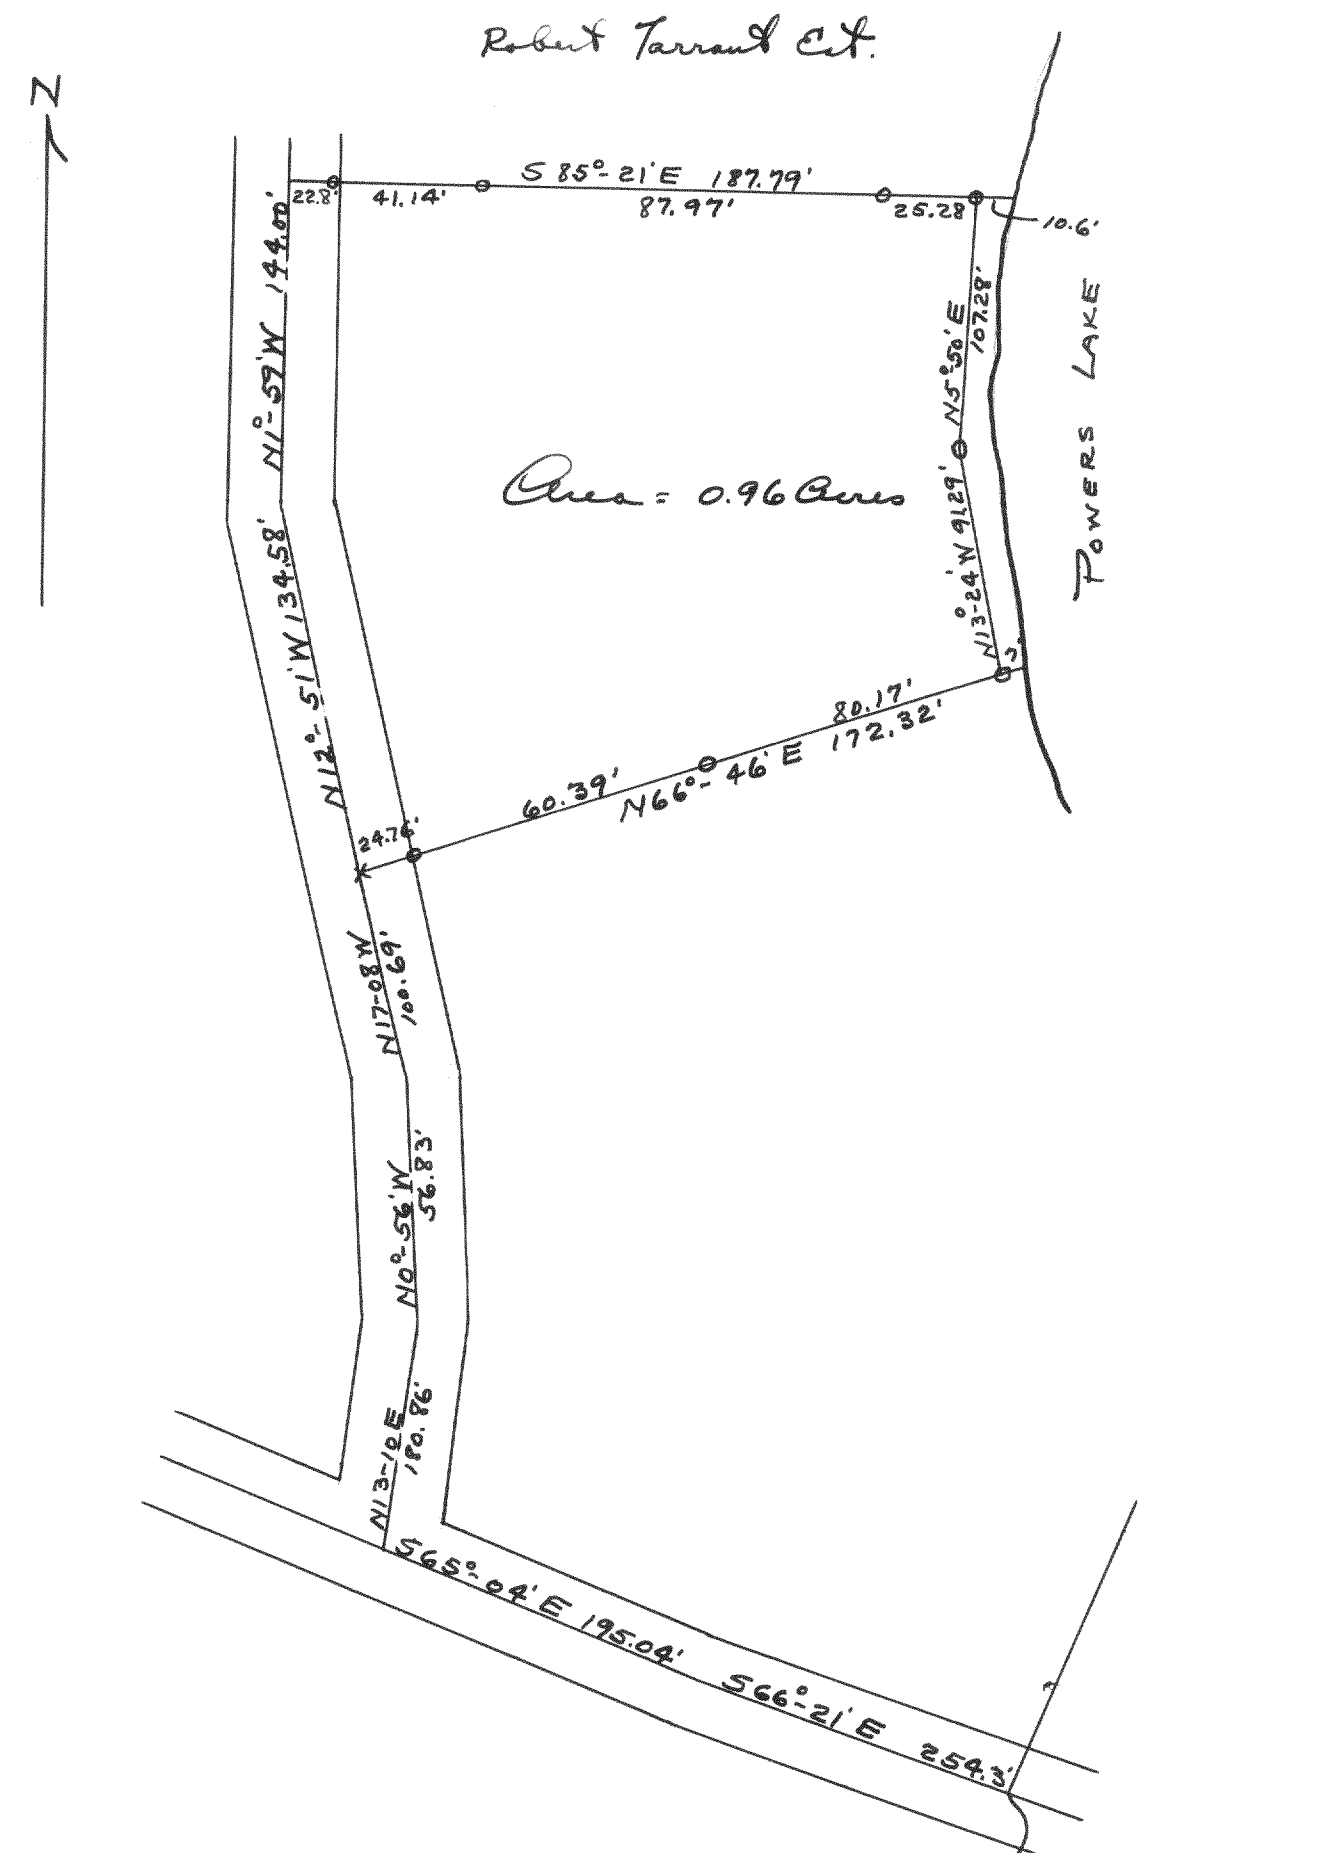

Plot of survey of Robert Tarrant Crt. in
Section 13, T17N R18E.

Dec. 1943

Lloyd S. Jensen
County Surveyor

SW. cor. of the
O.L. of Lake Shore
Subd.