


#1418

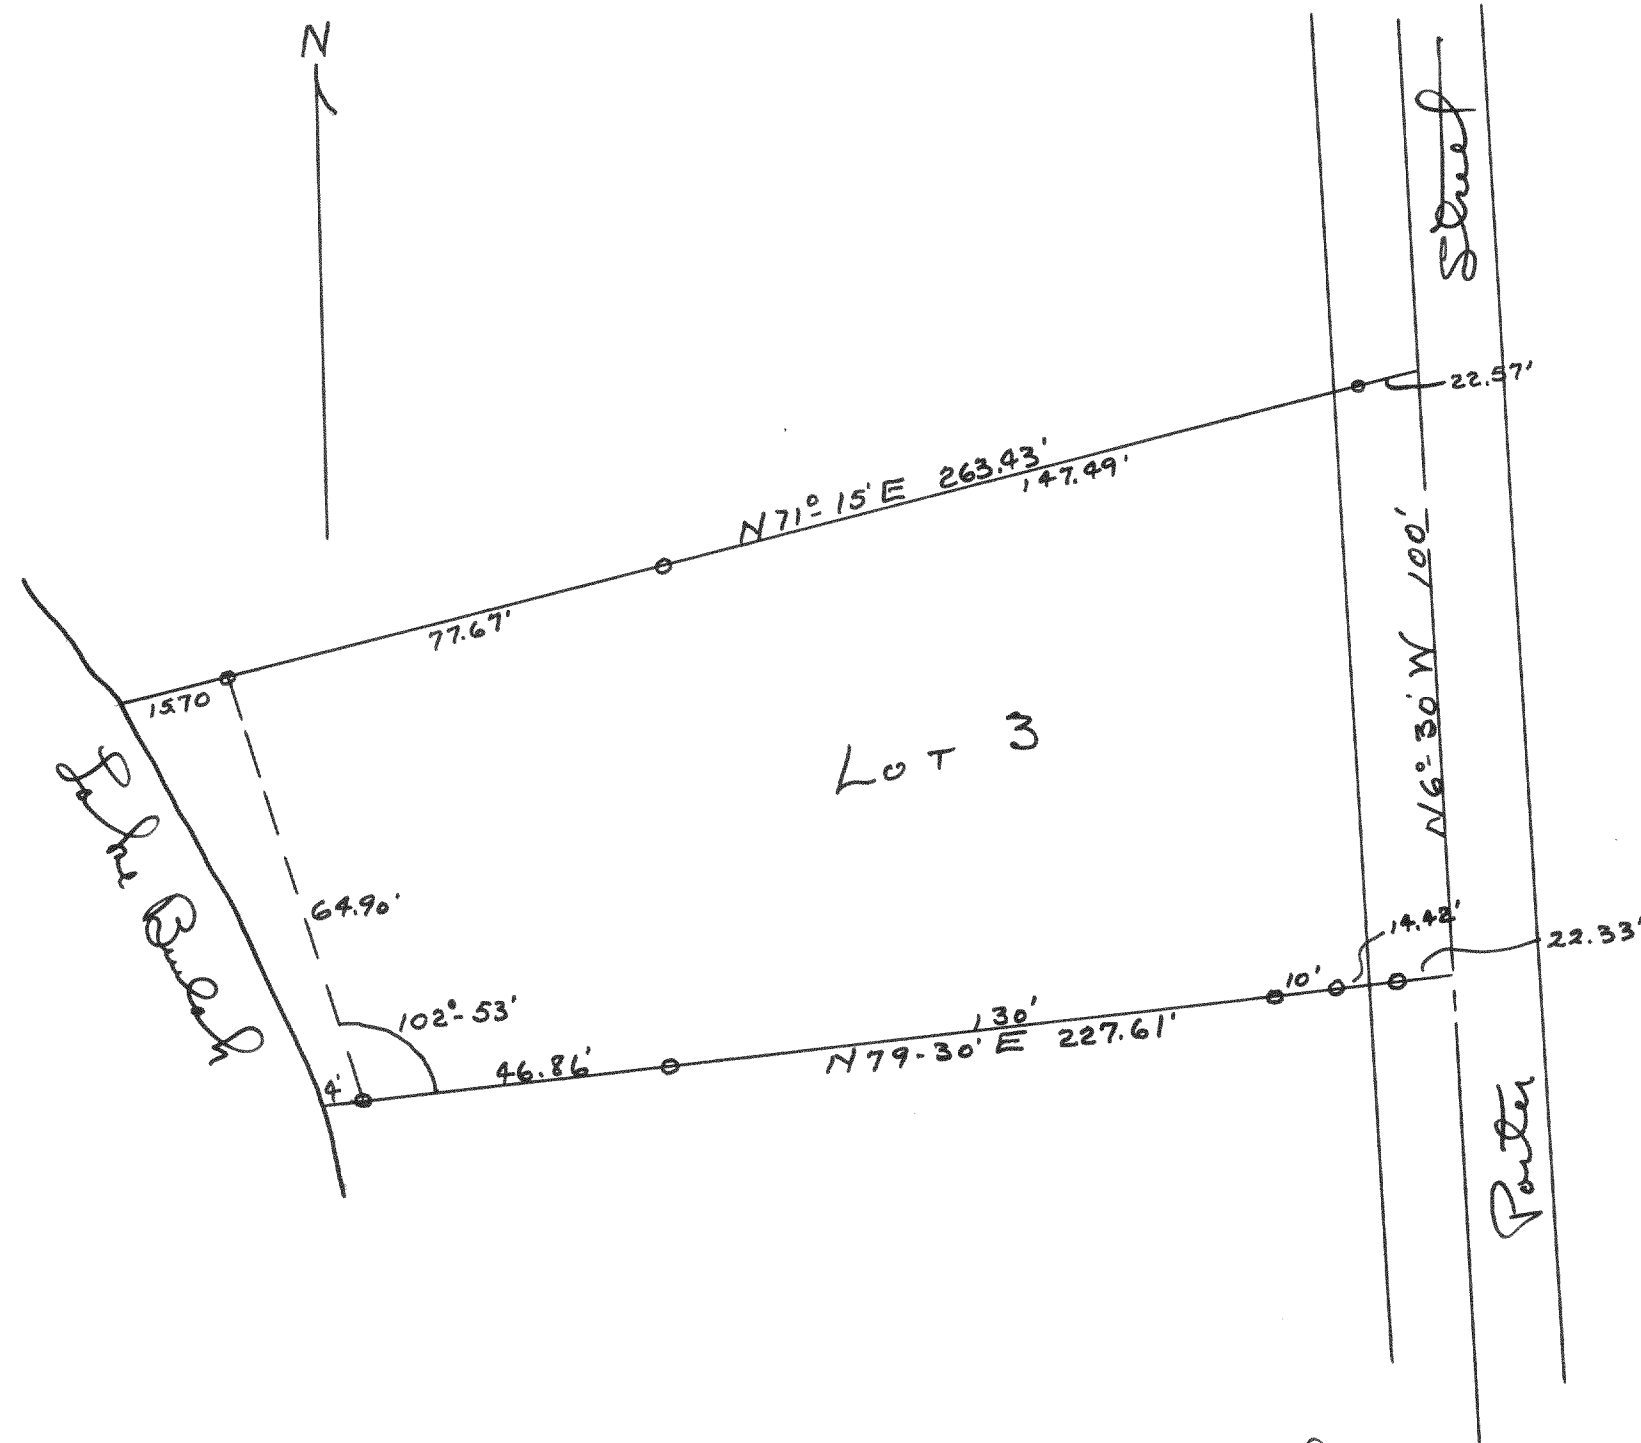


Plat of survey of Lot 3 of Block 2
of Fred Park, Section 4, T47N R18E.

Nov. 1943

Lloyd S. Jensen
County Surveyor

#1419

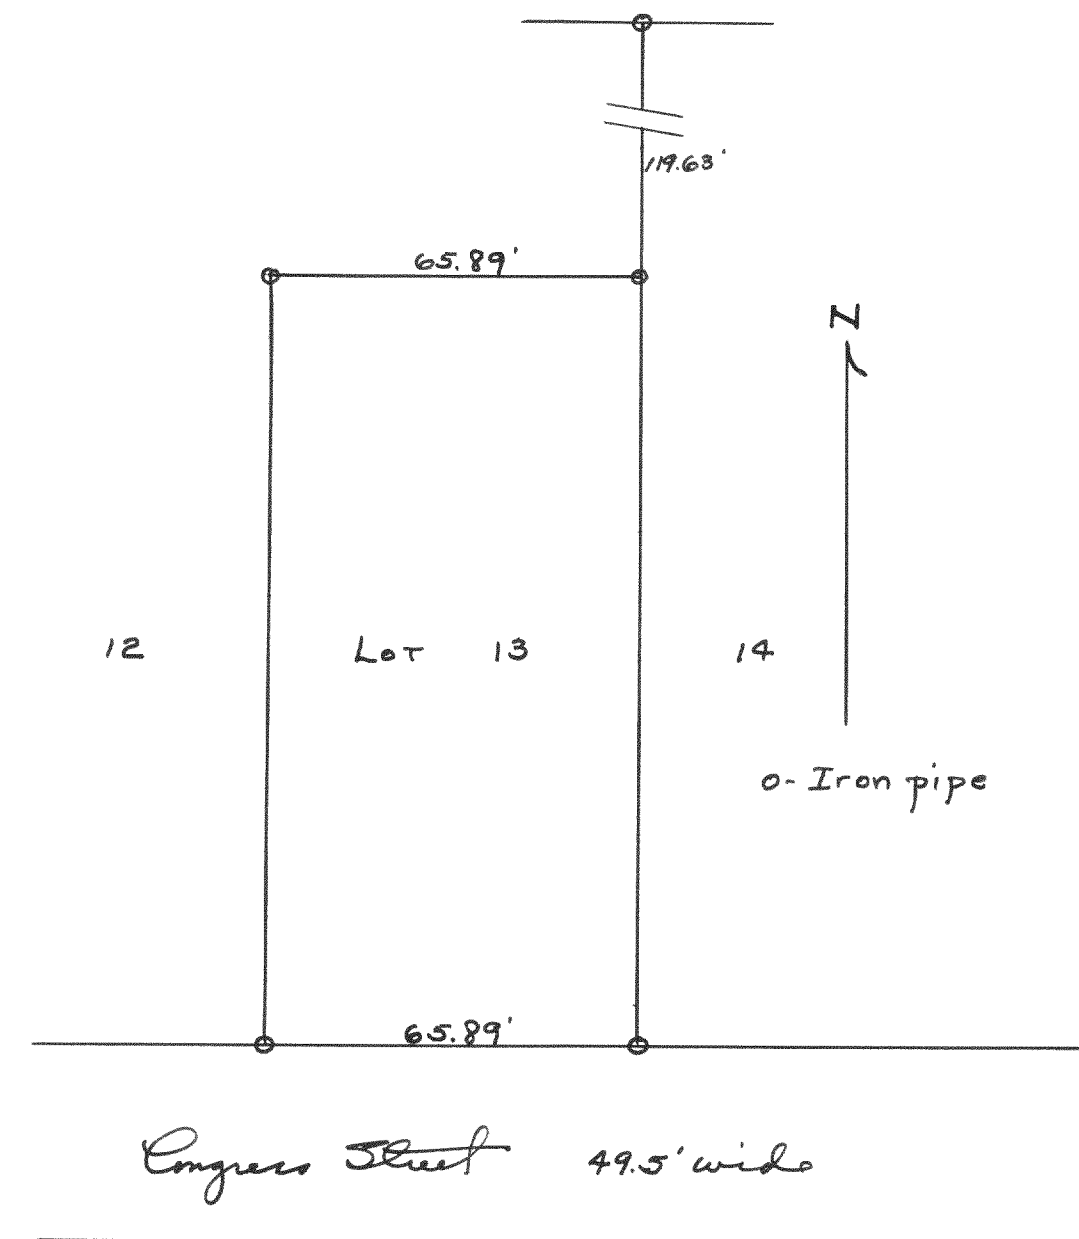

Plat of the survey of Lot 13 of
Johnson's Add. to the Village of
Wm Bay.

Aug. 1943

Lloyd S. Jensen
County Surveyor