


#1420

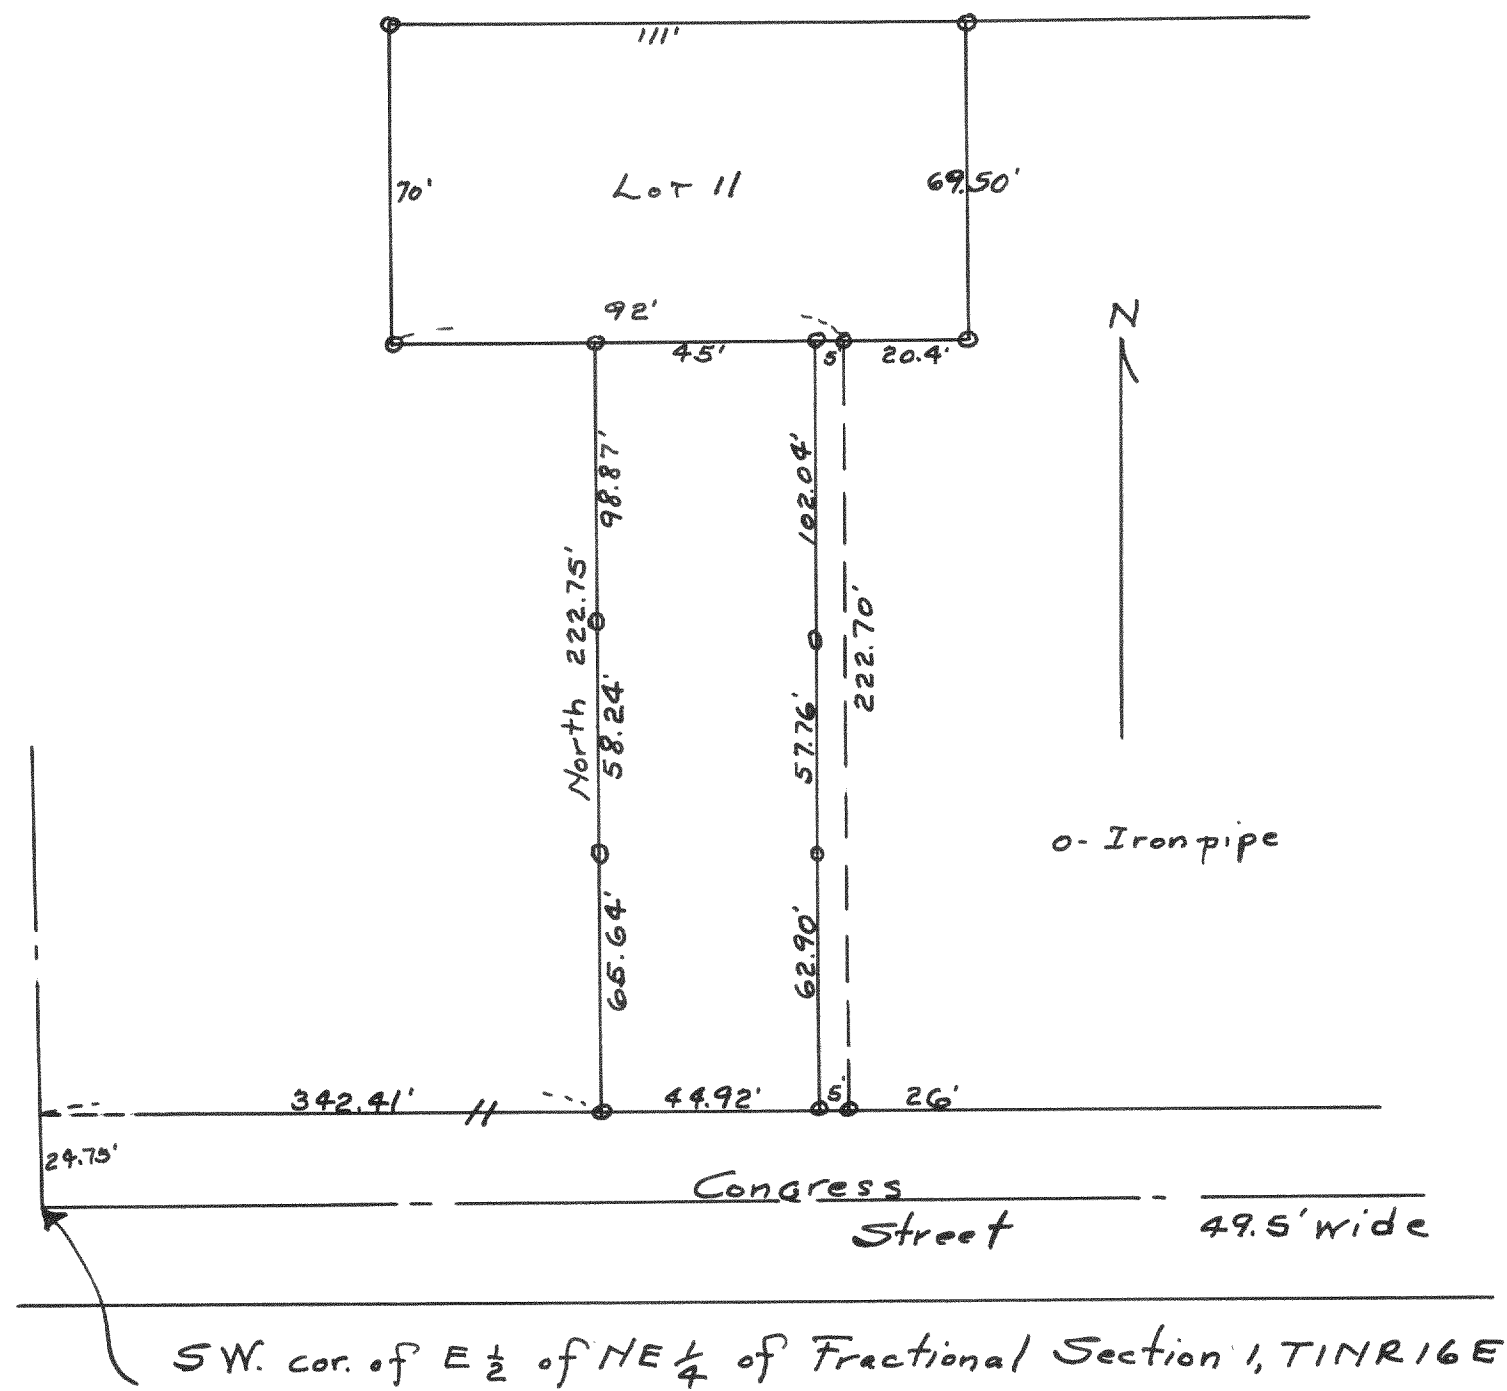


Plot of survey of Lot 11 of Johnson's Add. to
Williams Bay and adjoining land.

Aug. 1943

Lloyd S. Jensen
County Surveyor

#1421

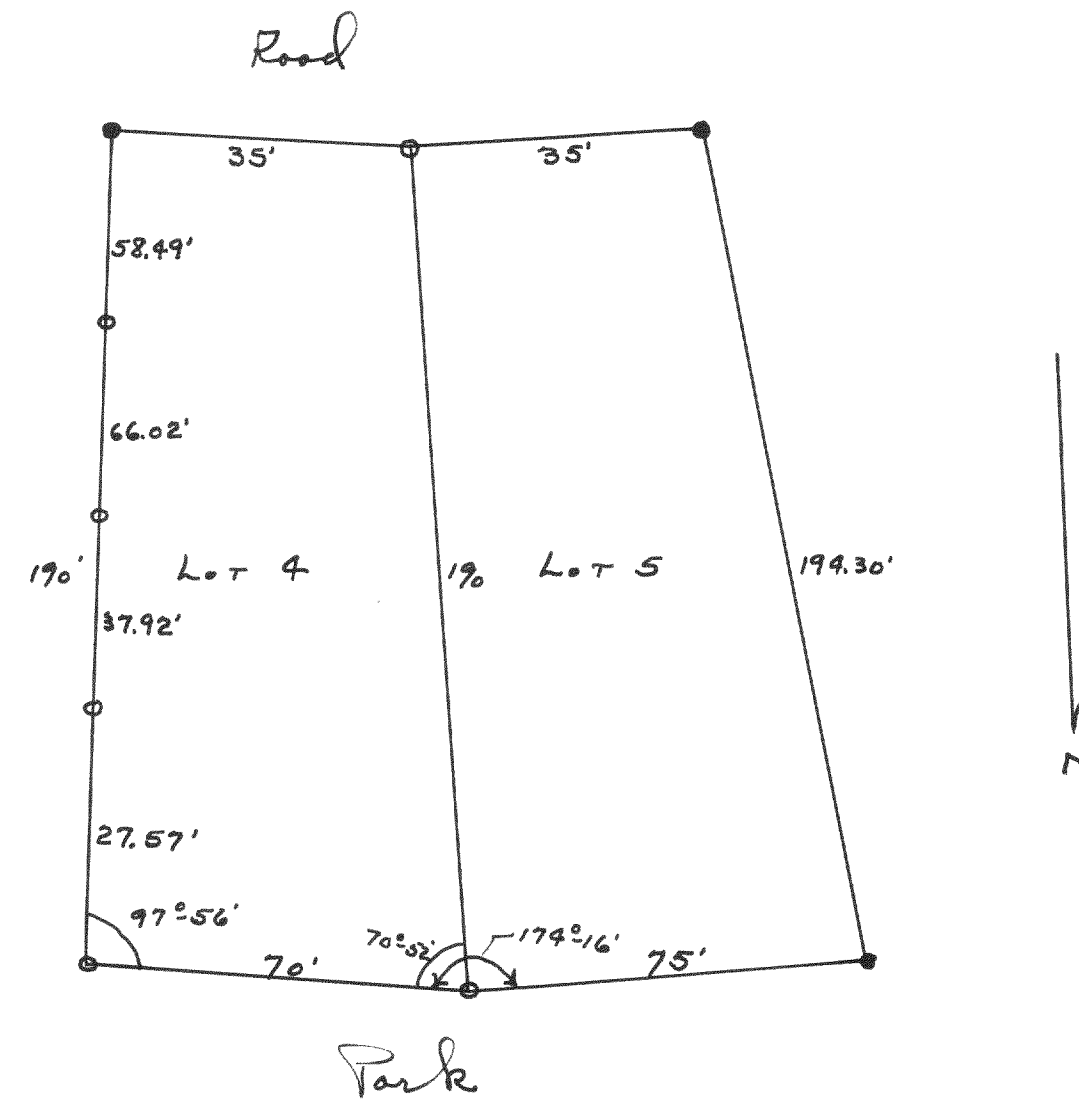

Plot of survey of Lots 4 and 5 of The
First Add. to Cedar Pt. Park Subd.
Williams Bay Wisconsin

Aug. 1943

Lloyd S. Jensen
County Surveyor