


#1422

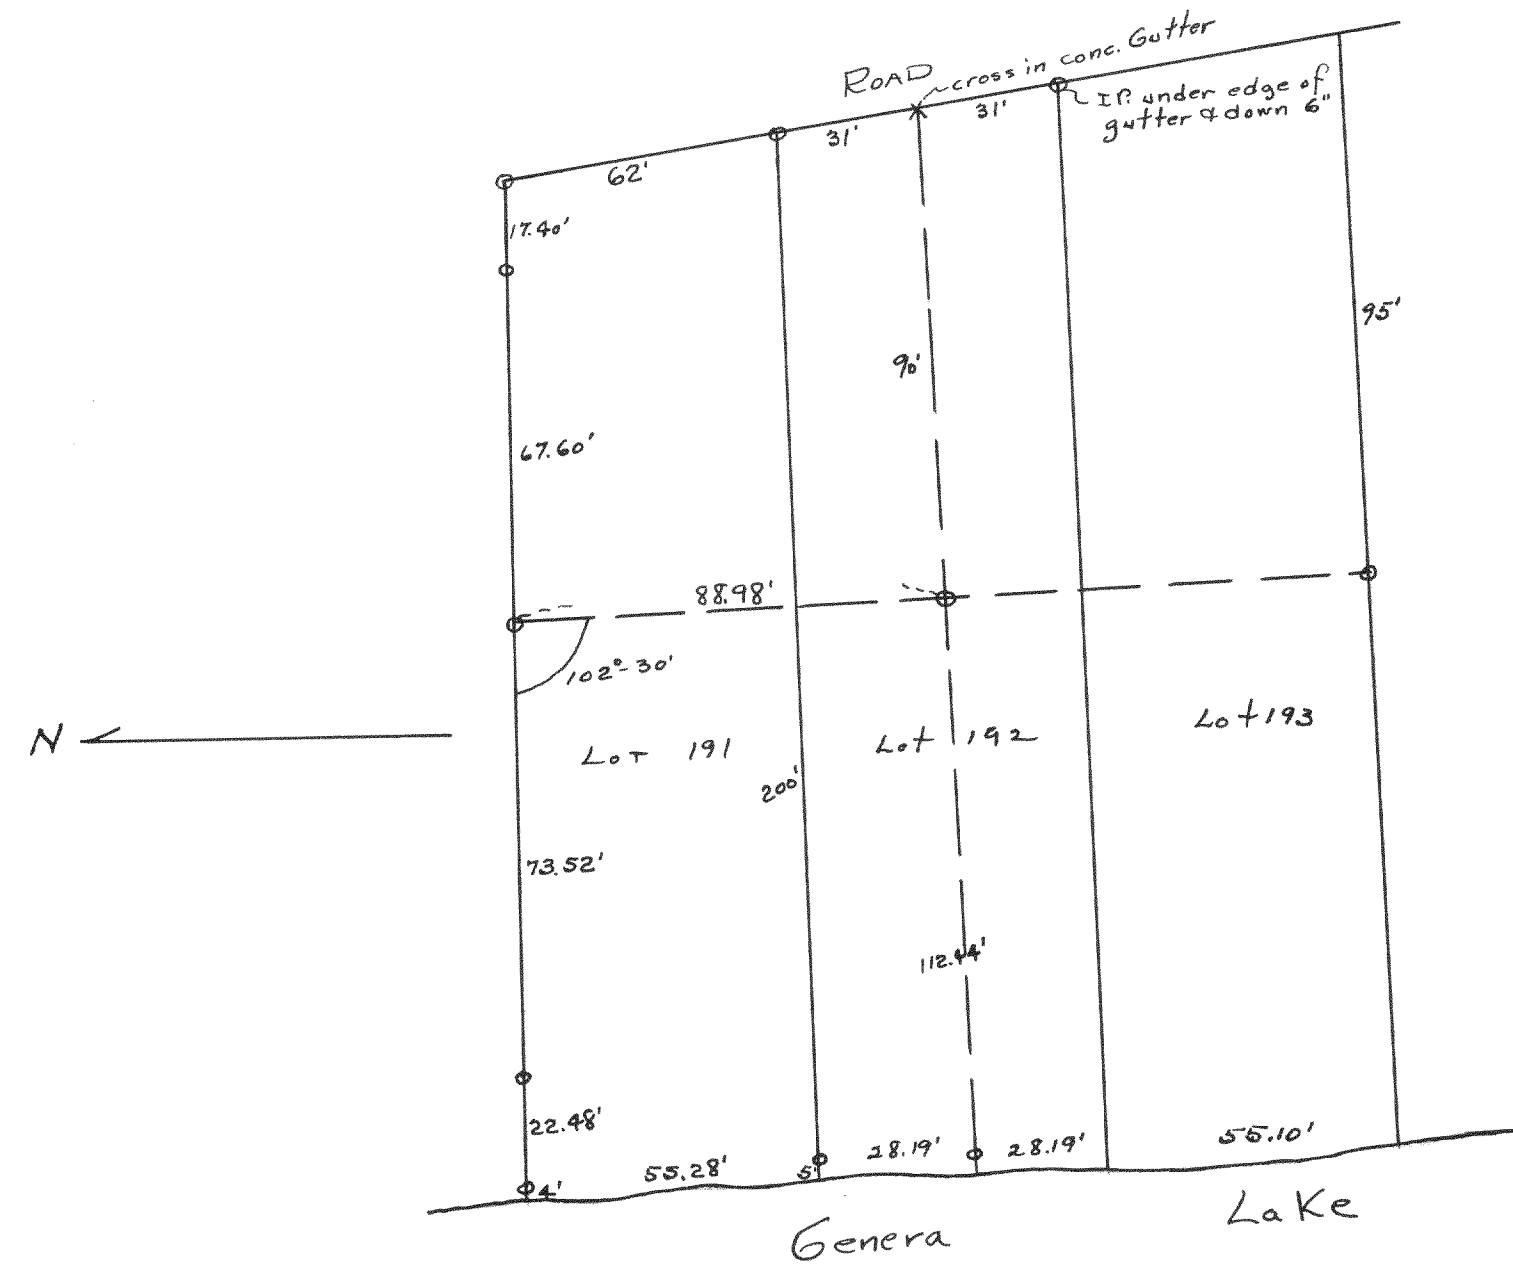


Plot of survey of Lot 191 and the $7\frac{1}{2}$ of Lot 192 of 2nd Add. to Cedar Point Park Subd.

Sept. 1943

Lloyd S. Jensen
County Surveyor

#1423

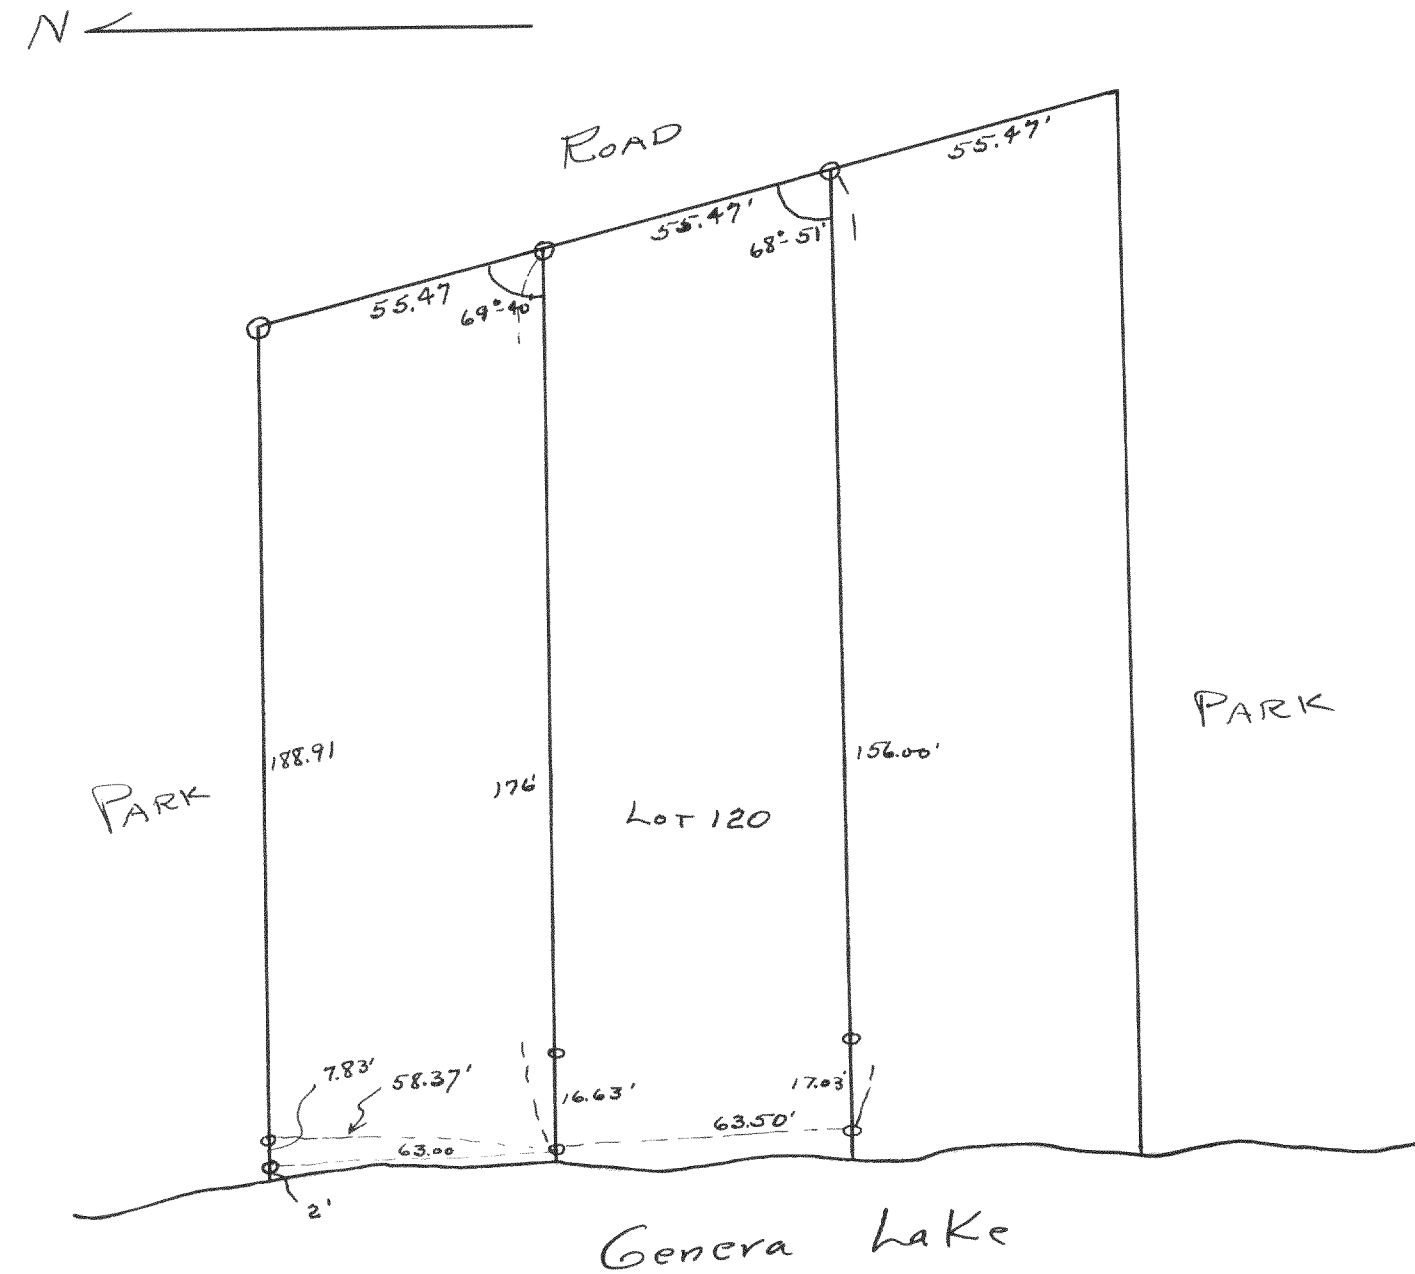

Plot of survey of Lot 120 of 2nd Add. to Cedar Point Park Subd. Williams Bay Wisconsin.

Sept. 1943

Lloyd S. Jensen
County Surveyor