


#1432

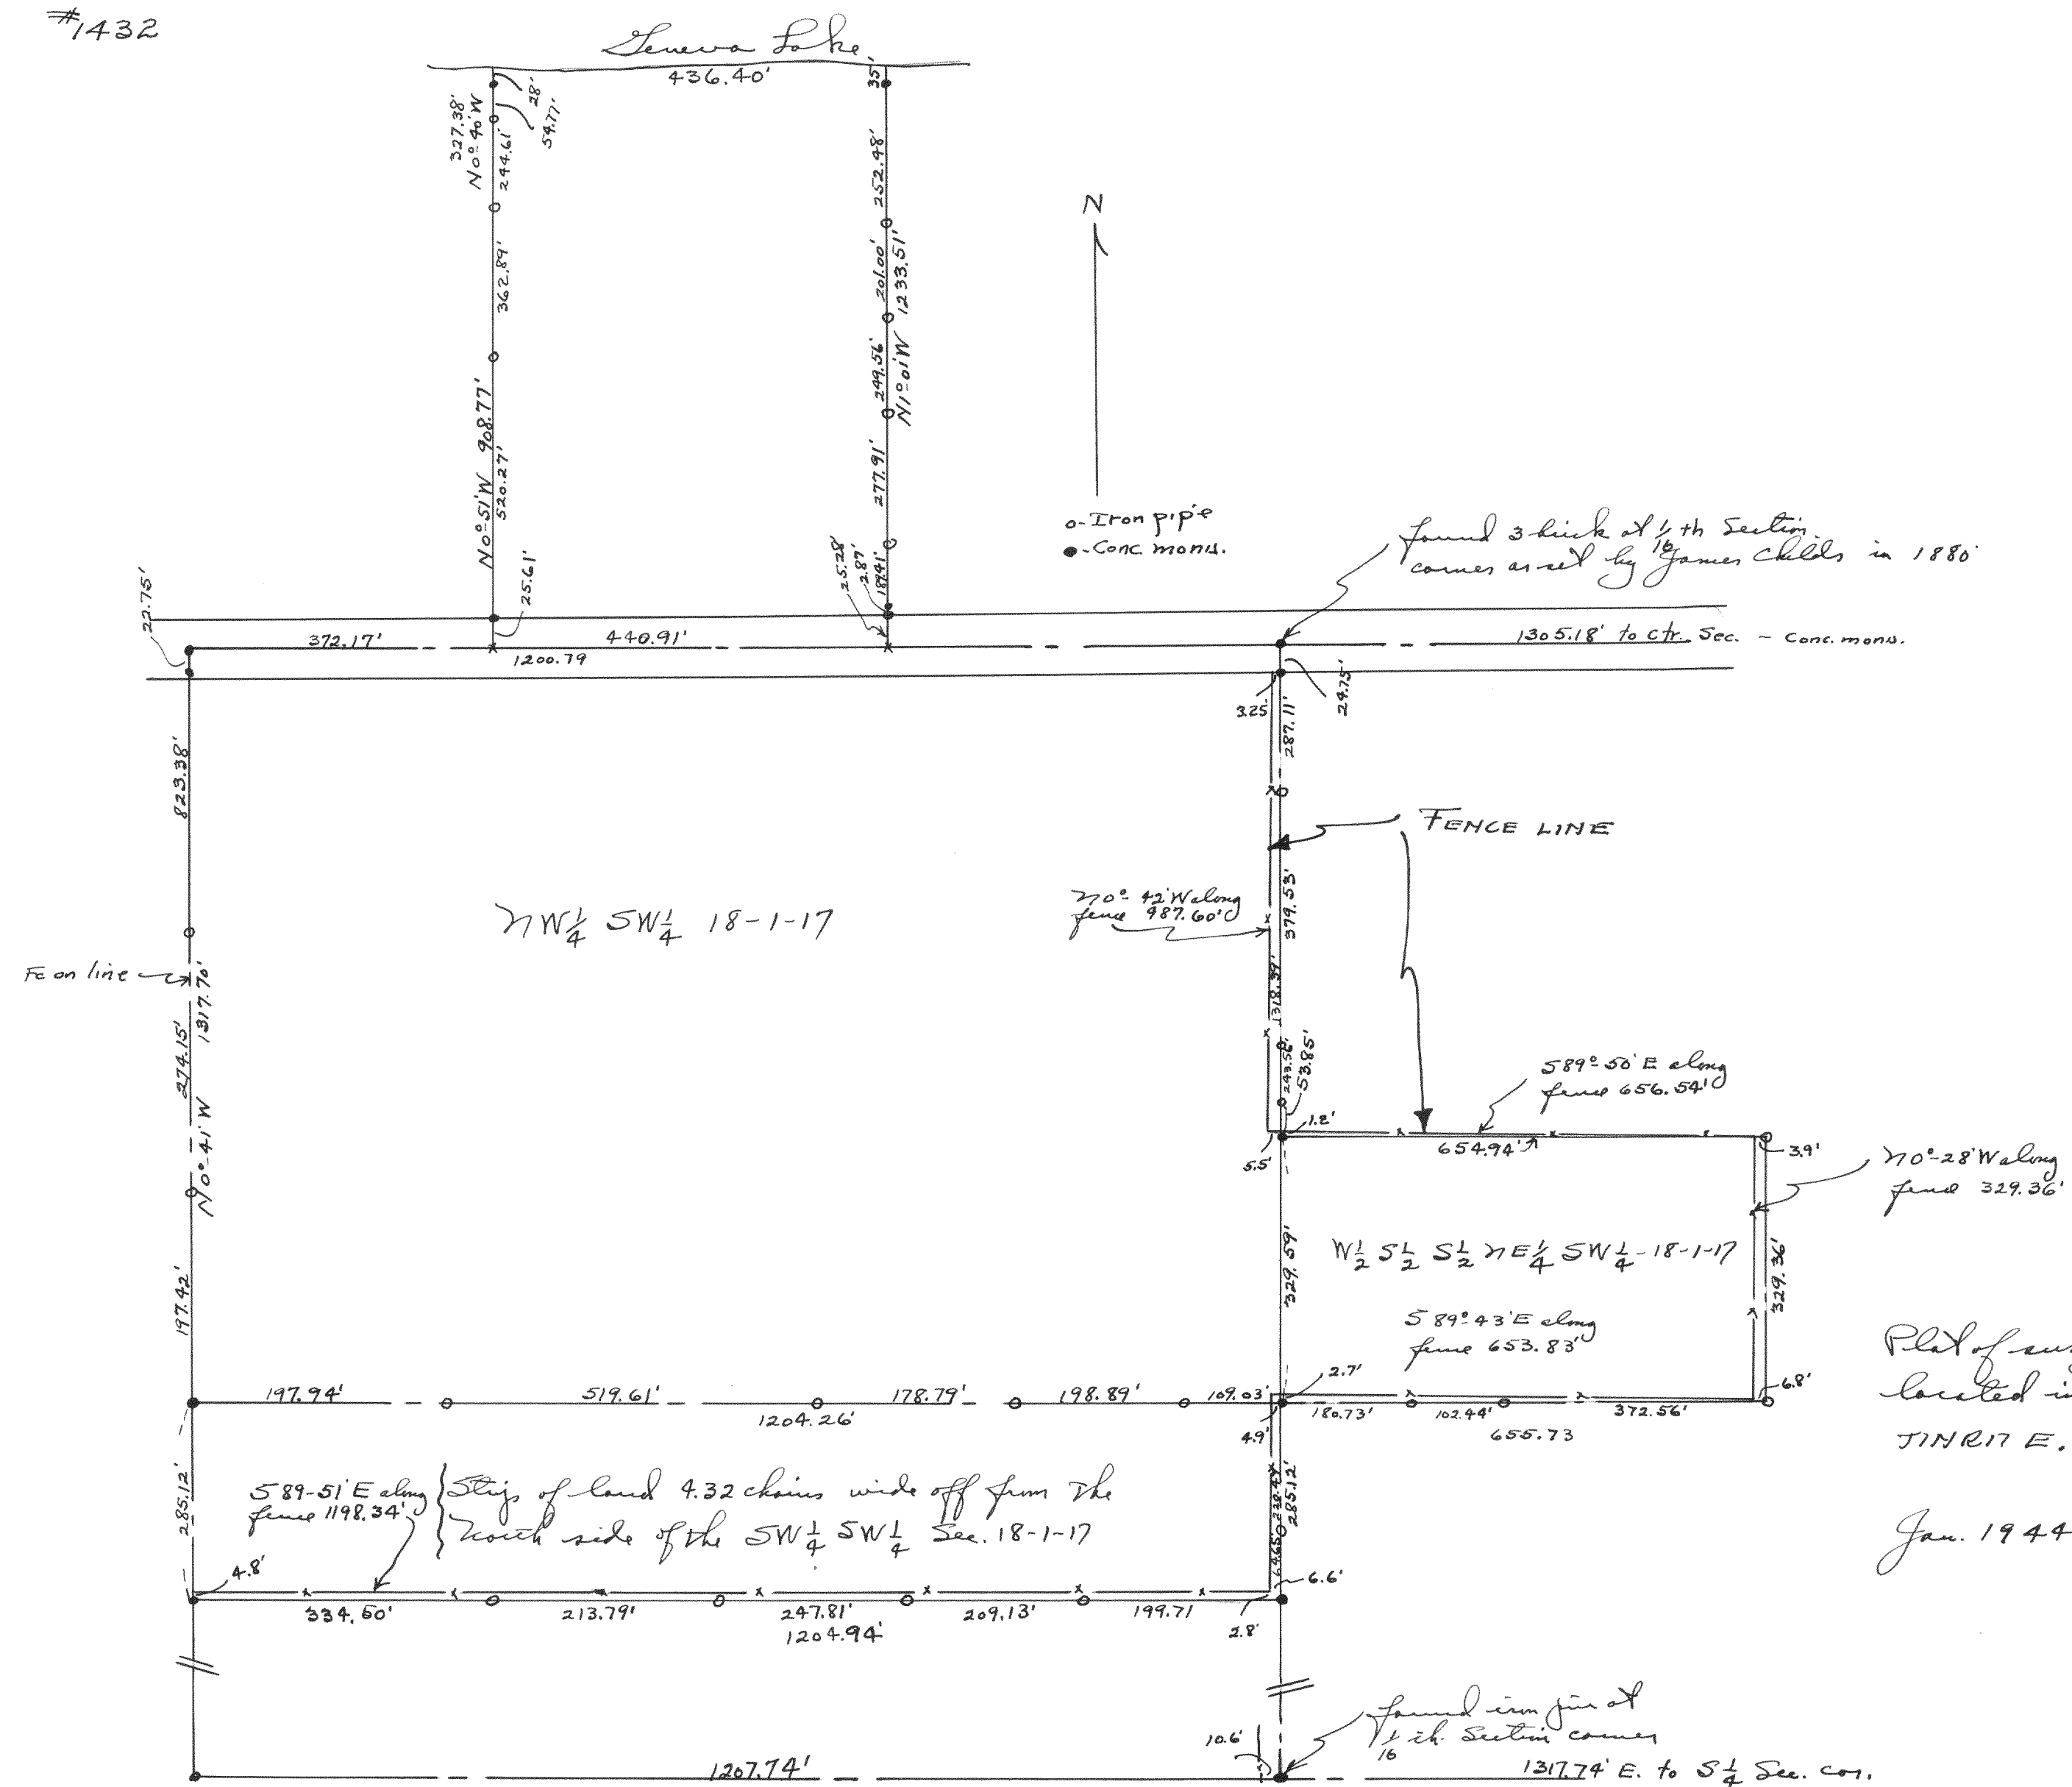

Plot of survey of the Cox Estate
located in Fractional Section 18,
T18N R17E.

Jan. 1944
Lloyd D. Jensen
County Surveyor