


#1435

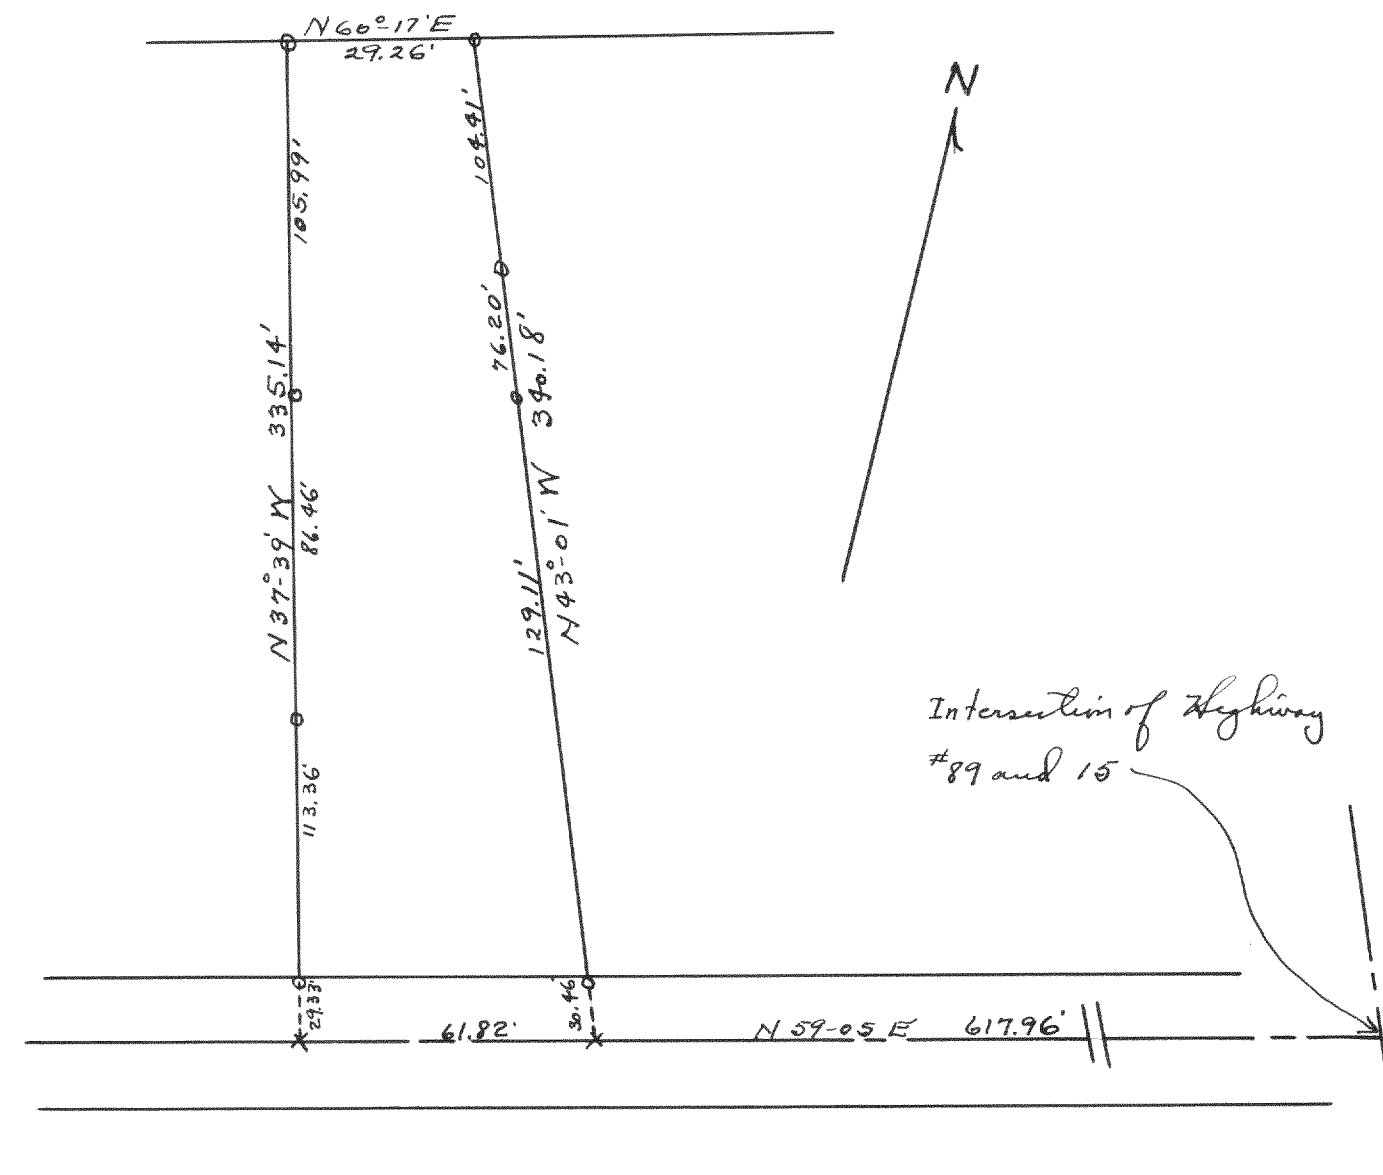


Plat of survey of the Smalls property
in Section (SW $\frac{1}{4}$) 27-2-15.

Nov. 1943

Lloyd S. Jensen
County Surveyor

#1436

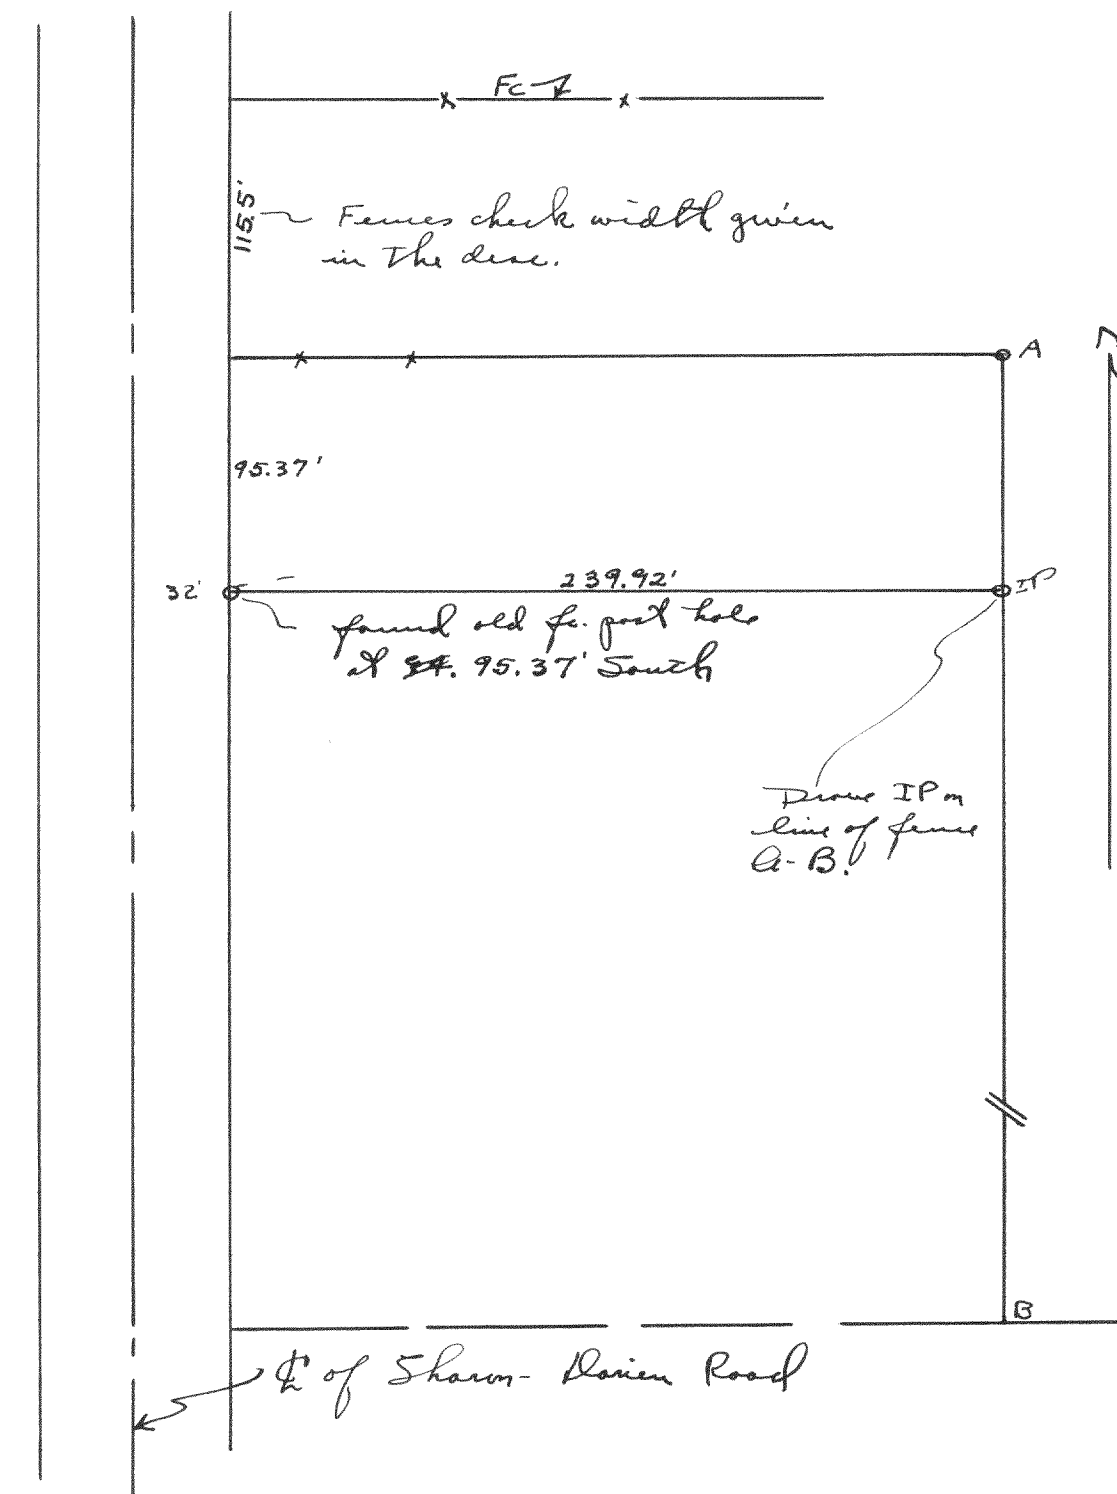

Plat of survey of a parcel of land
in Sec. 27-2-15 for Mr. Bluncomb.

Oct. 1943

Lloyd S. Jensen
County Surveyor