



#1437

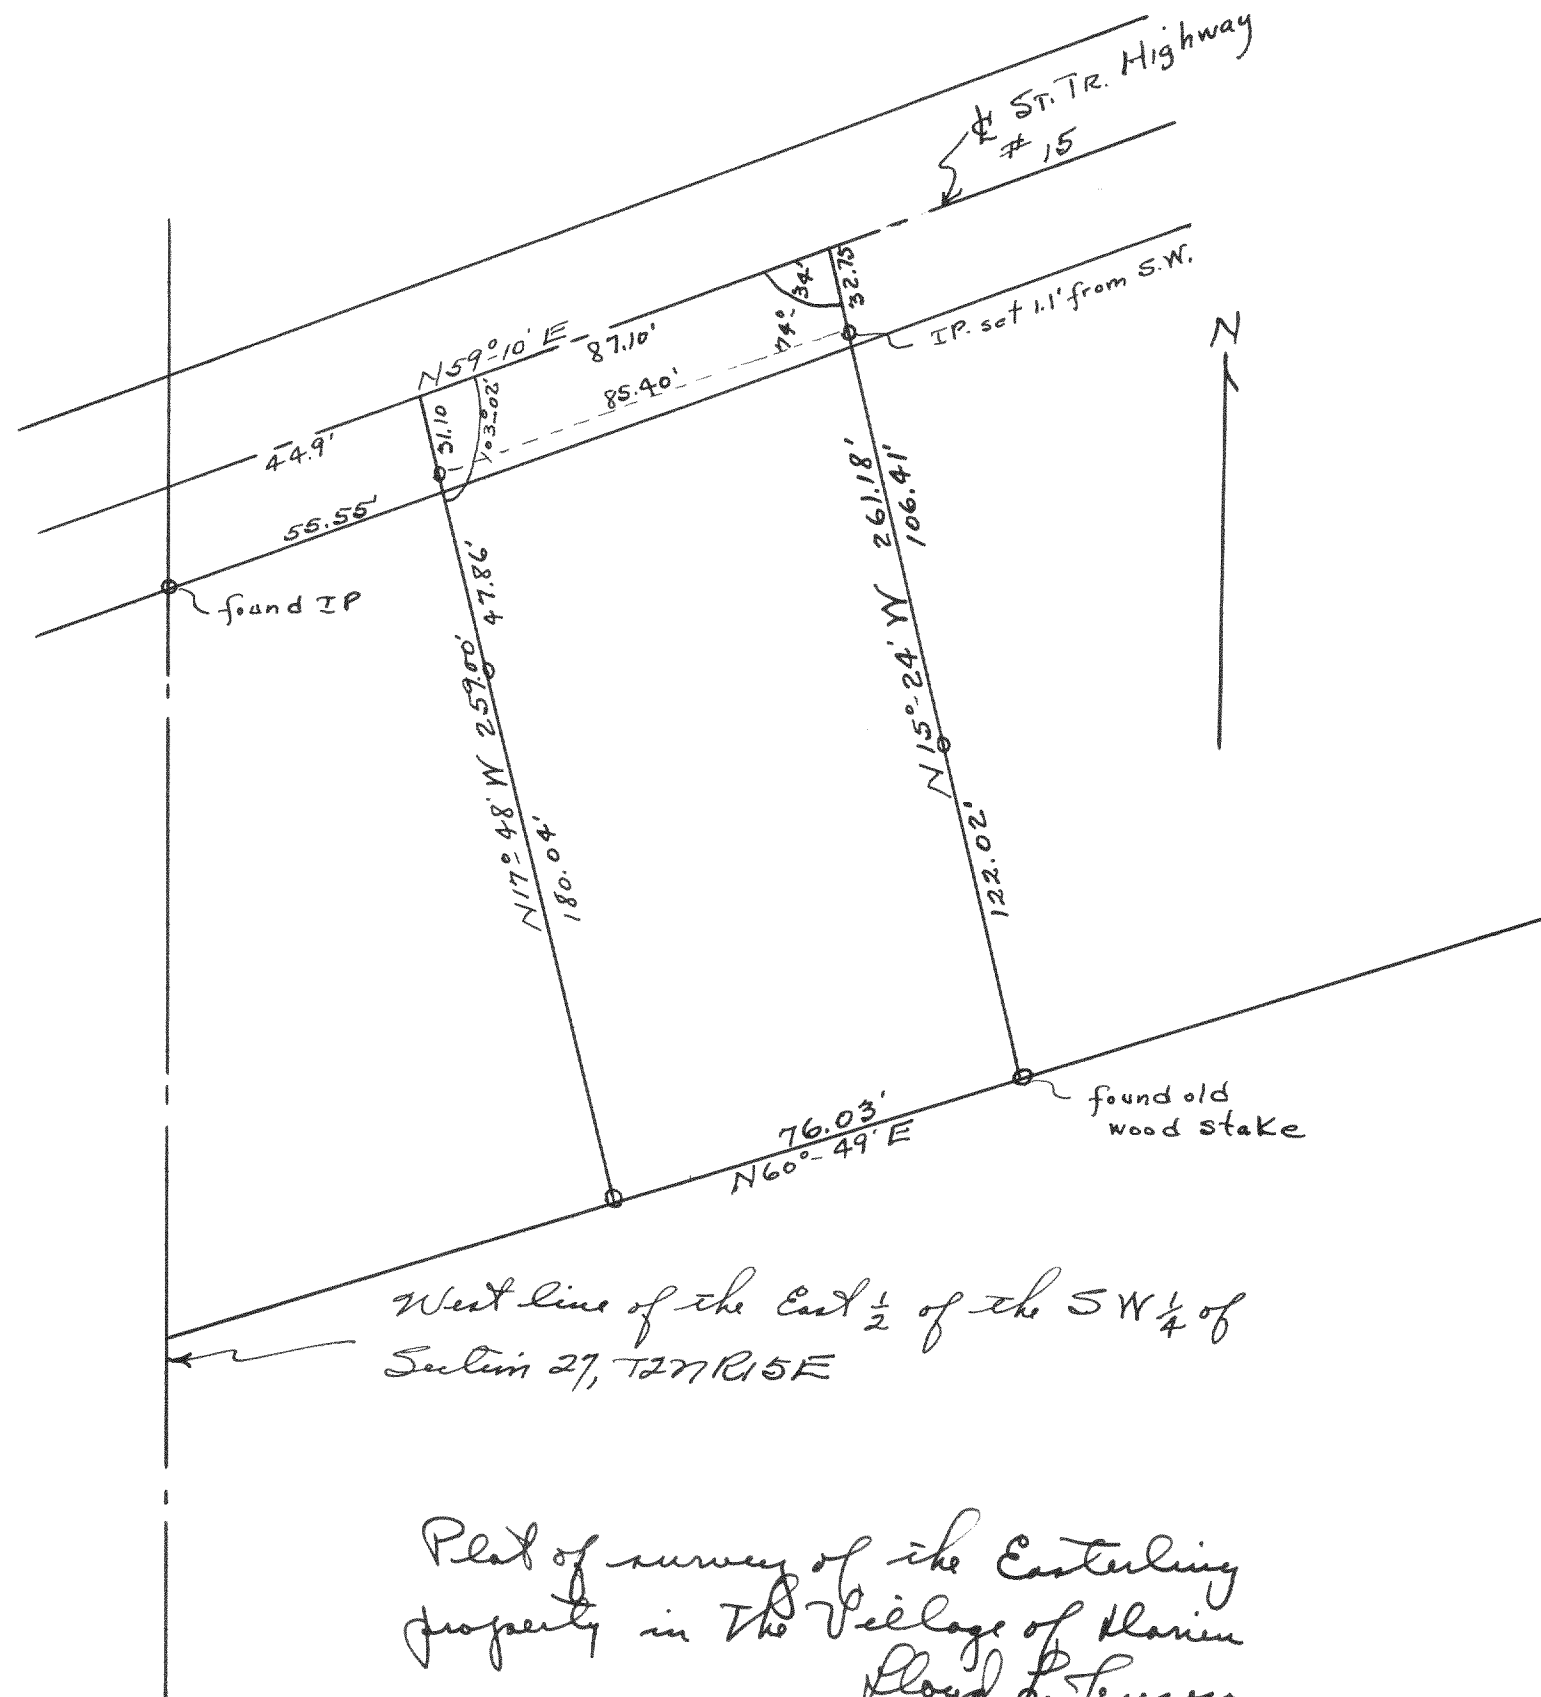

Plot of survey of the Easterling property in the Village of Marion
 Lloyd L. Jensen
 County Surveyor
 Nov. 1943

#1438

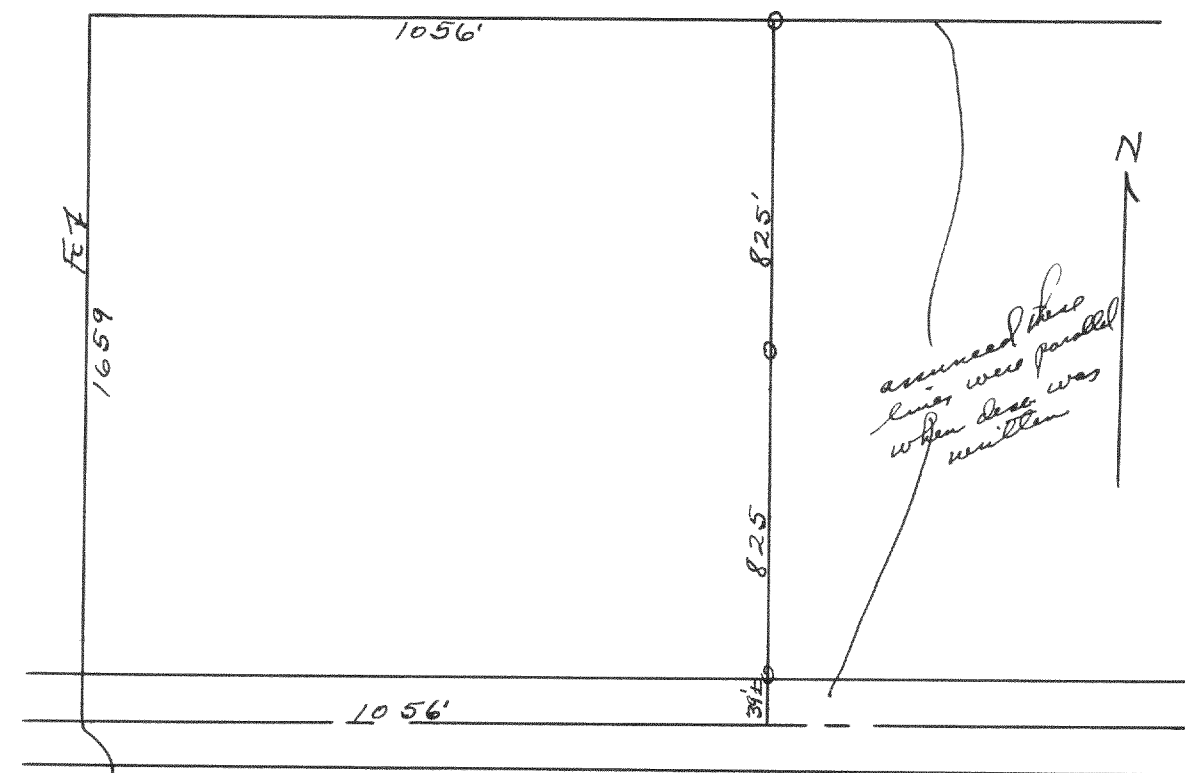

92 Rods E. of the
 West $\frac{1}{4}$ Sec. cor.
 of Sec. 10-2-17

Plot of fence line survey of a 40 acre
 parcel of land in Section 10-2-17

Nov. 1943

Lloyd L. Jensen
 County Surveyor