



#1439

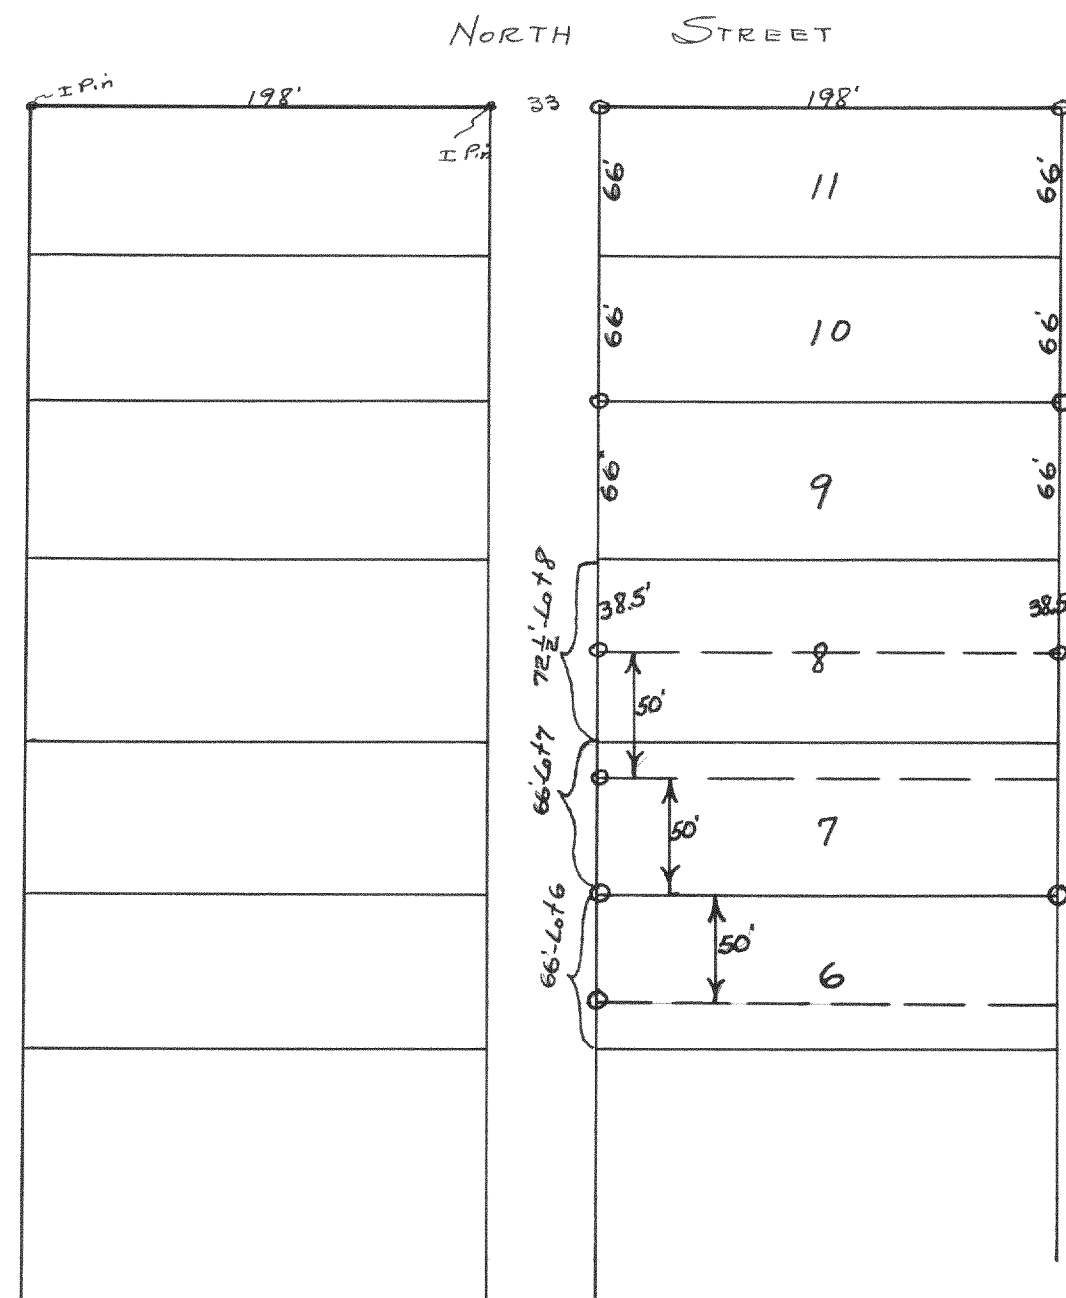

Nov. 1943

Lloyd L. Jensen
County Surveyor

#1440

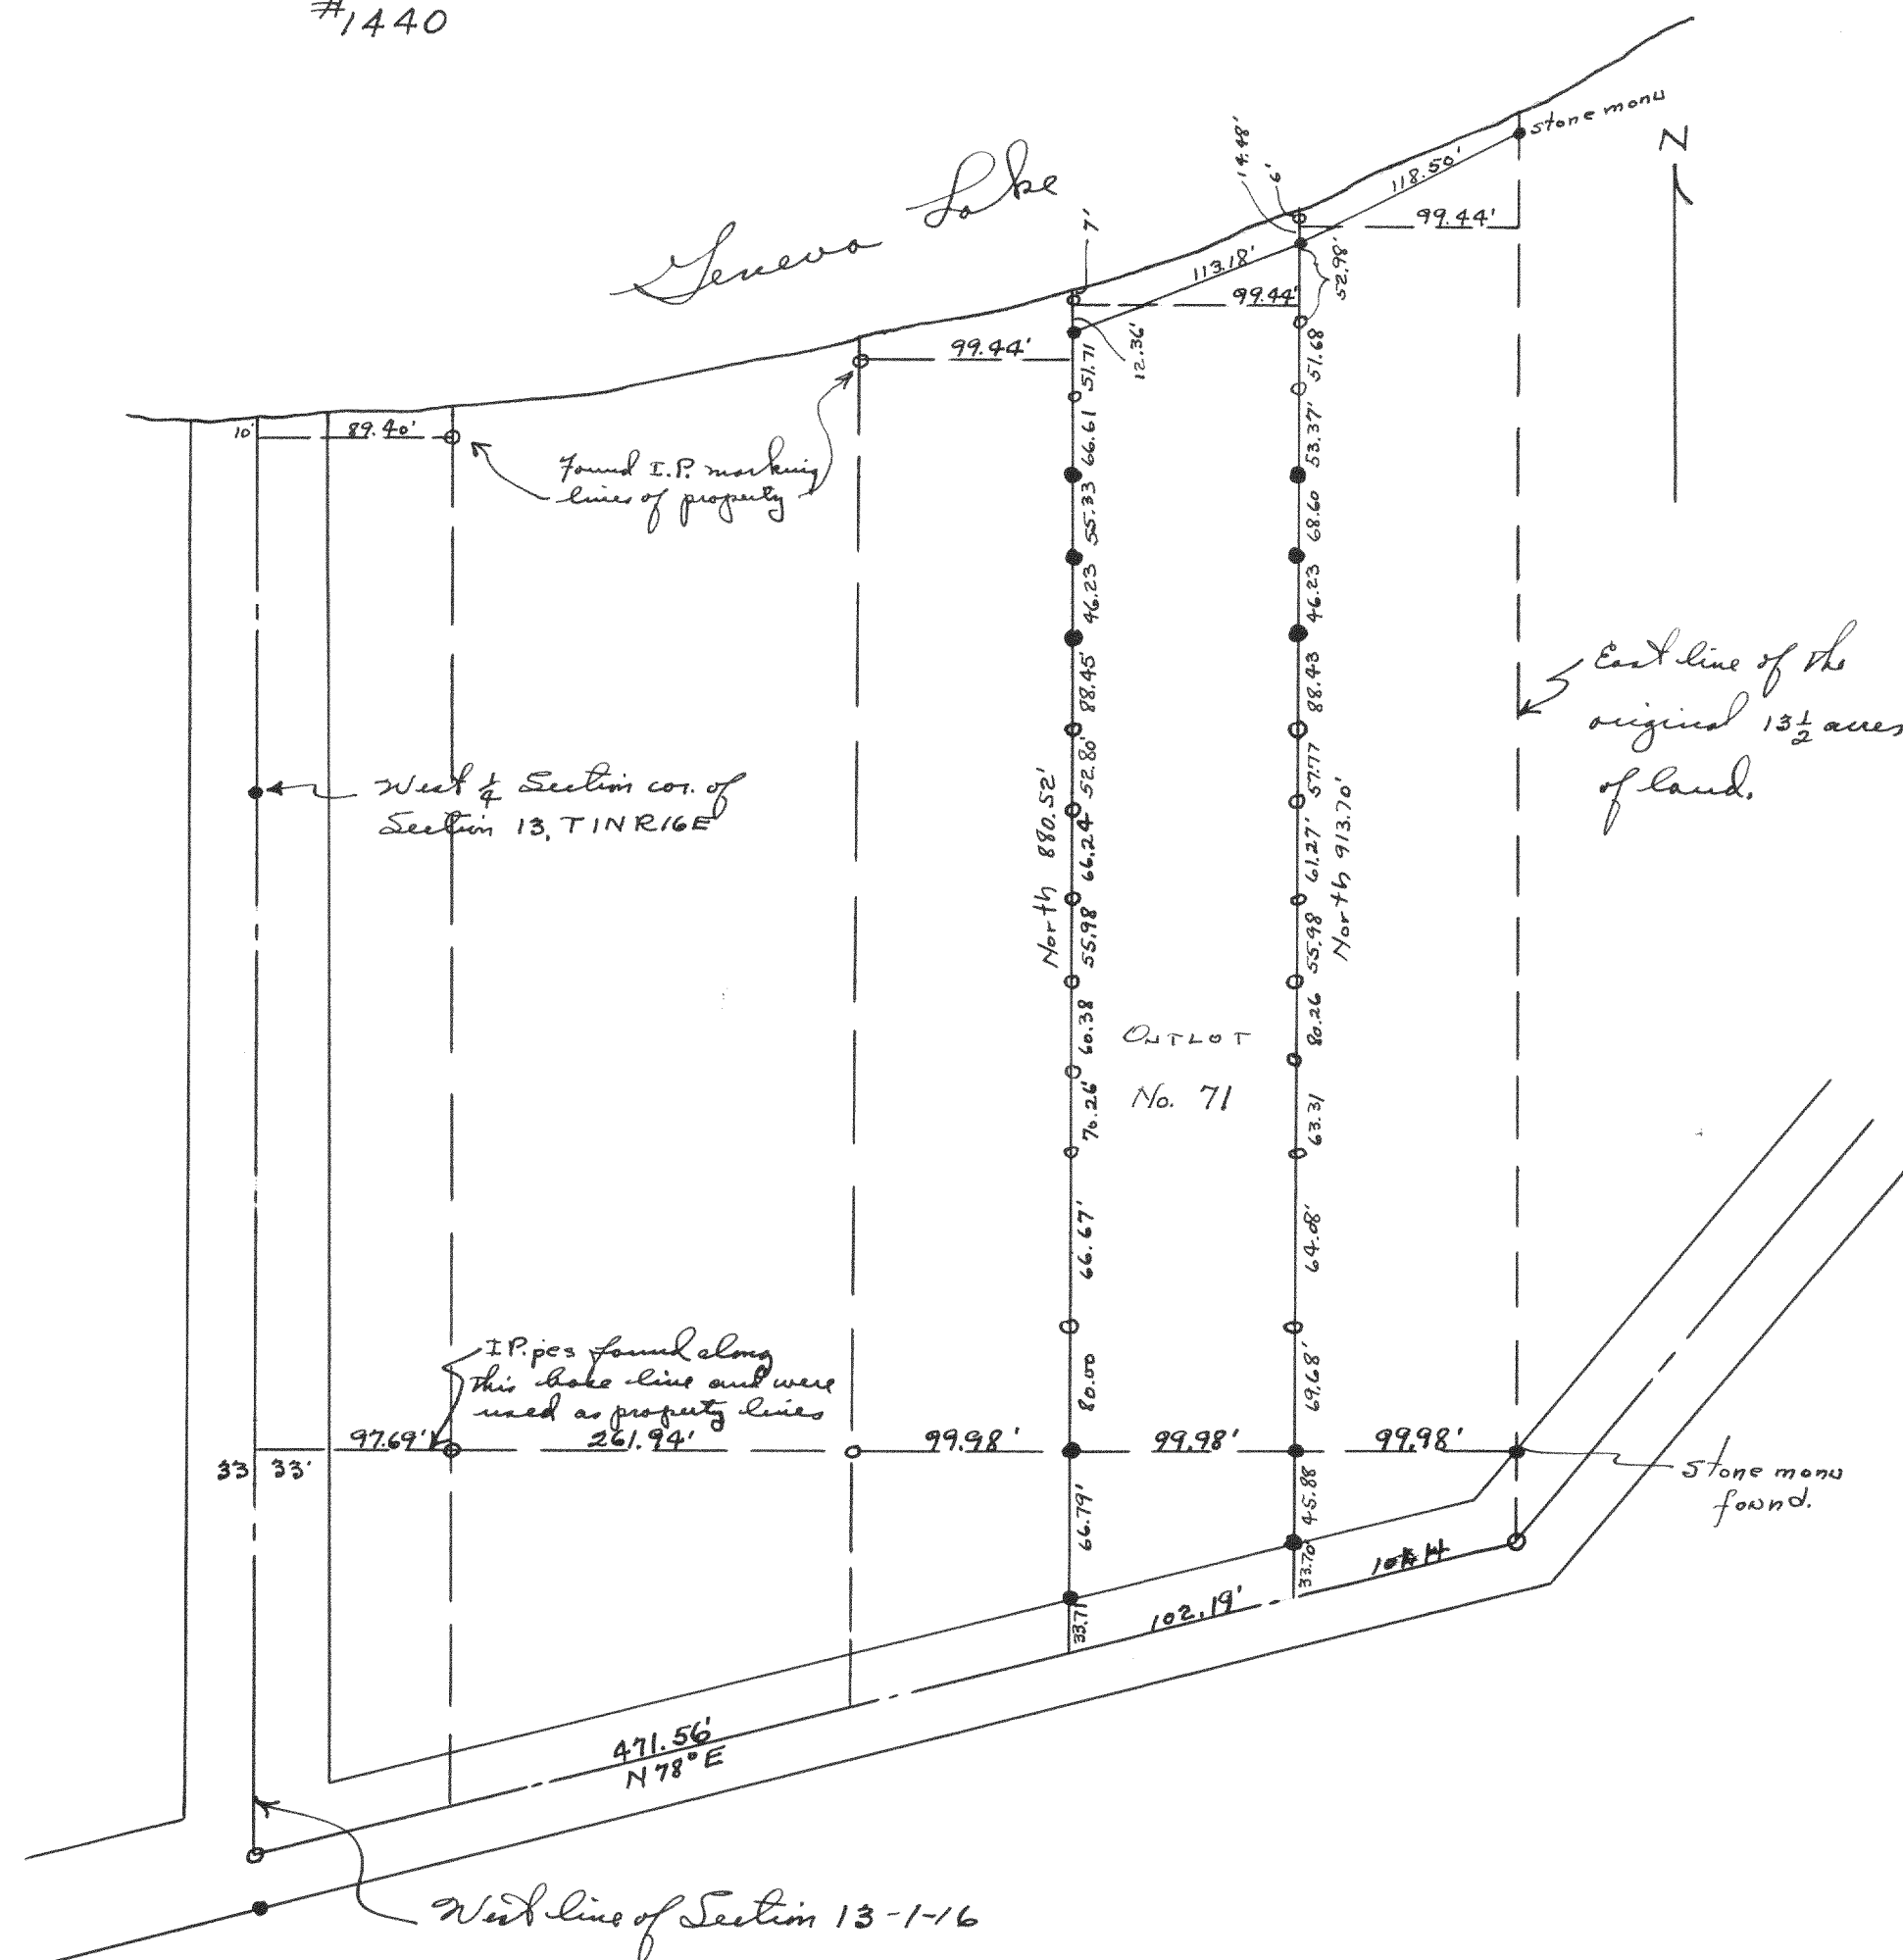

Sept. 1943

Lloyd L. Jensen
County Surveyor