


#1448

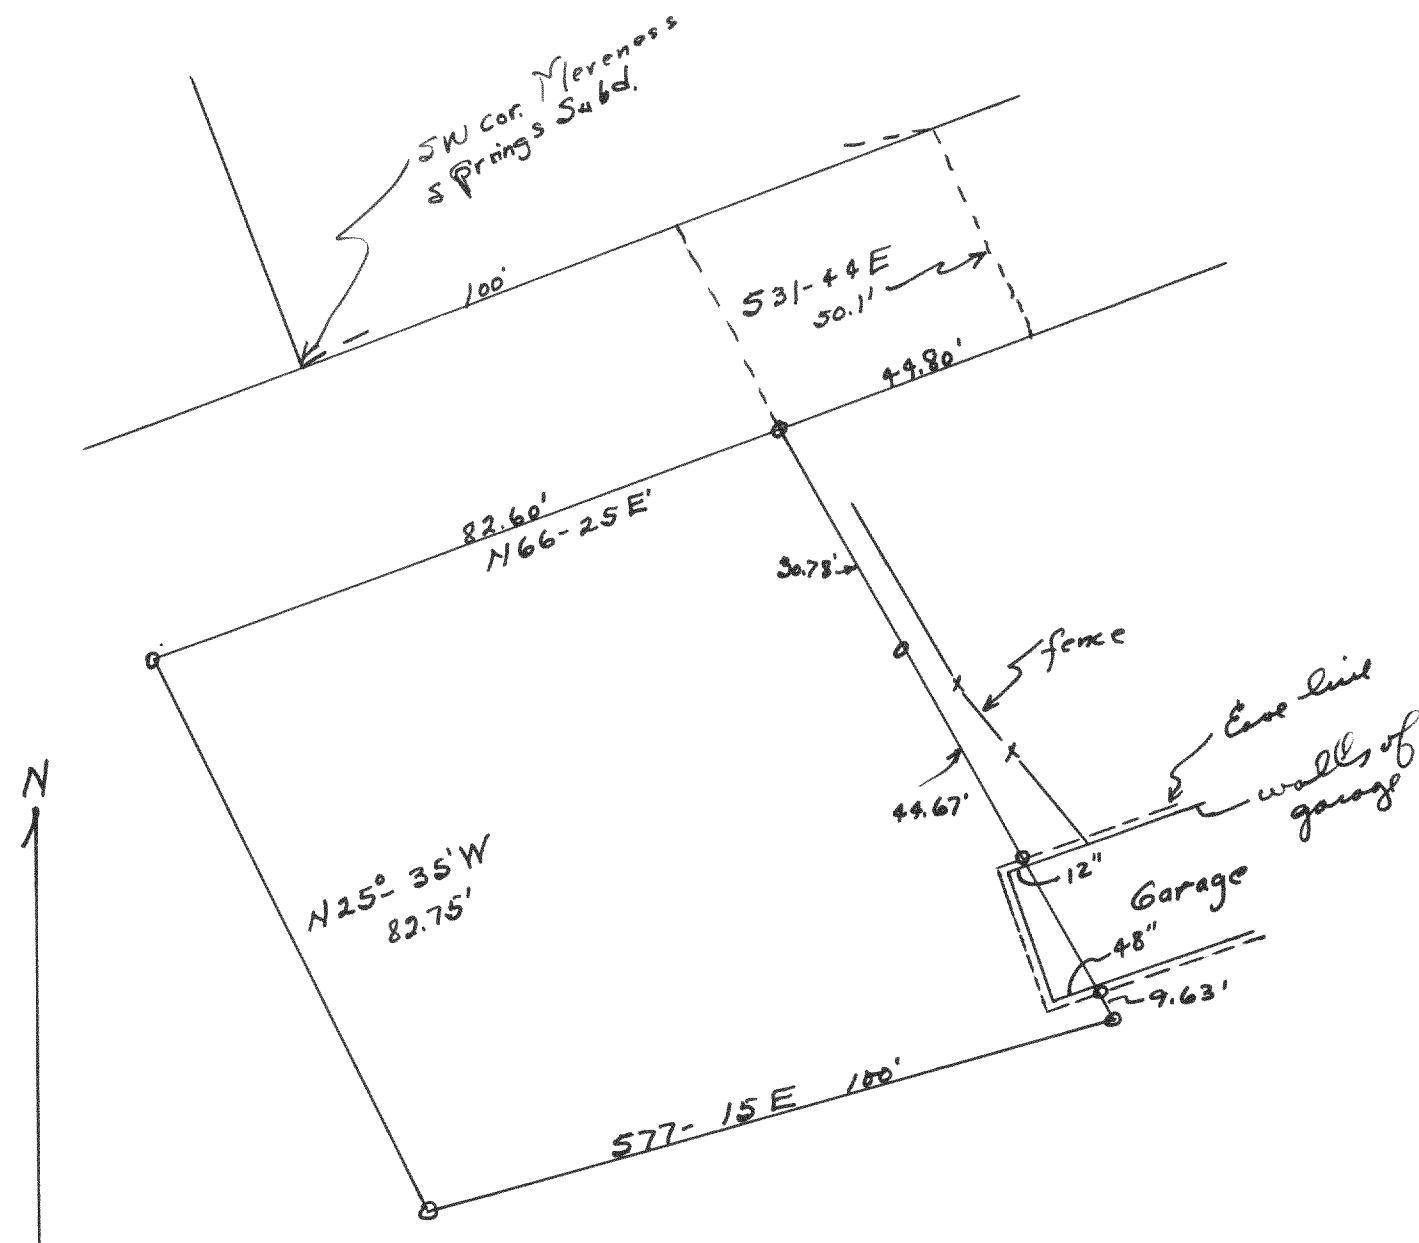


Plot of a survey of the Anna Johnson property at Delavan Park to show the location of the fence and Garage on the southeasterly line of the property.

Sept. 23, 1944

Lloyd L. Jensen
County Surveyor

#1449

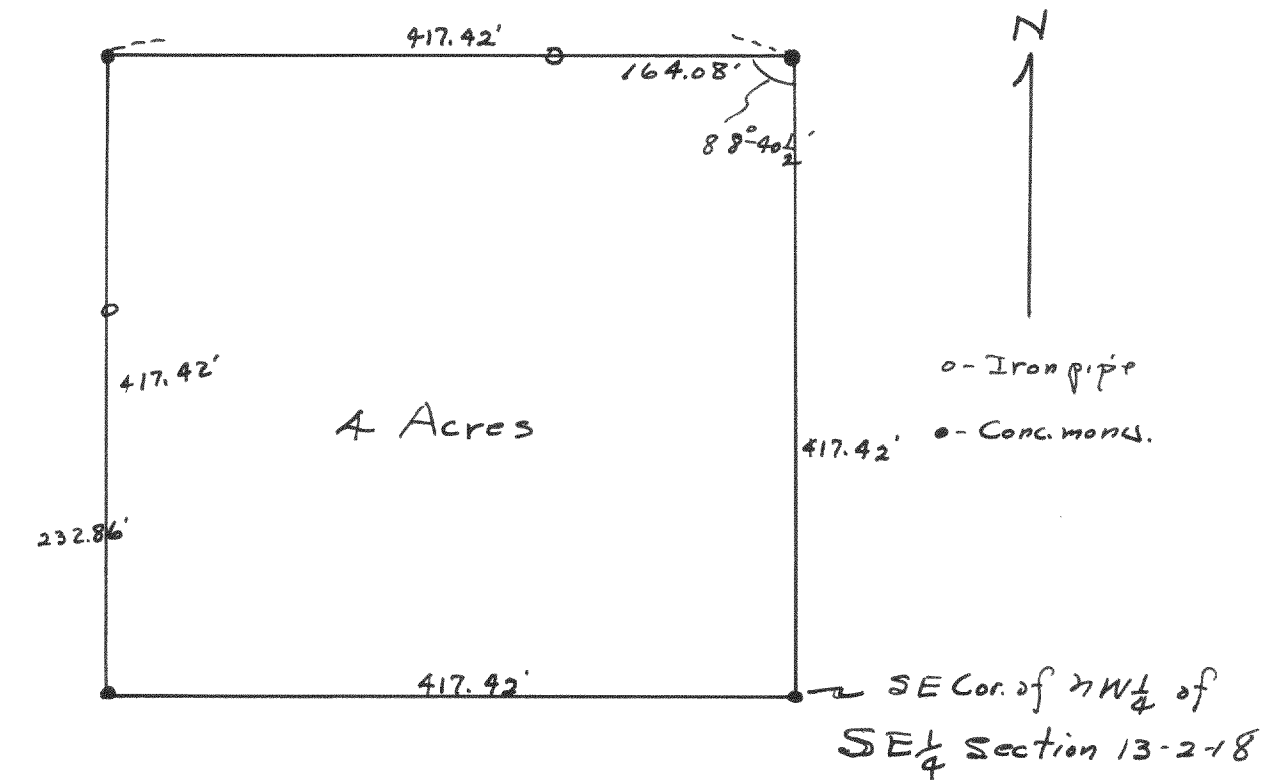

Plot of a fence line survey of 4 acres in the NW 1/4 of SE 1/4 of Section 13 - 2 - 18

Sept. 1944

Lloyd L. Jensen
County Surveyor