


#1451

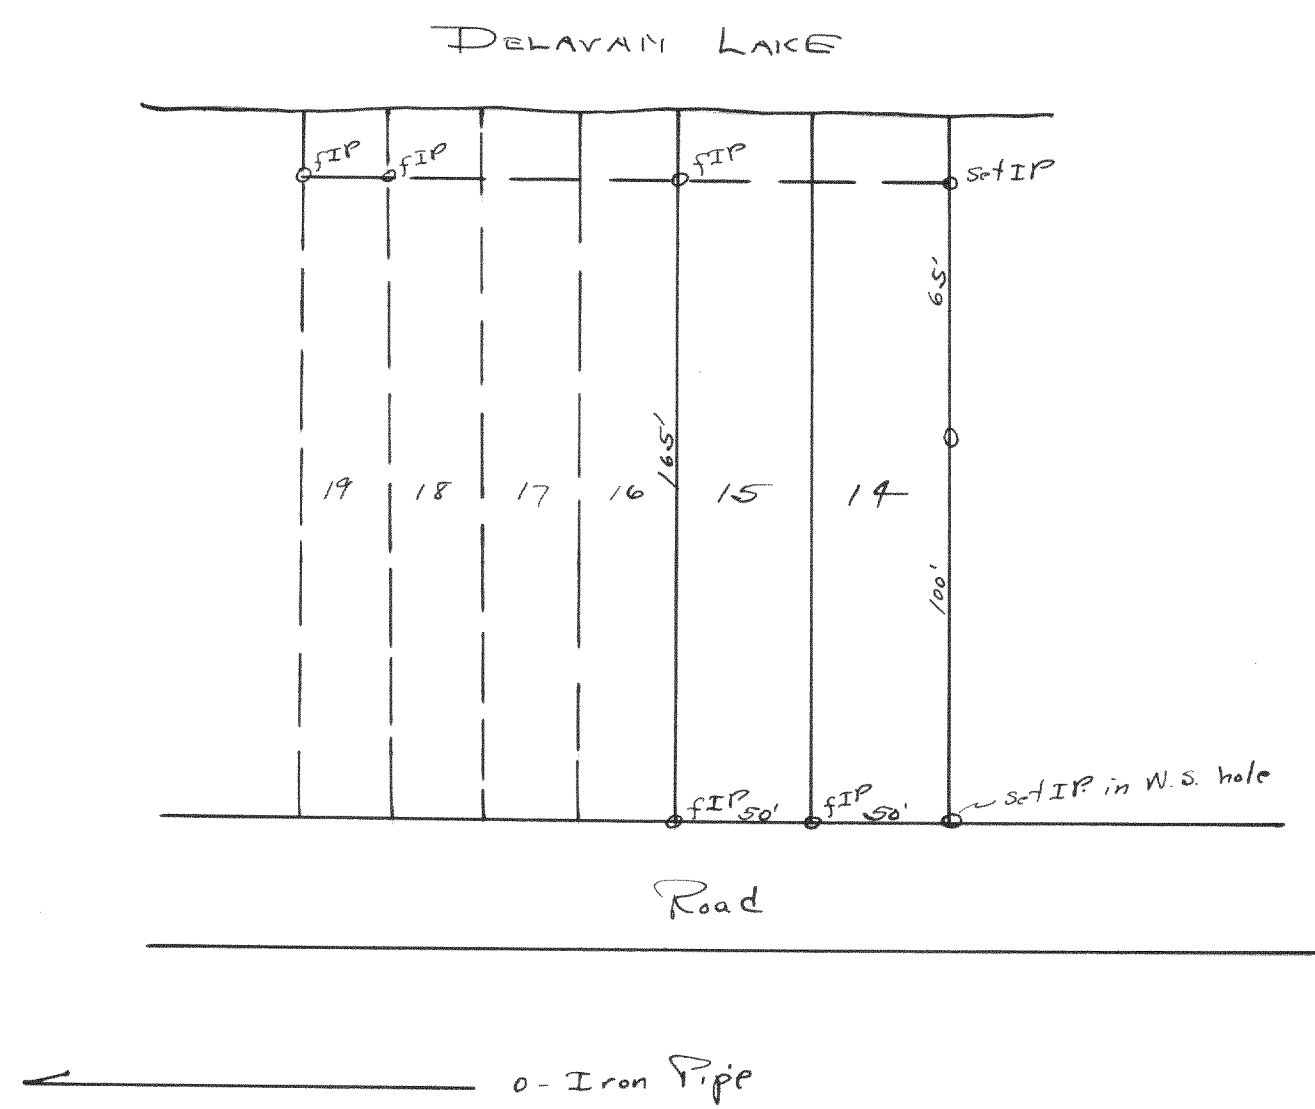


Plot of survey Lts 14 & 15 of Bk. 1 of
dualt Cocks Sub in 2-16.

Sept. 1944

Floyd L. Jensen
County Surveyor

#1452

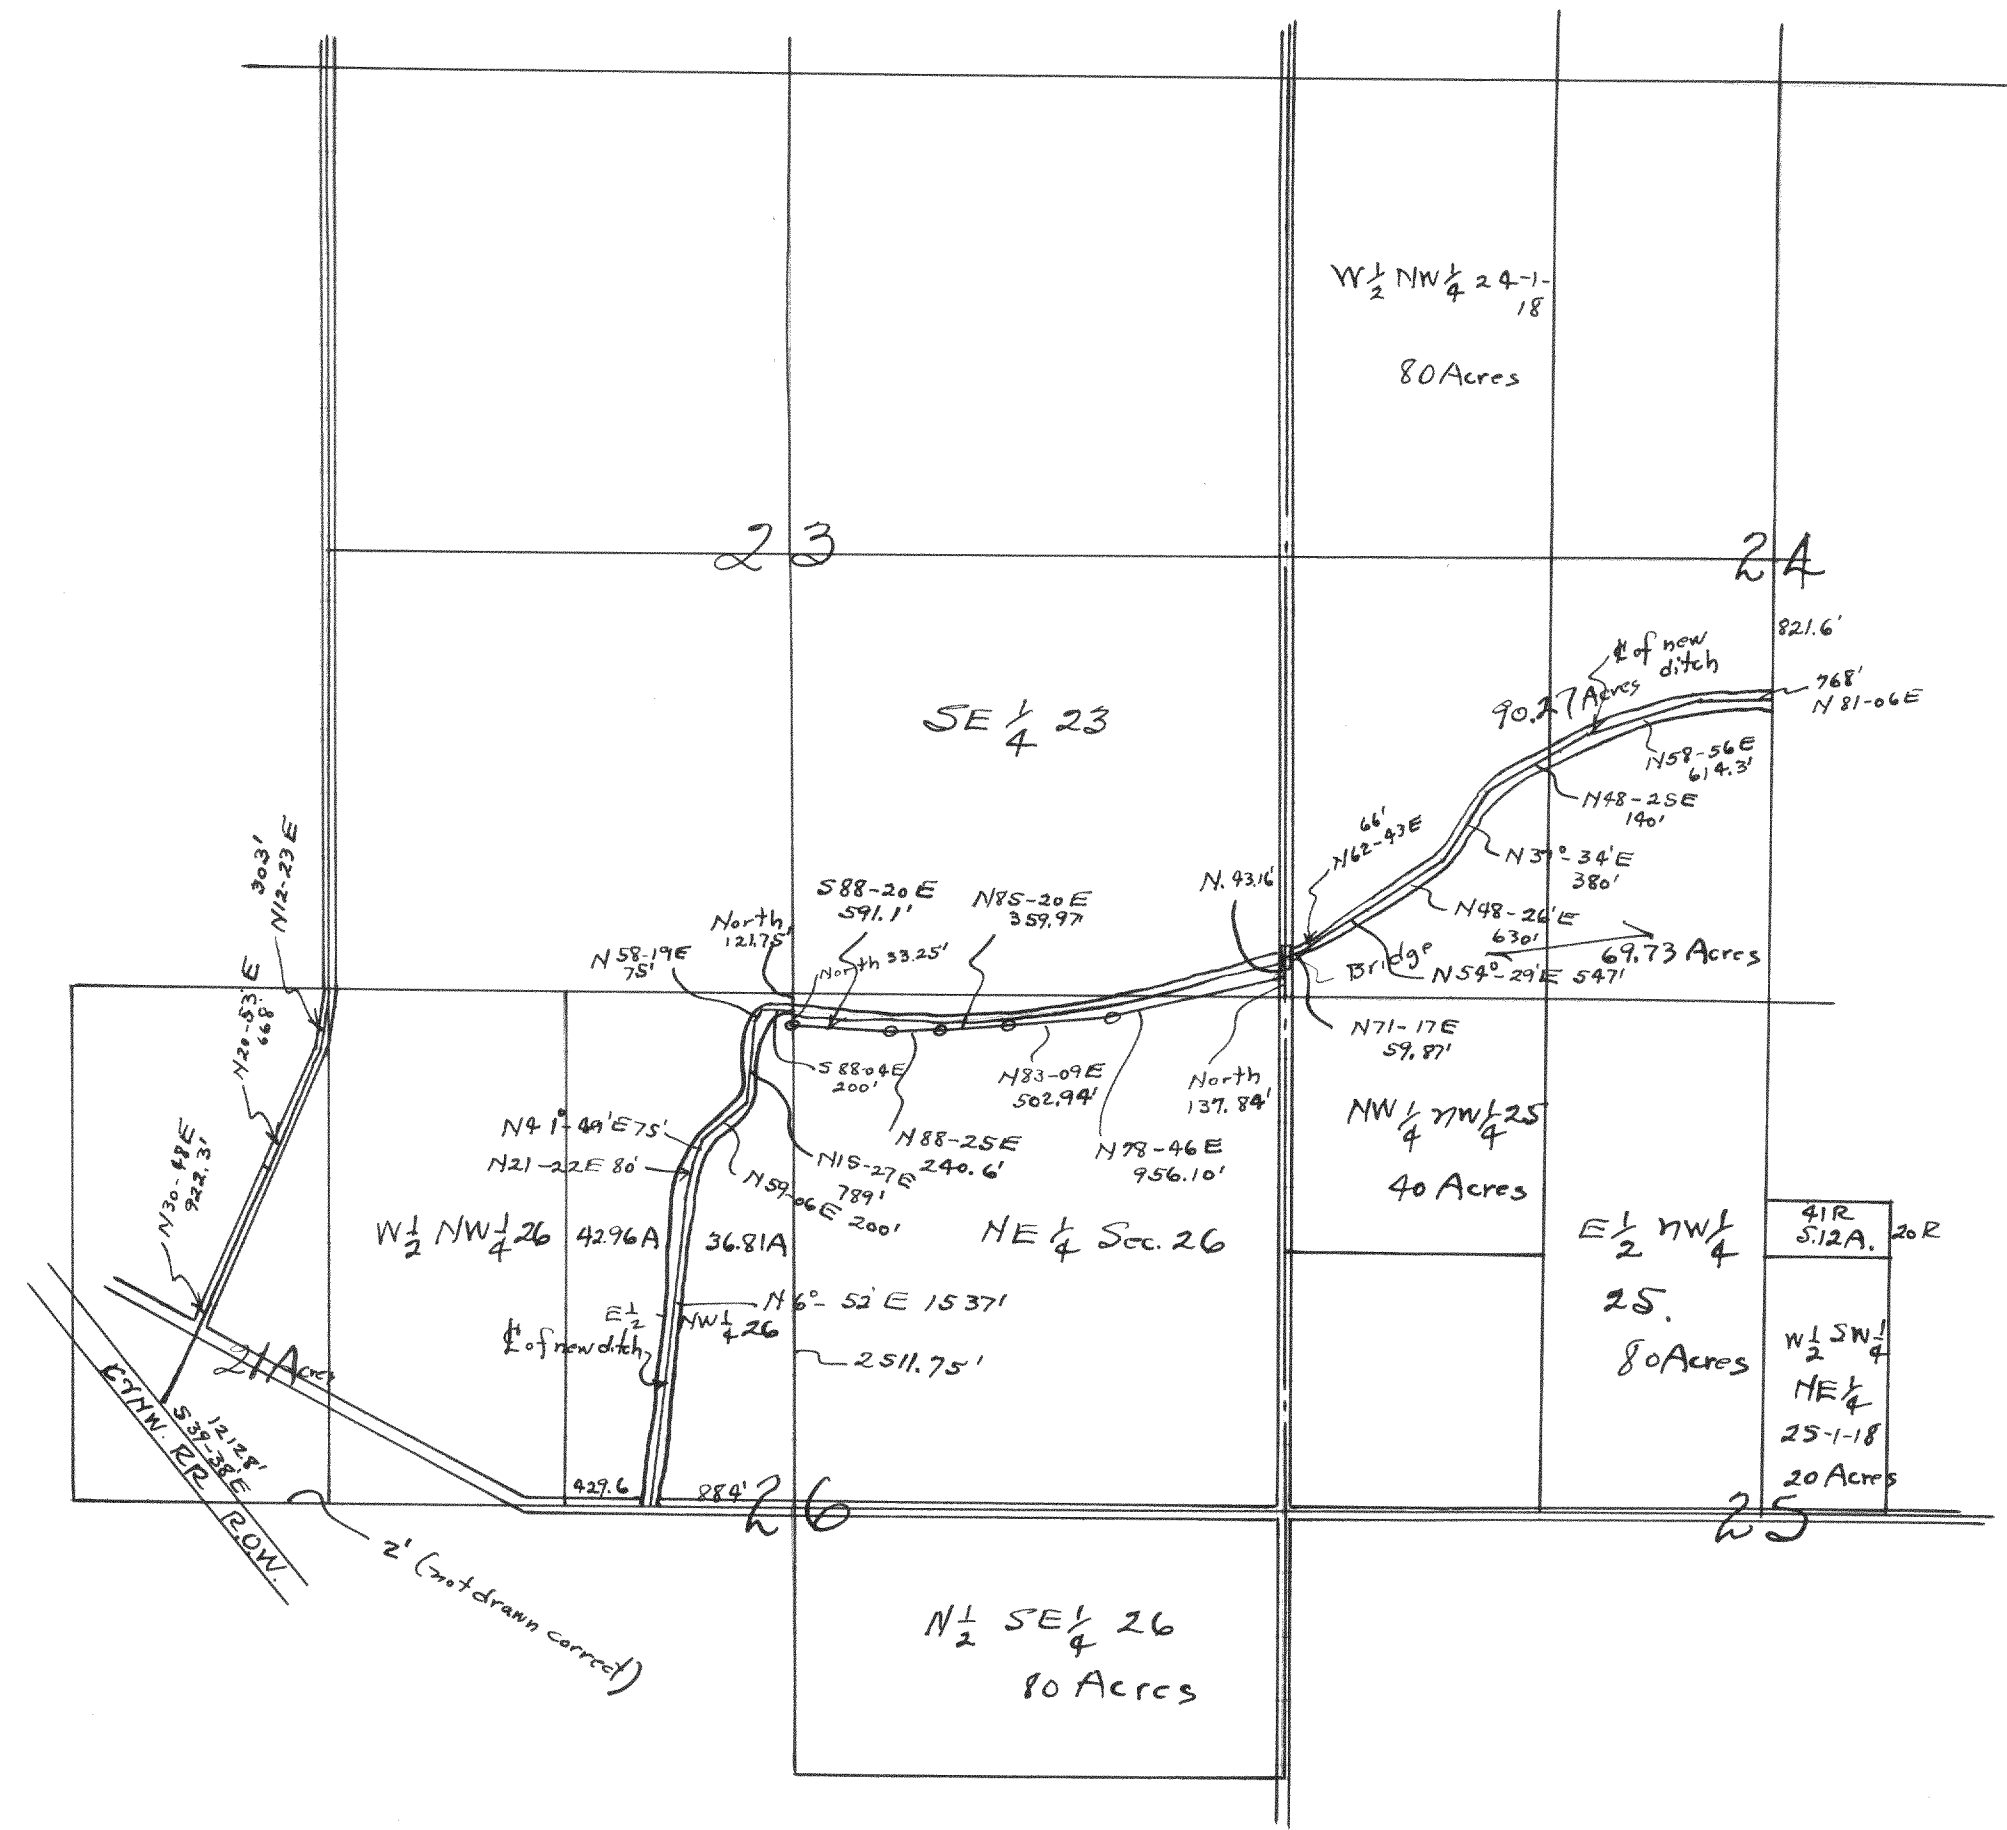

Plot of survey of new drainage ditch
through the Hupfink Farms in Sections
23, 24, 25, 26 and 27, TIN RIBE

Oct. 1944

Floyd L. Jensen
County Surveyor