


#1453

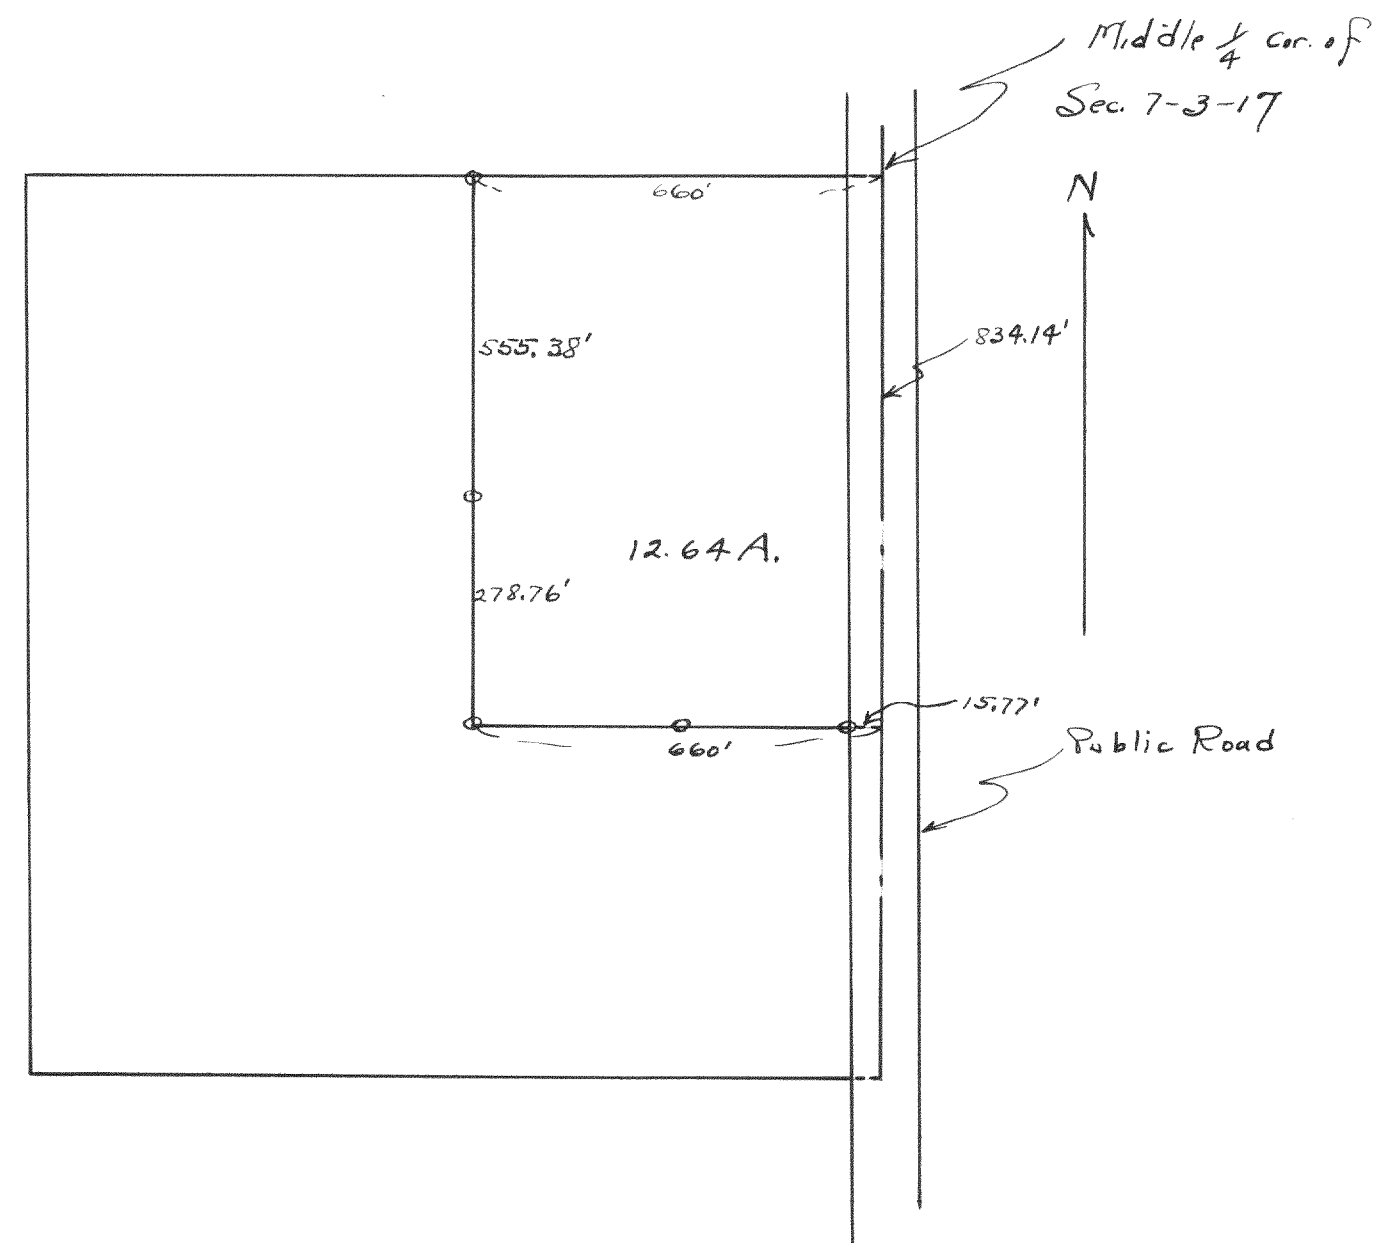


Plat of survey of part of the NE 1/4
of the Southwest 1/4 of Section 7, T37N R17E
fence line survey.

Oct. 1944

Lloyd L. Jensen
County Surveyor

#1454

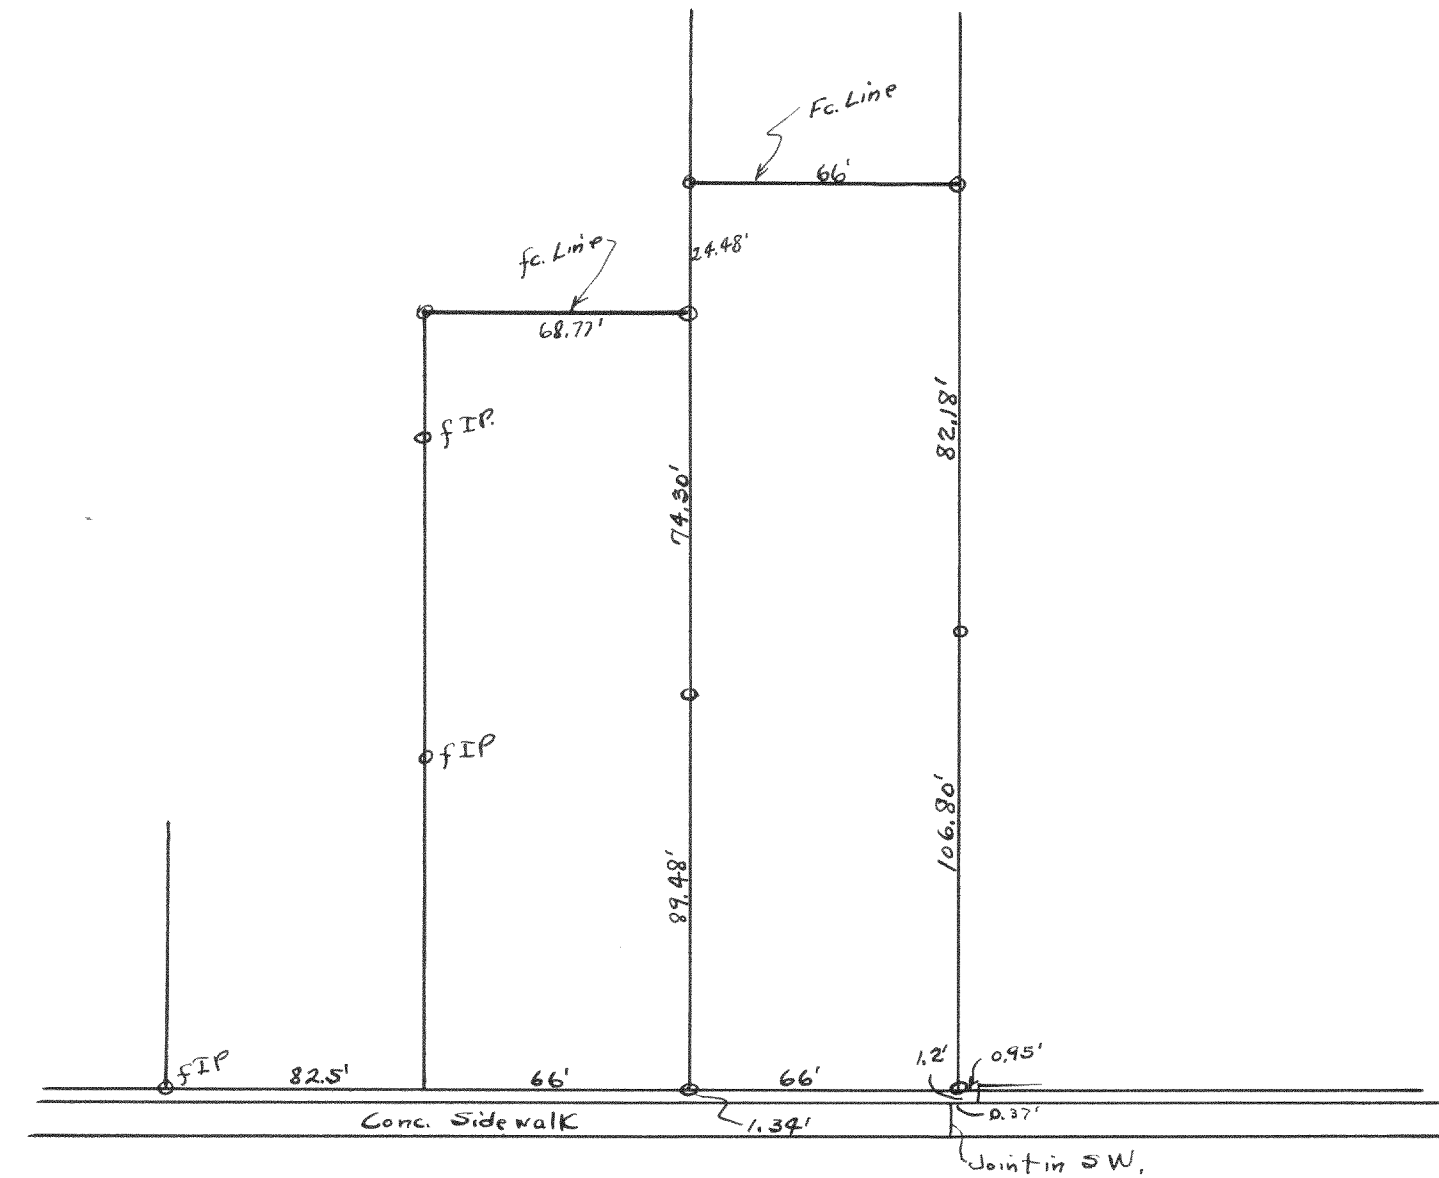

Plat of survey of the South 11.5 Rods of
Lot 6 of Blk. 15 of the original plat
of the City of Whitewater, Walworth
County Wisconsin. Used fences for
lines when making the survey.

Nov. 1, 1944

Lloyd L. Jensen