


1461

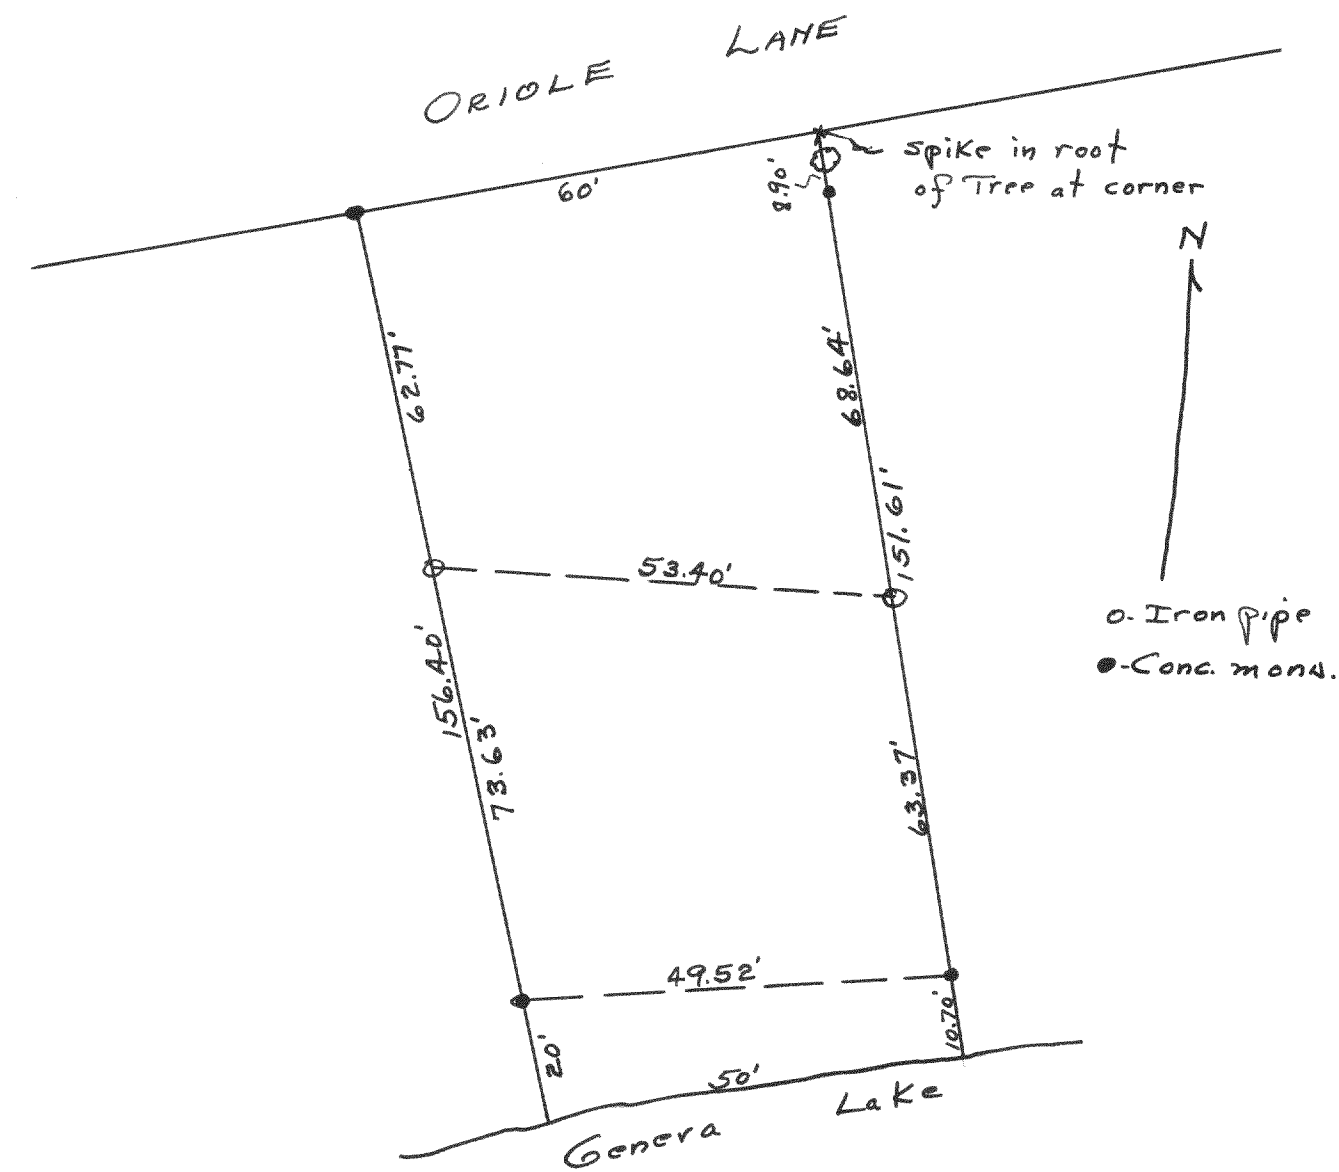


Plot of survey of Lot 12 of Blk. A of Lisco
Beach Subdivision, located in Sections 5,
T17N R17E of Walworth County
Wisconsin.

May 1944

Floyd S. Jensen
County Surveyor

#1462

NE corner of land formerly
owned by Bernice & Shepard and
now owned by Myrtle Hollister

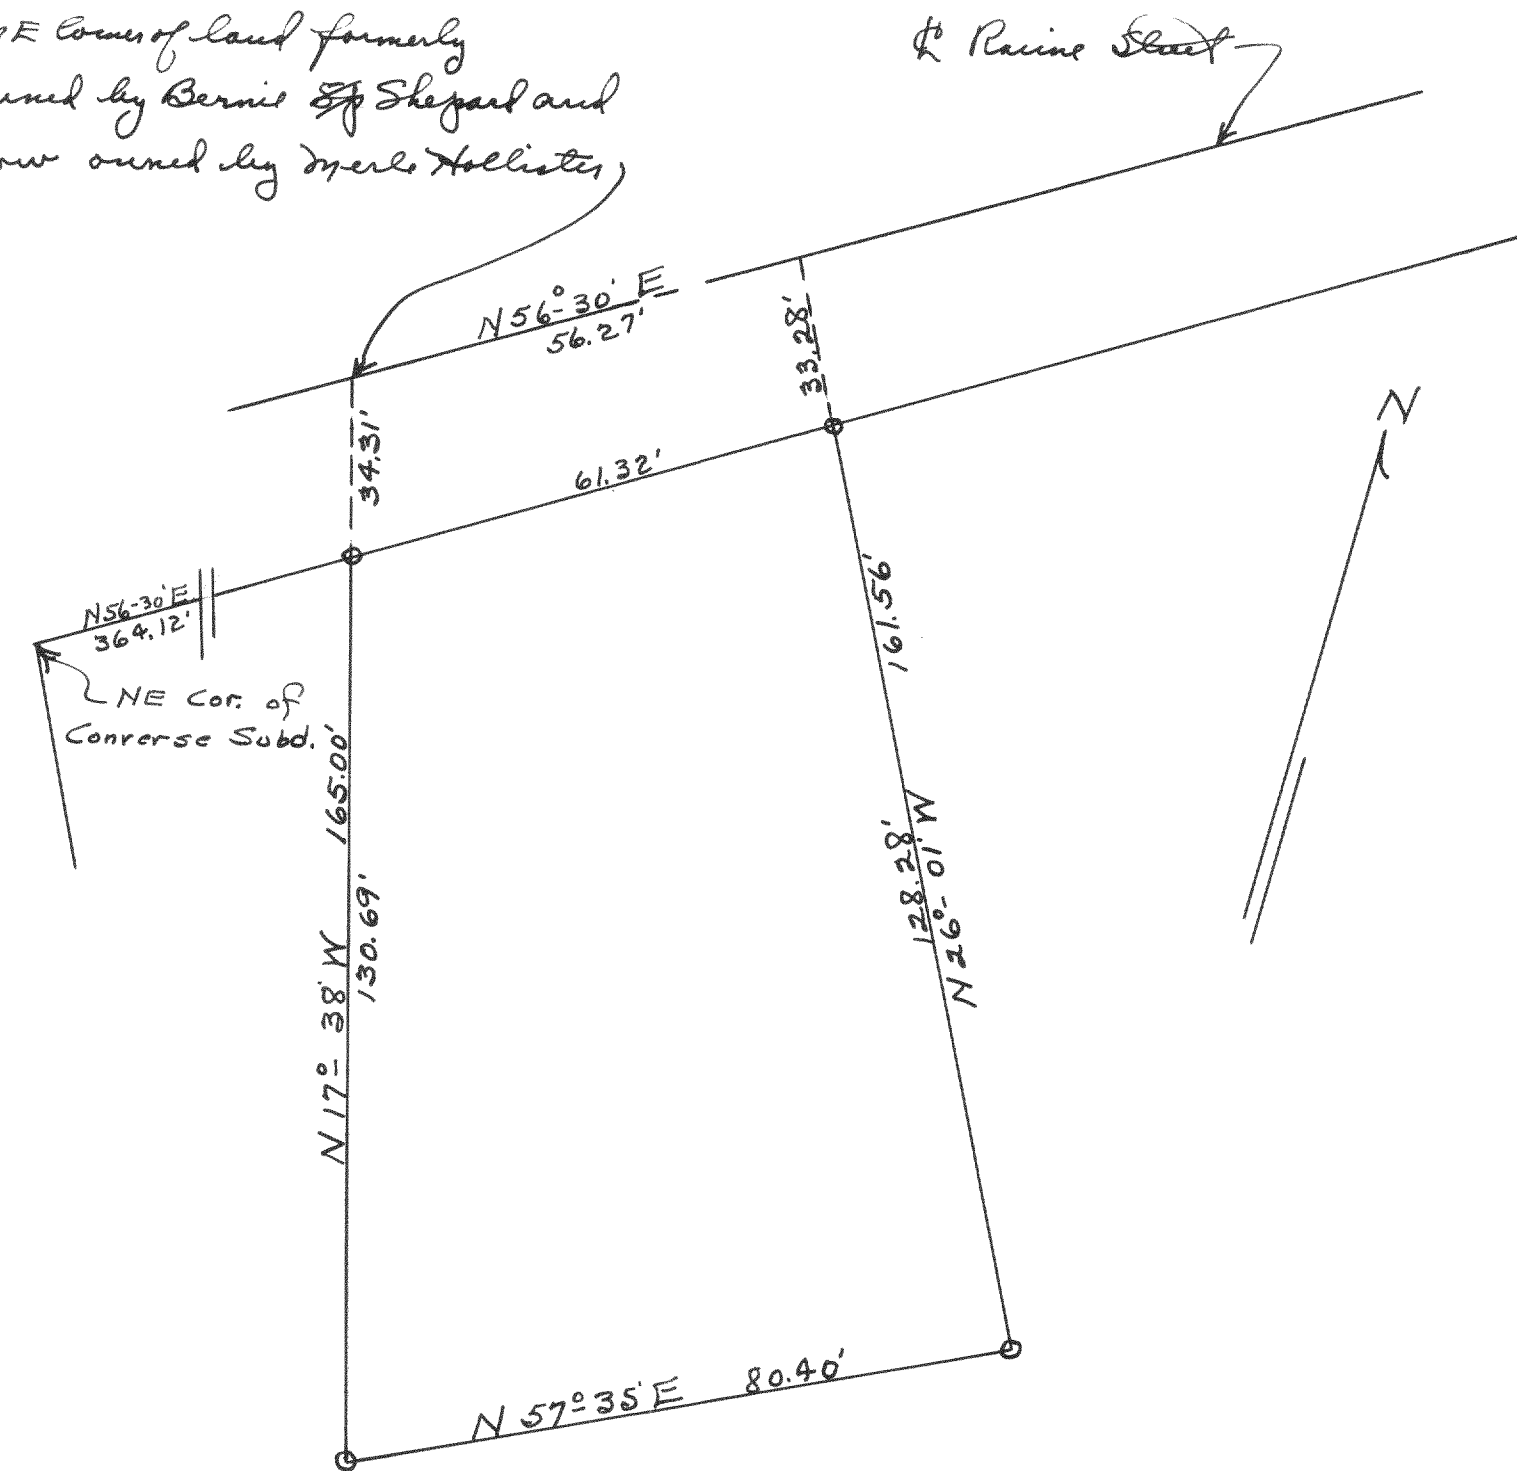

Plot of survey of a parcel of land
located in the NE 1/4 of Section 17,
T27N R16E - City of Beloit

May 1944

Floyd S. Jensen
County Surveyor