


#1463

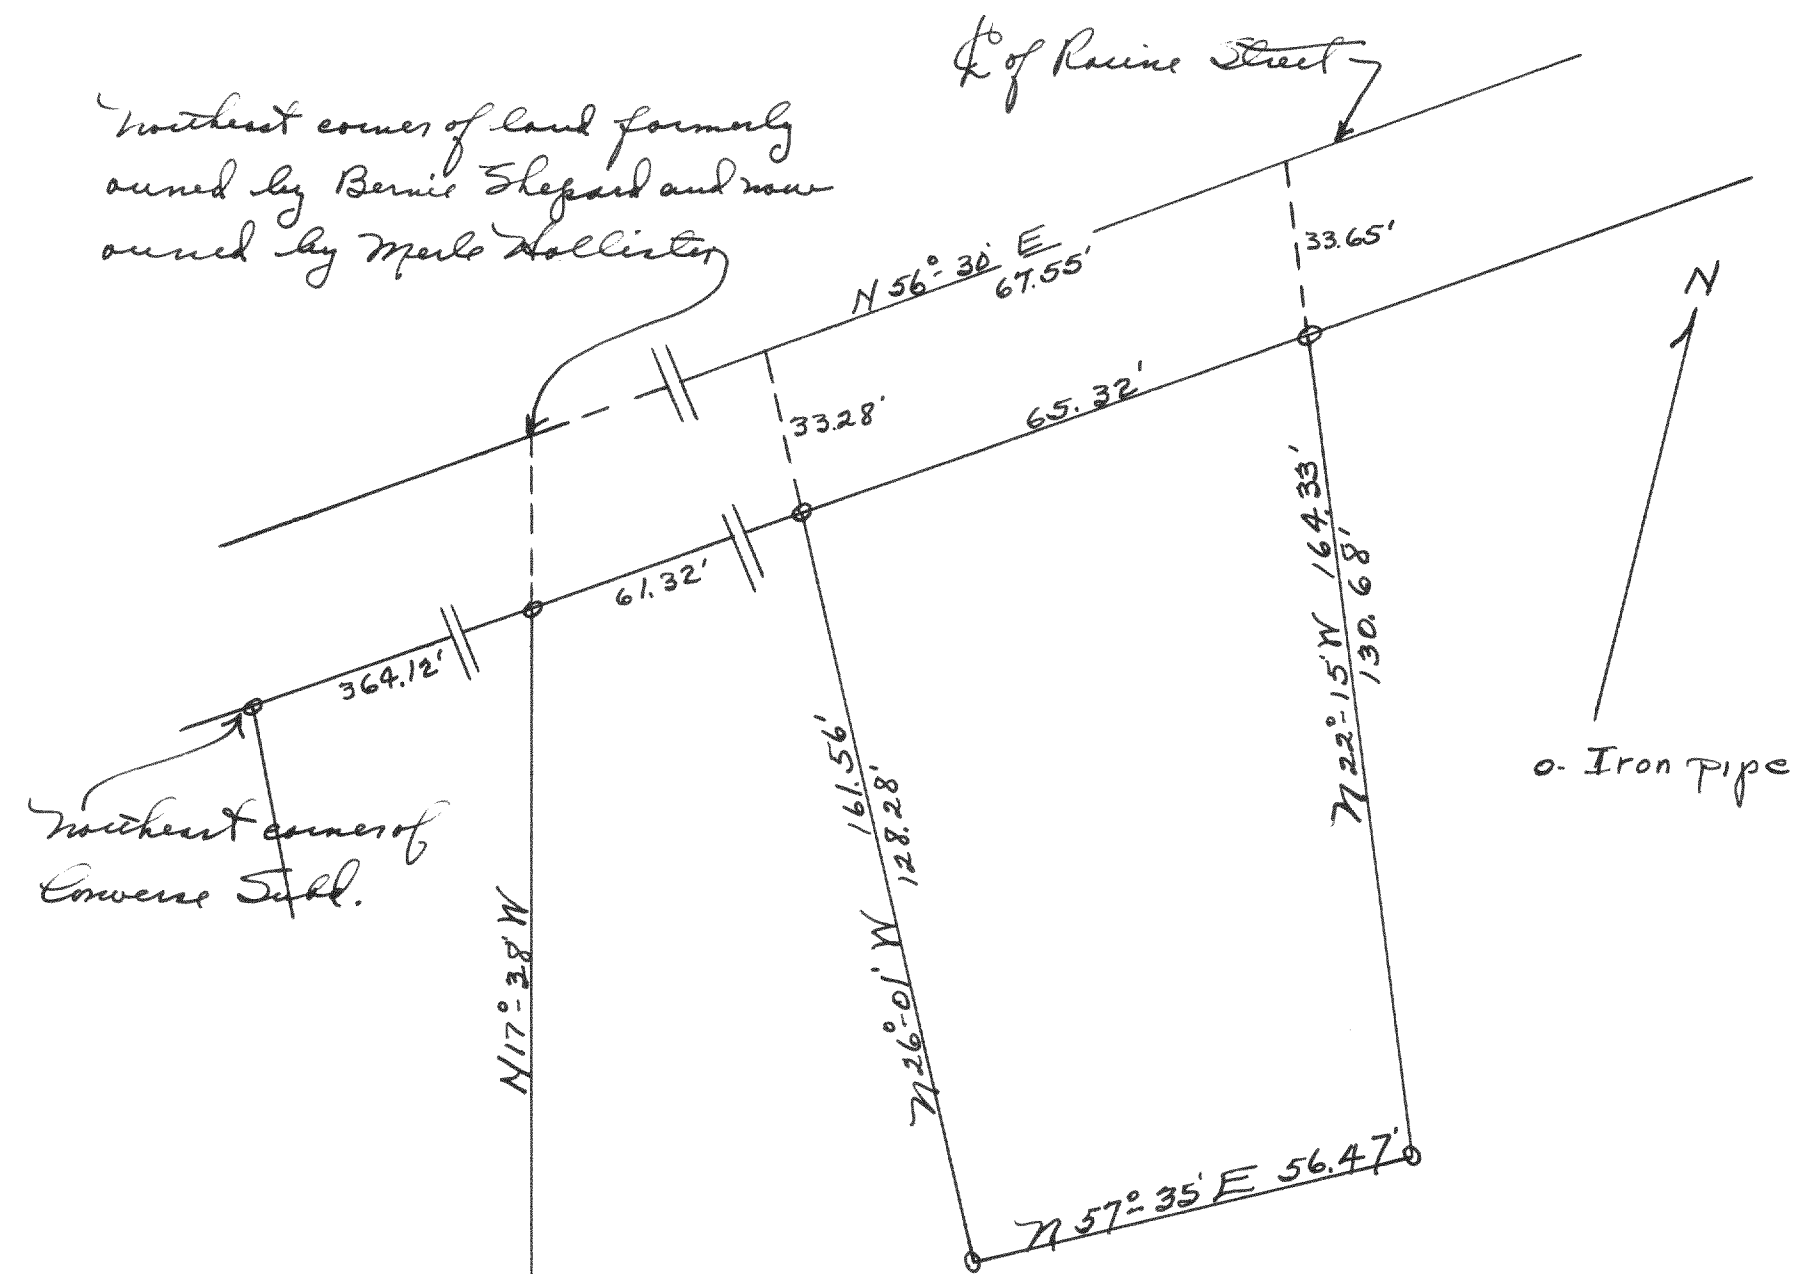


Plot of a survey of land located
in the NE $\frac{1}{4}$ of Section 17, T27N R16E,
City of Kelavan.

May 1944

Lloyd L. Jensen
County Surveyor

#1464

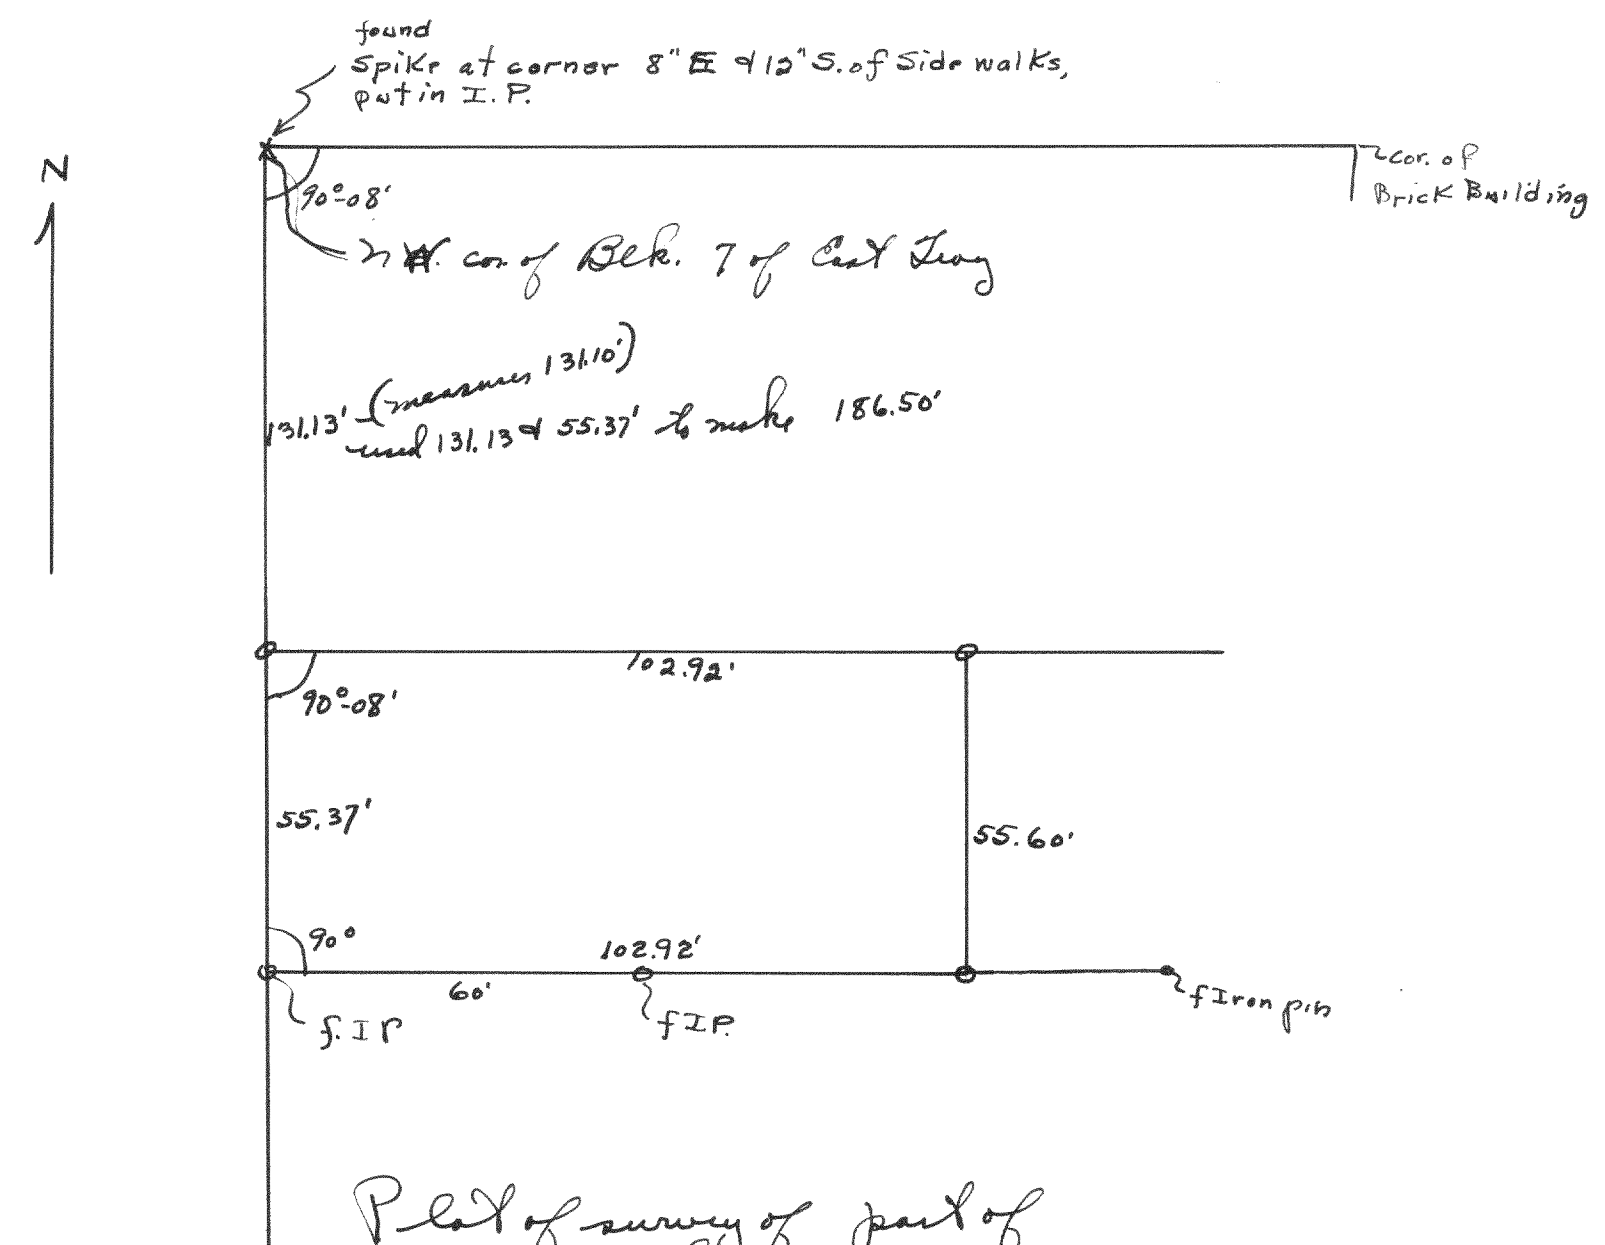

Plot of survey of part of
Bk. 70 of the Original plot
of the Village of East Troy.

April 1944

Lloyd A. Jensen
County Surveyor