


1465

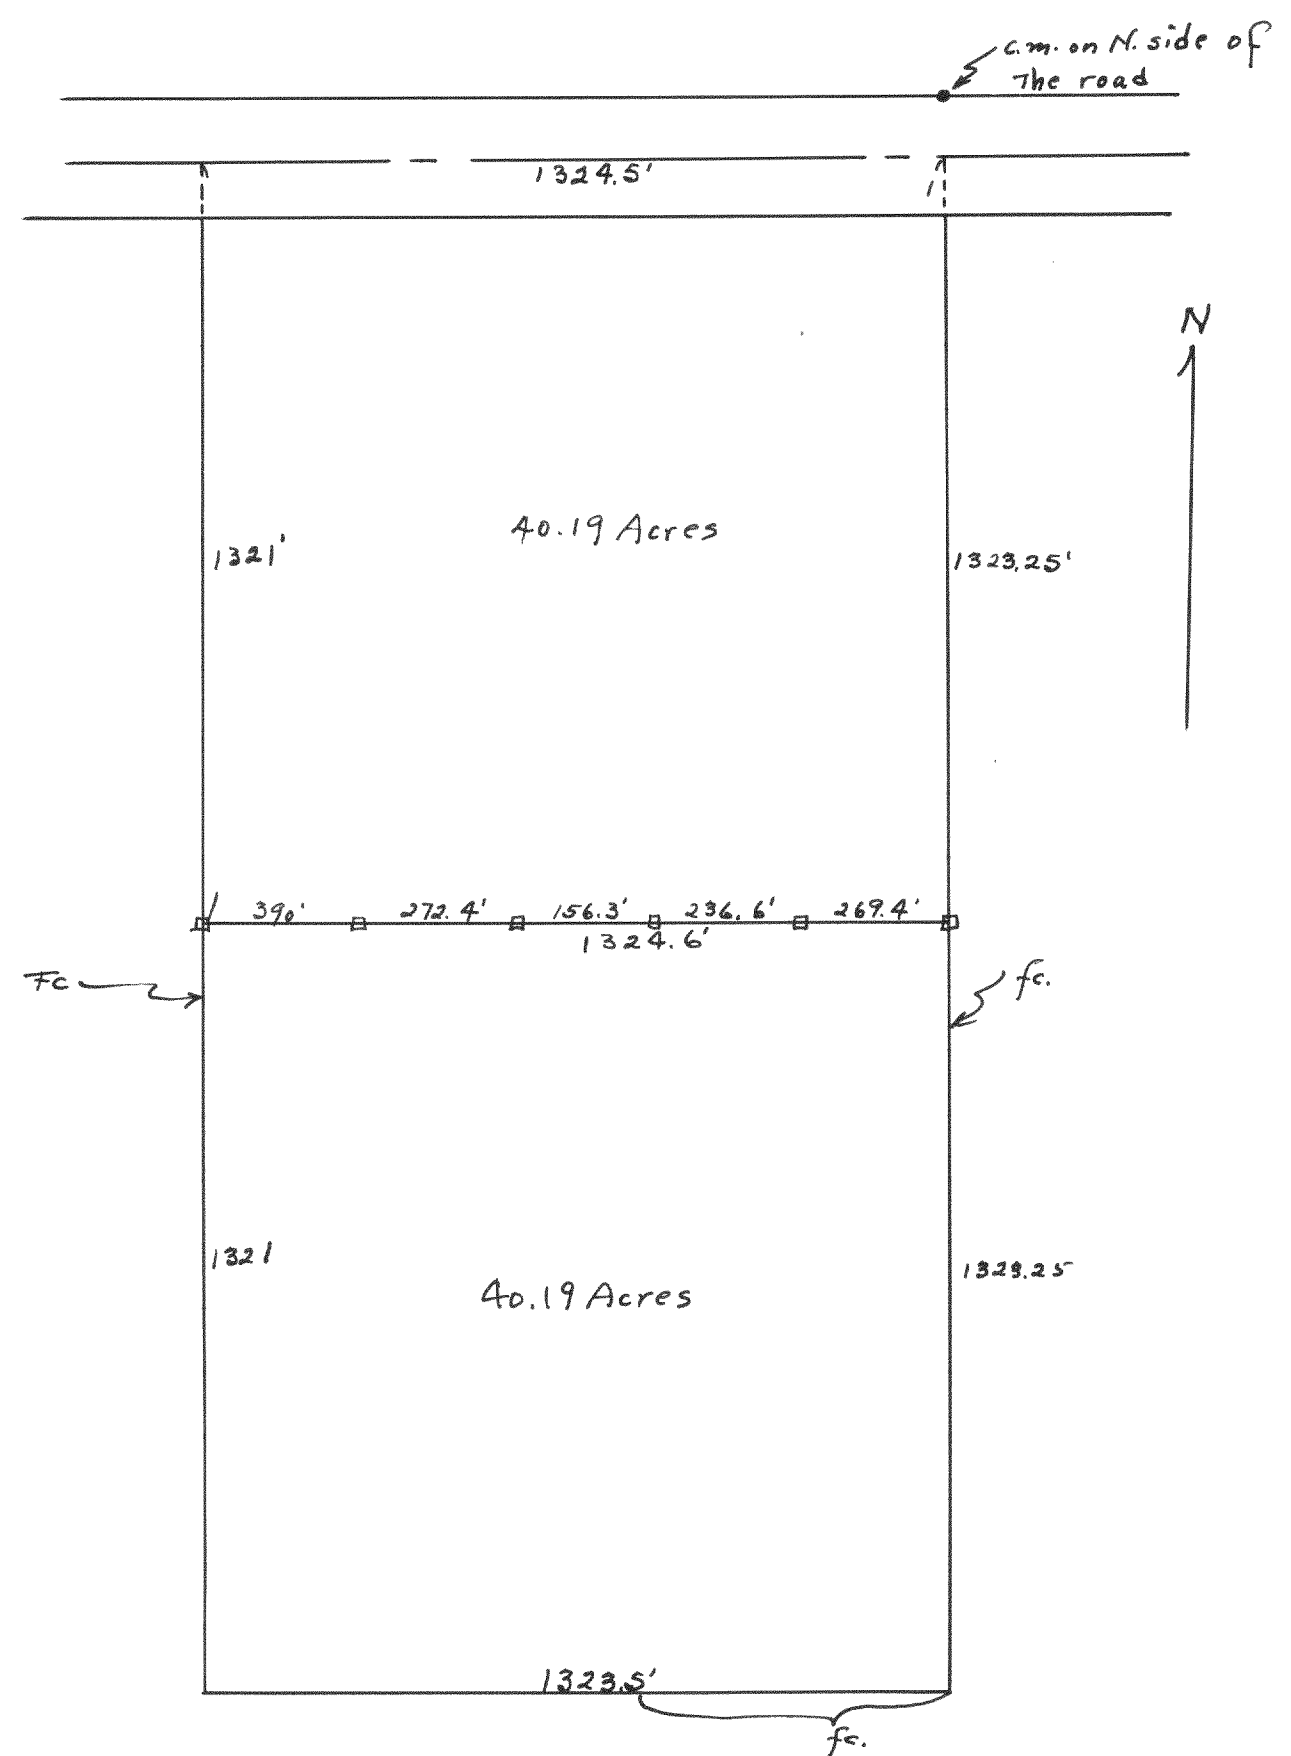

Plot of a fence line survey of the West $\frac{1}{2}$ of the SW $\frac{1}{4}$ of Section 17, T17N R17E to divide the 80 acres across the center of the property.

Lloyd S. Jensen
County Surveyor
May 1944

1466



Plot of survey of Lots 16 - 18 of Lake Geneva Beach Subd., located in Section 11, T17N R17E.

June 1944
Lloyd S. Jensen
County Surveyor