


#1467

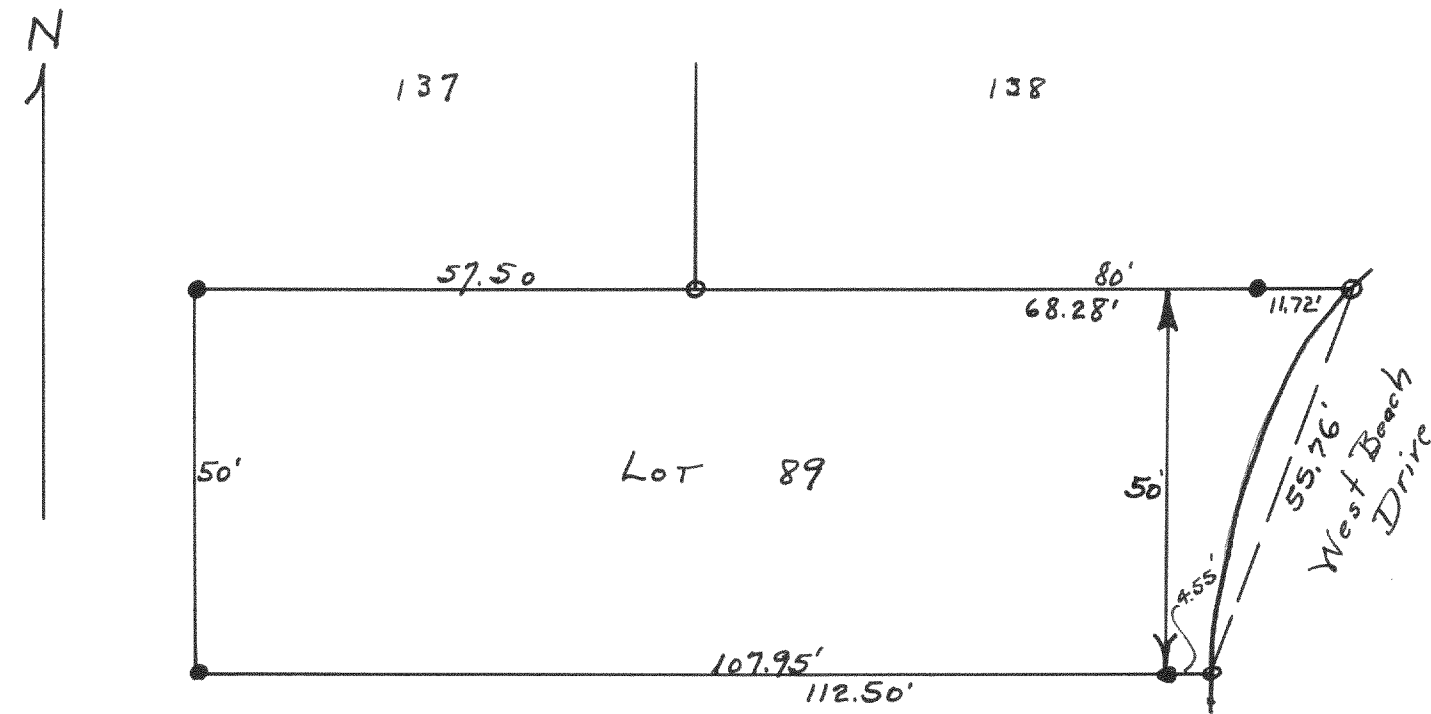


Plot of survey of Lot 89 of Lake Geneva
Beach Subd., located in Section 11, T17N
R 17E of Walworth County Wisconsin

July 1944

Lloyd D. Jensen
County Surveyor

#1468

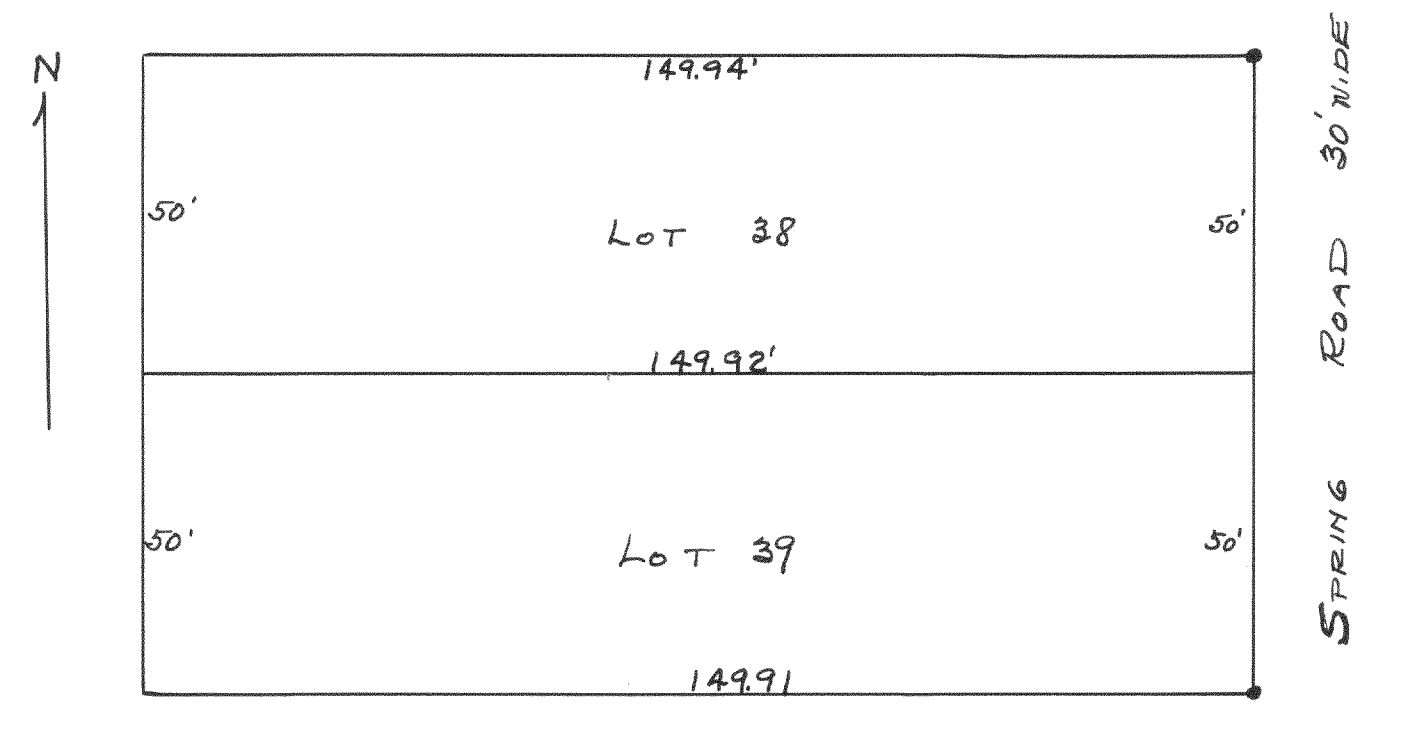

Plot of survey of Lots 38 and 39 of
Lake Geneva Beach Subd., located
in Section 11, T17N R 17E of
Walworth County Wisconsin.

Aug. 1944

Lloyd D. Jensen
County Surveyor