


#1469

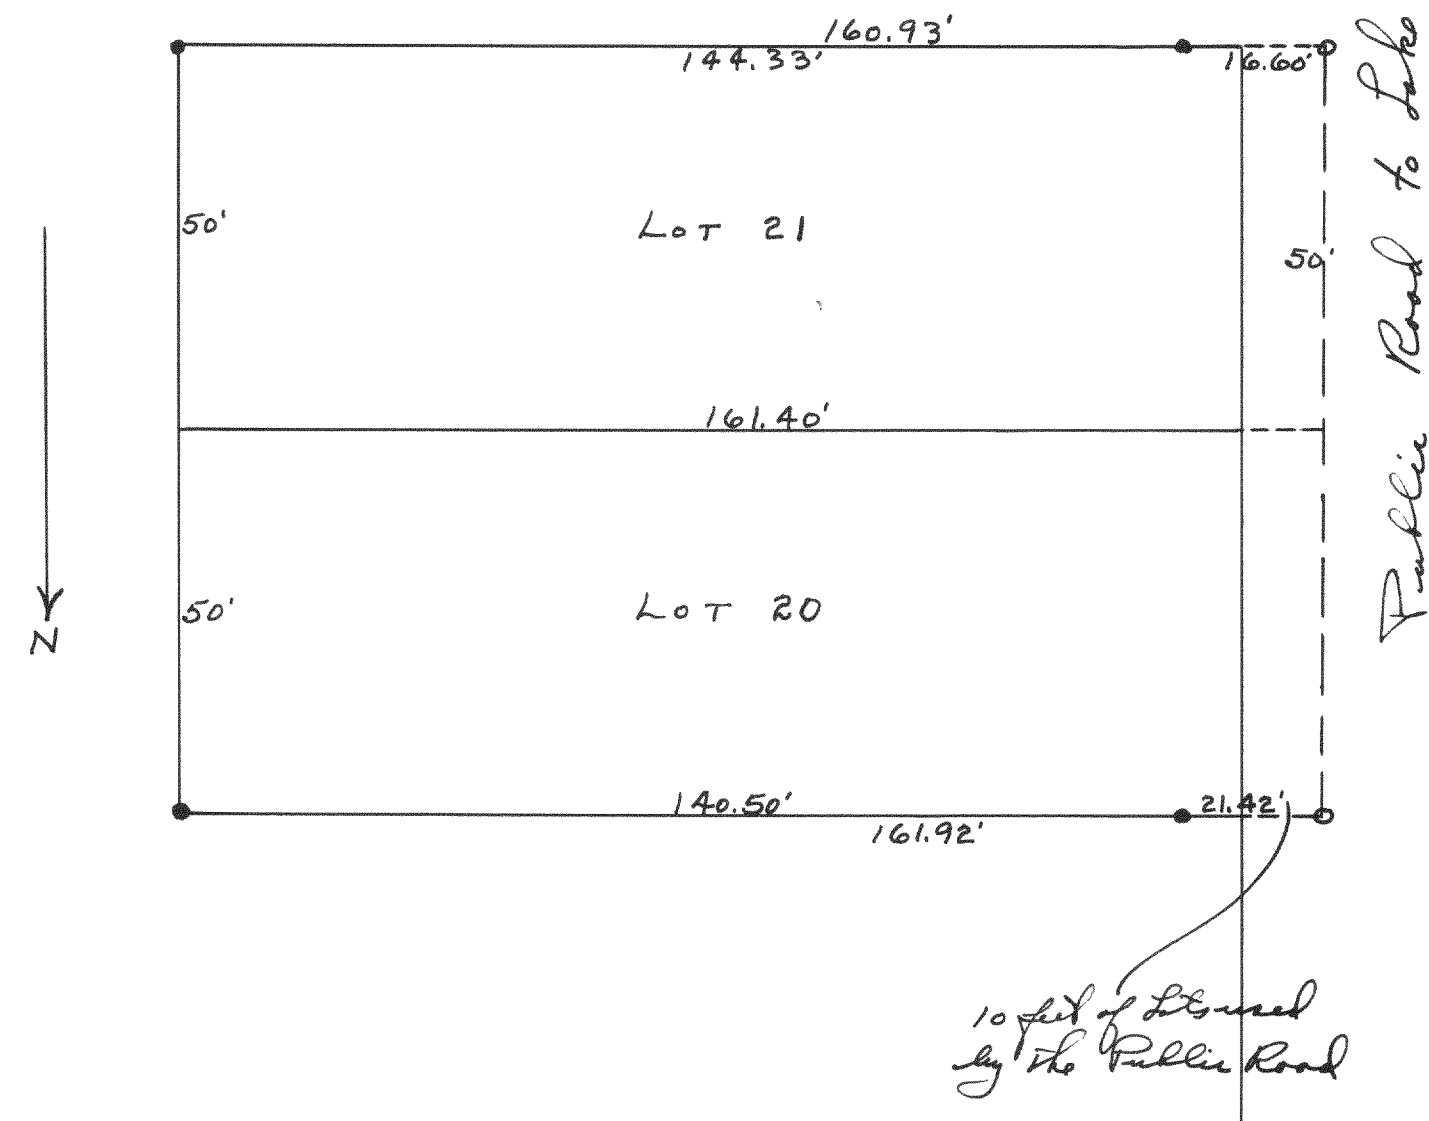


Plot of survey of Lots 20 and 21 of Lake Geneva
Beach Subdivision, located in Section 11, T17N
R17E of Walworth County Wisconsin.

Aug 2, 1944

Lloyd L. Jensen
County Surveyor

#1470

N
↑

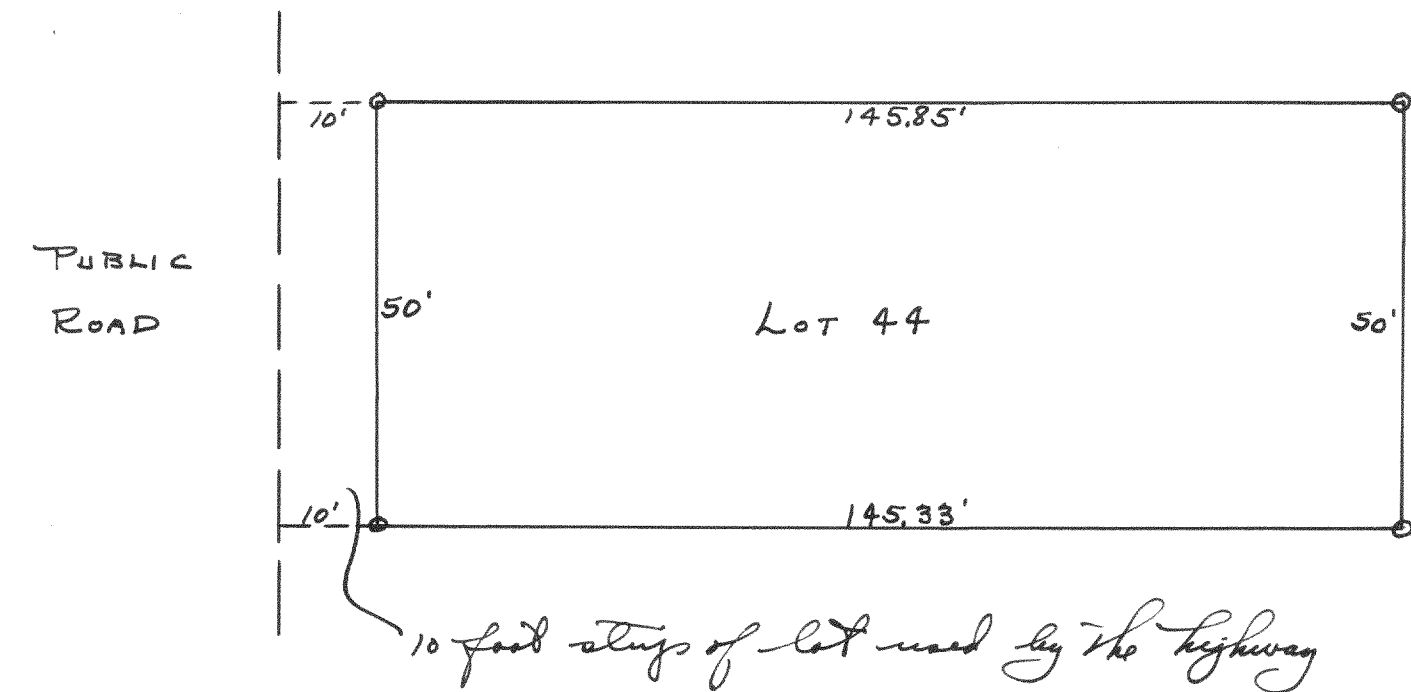

Plot of survey of Lot 44 of Lake Geneva
Beach Subd., located in Section 11, T17N
R 17 E of Walworth County Wisconsin.

Aug. 1944

Lloyd L. Jensen
County Surveyor