


#1471

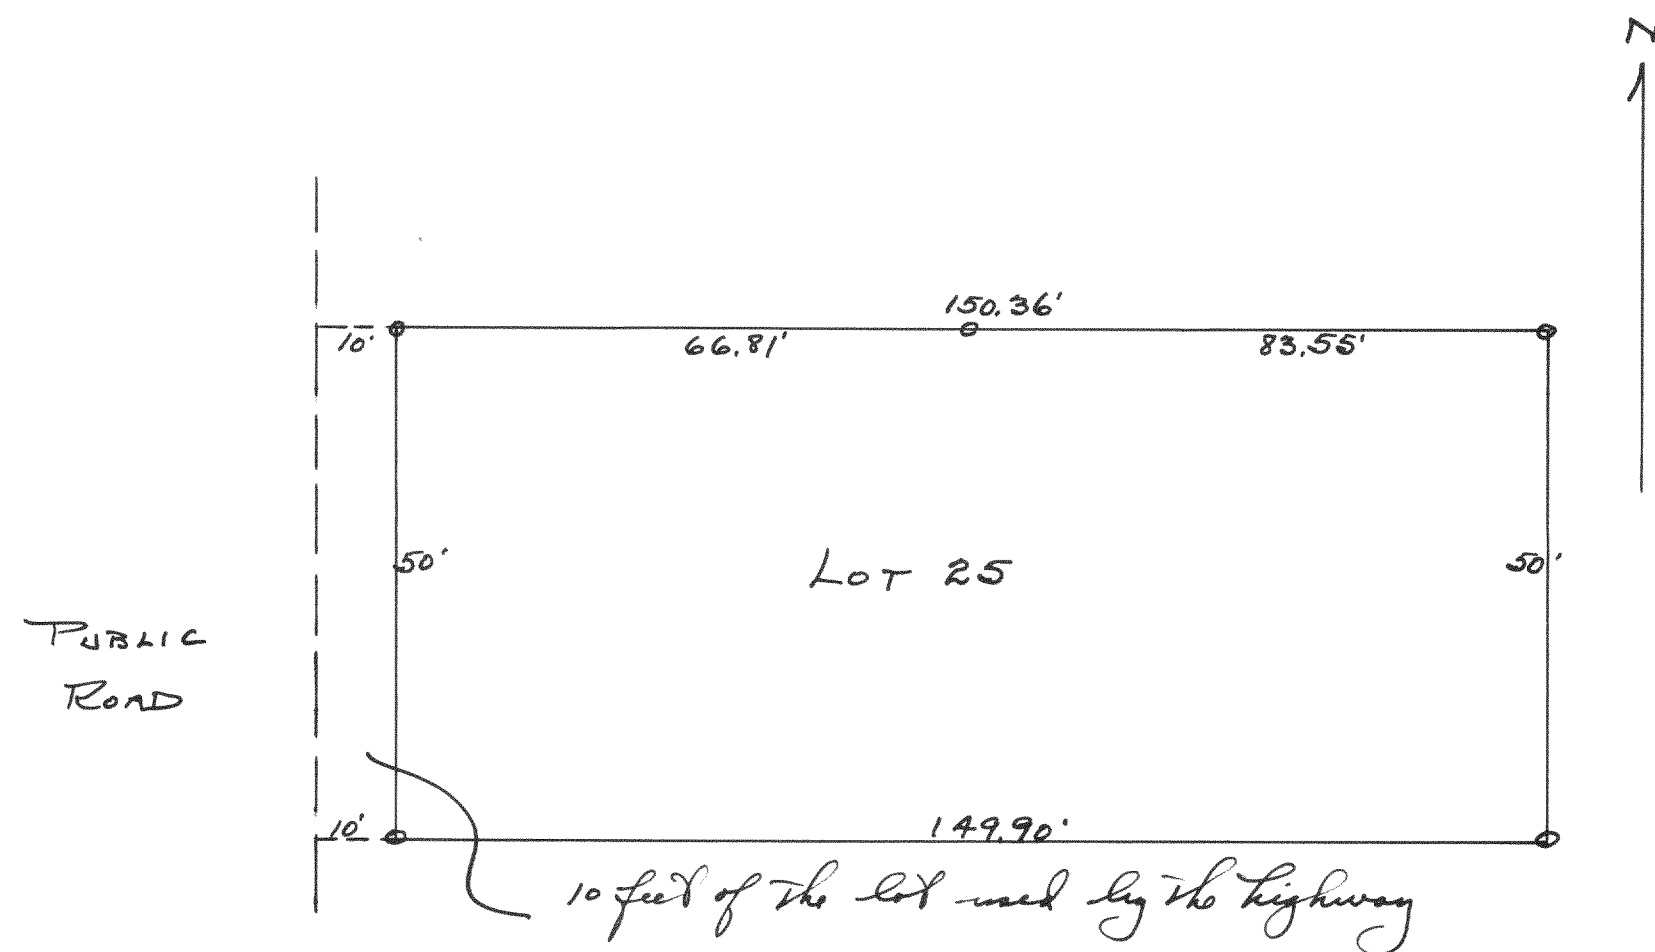


Plot of survey of Lot 25 of Lake Geneva
Beach Subdivision, located in Section 11,
T17N R17E of Walworth County Wisconsin.

Aug. 1944

Lloyd L. Jensen
County Surveyor

#1472

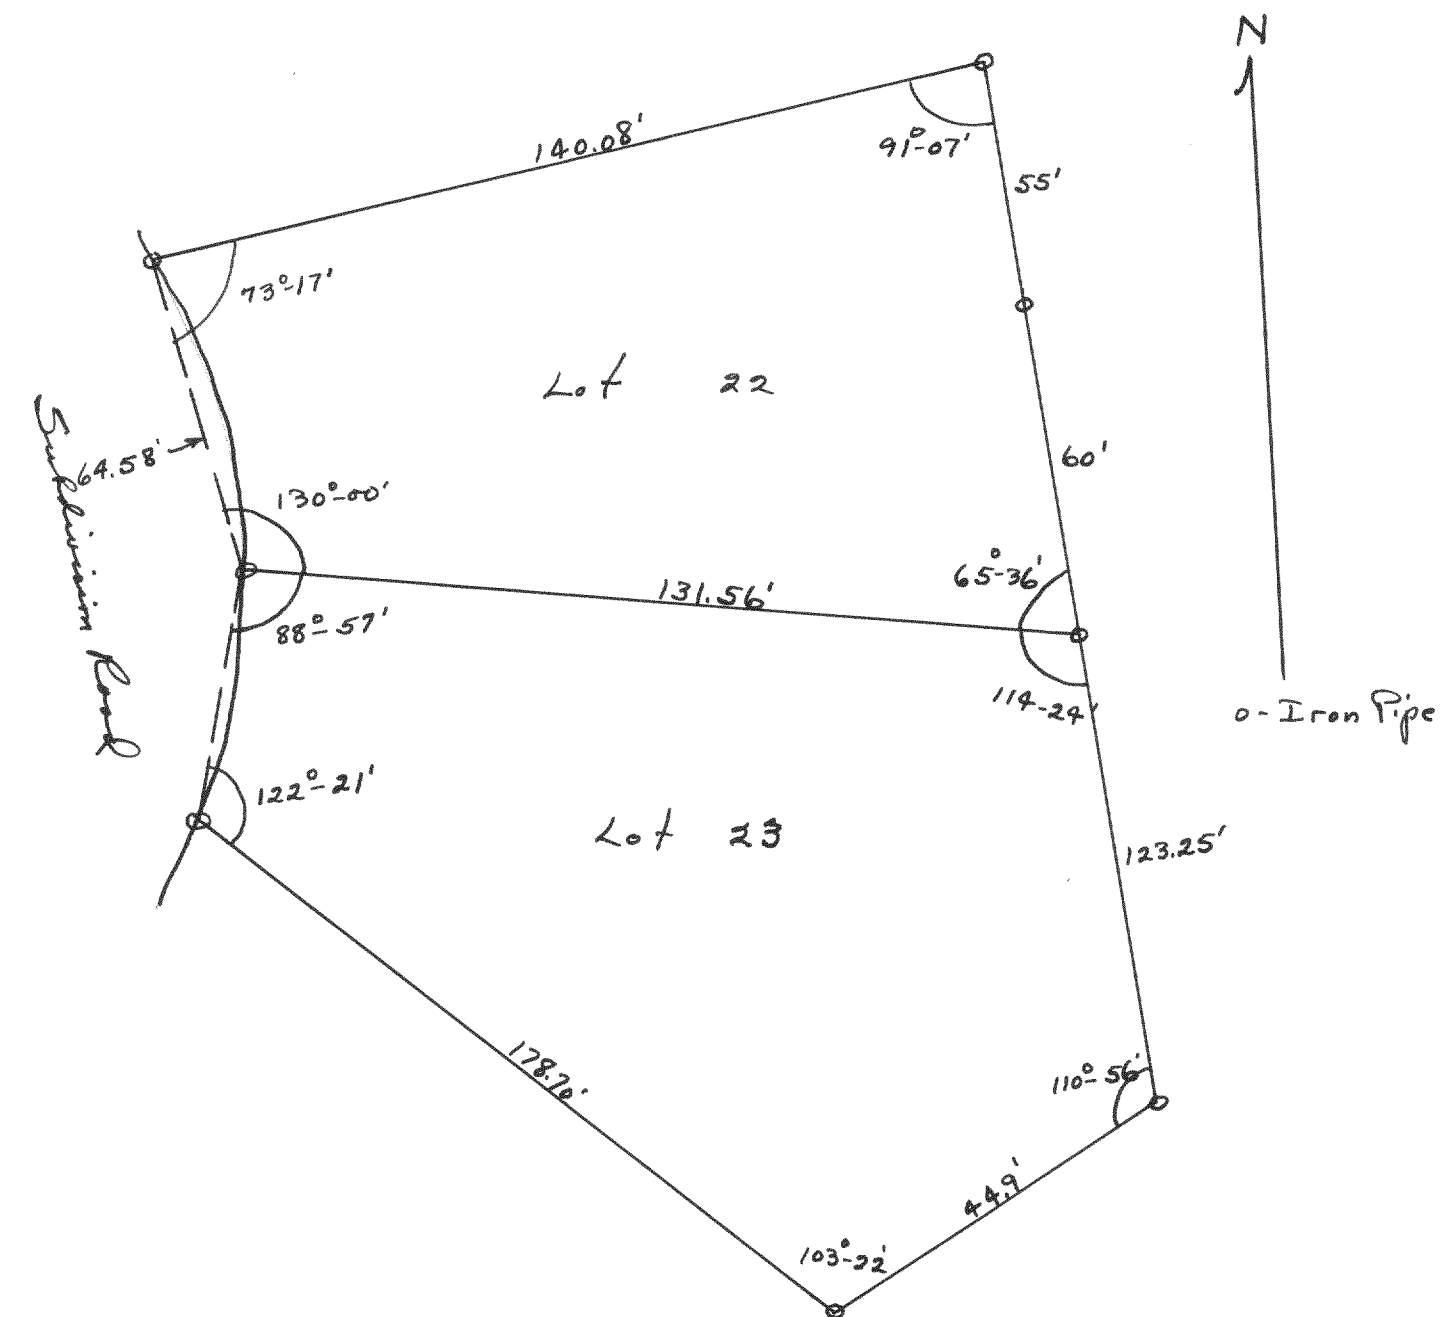

Plot of survey of Lots 22 and 23 of
Woodale Add. - Blk. 3 - Located
in Fractional Section 9, T17N R17E, Walworth
County Wisconsin.

Sept. 1944

Lloyd L. Jensen
County Surveyor