


#1473

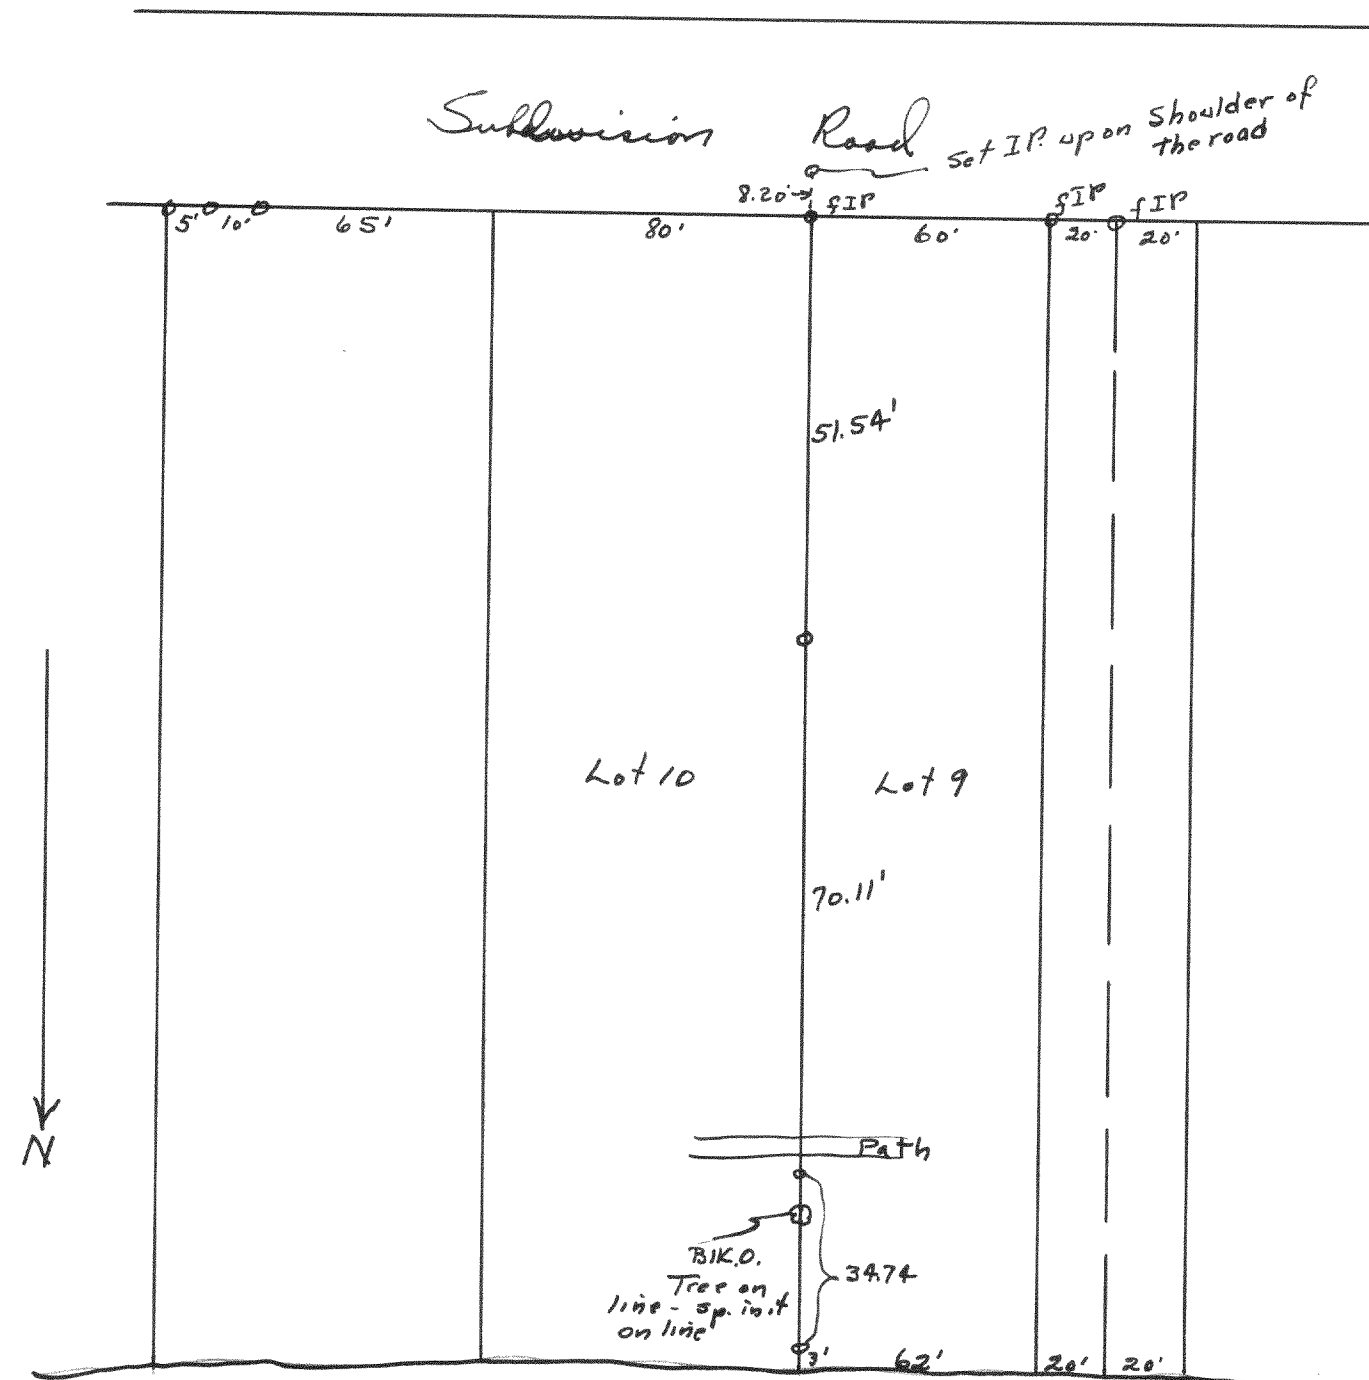


Geneva Lake

Plat of survey of the East line
of Lot 9 of Blk. 1 of Woodale Add.
located in fractional Section 9,
T17N R17E of Walworth County
Wisconsin.

Sept. 1944

Lloyd L. Jensen
County Surveyor

#1474

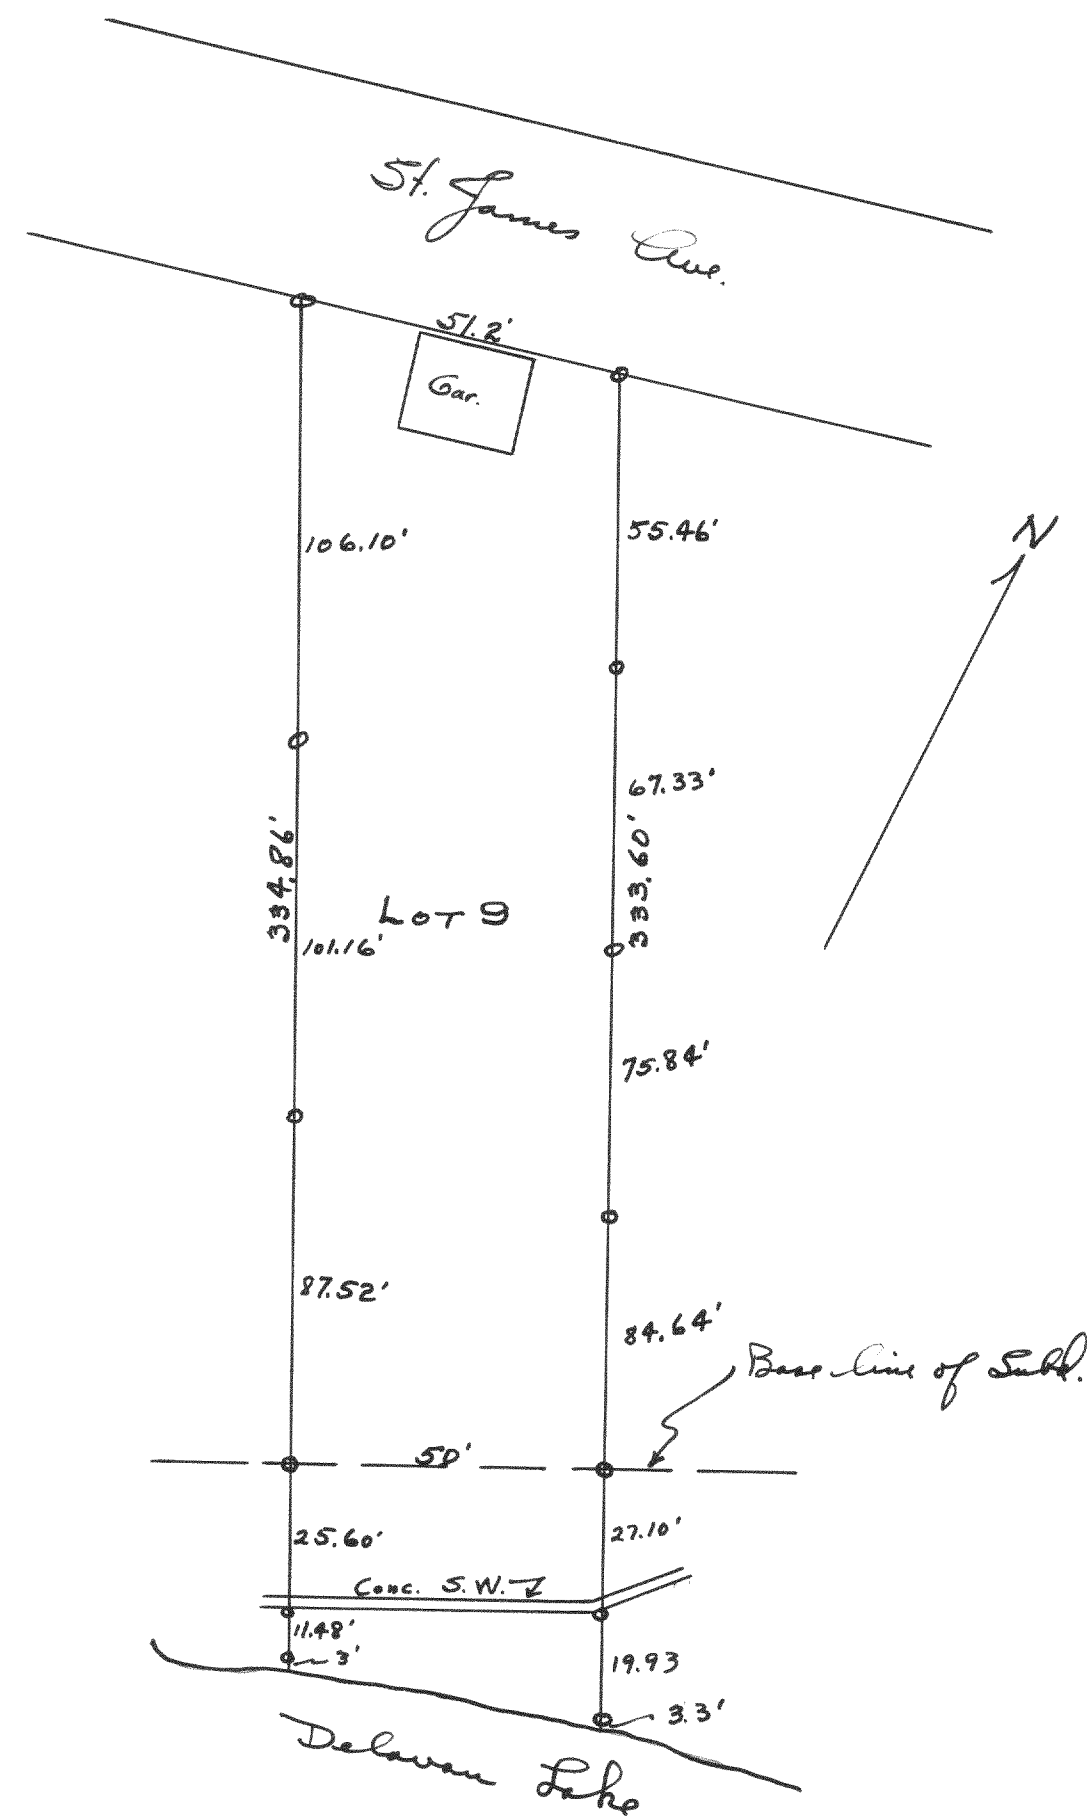

Plat of survey of Lot 9 of St. Mary's
Subdivision located in Section
28, T27N R16E.
Nov. 1944

Lloyd L. Jensen
County Surveyor