


#1481

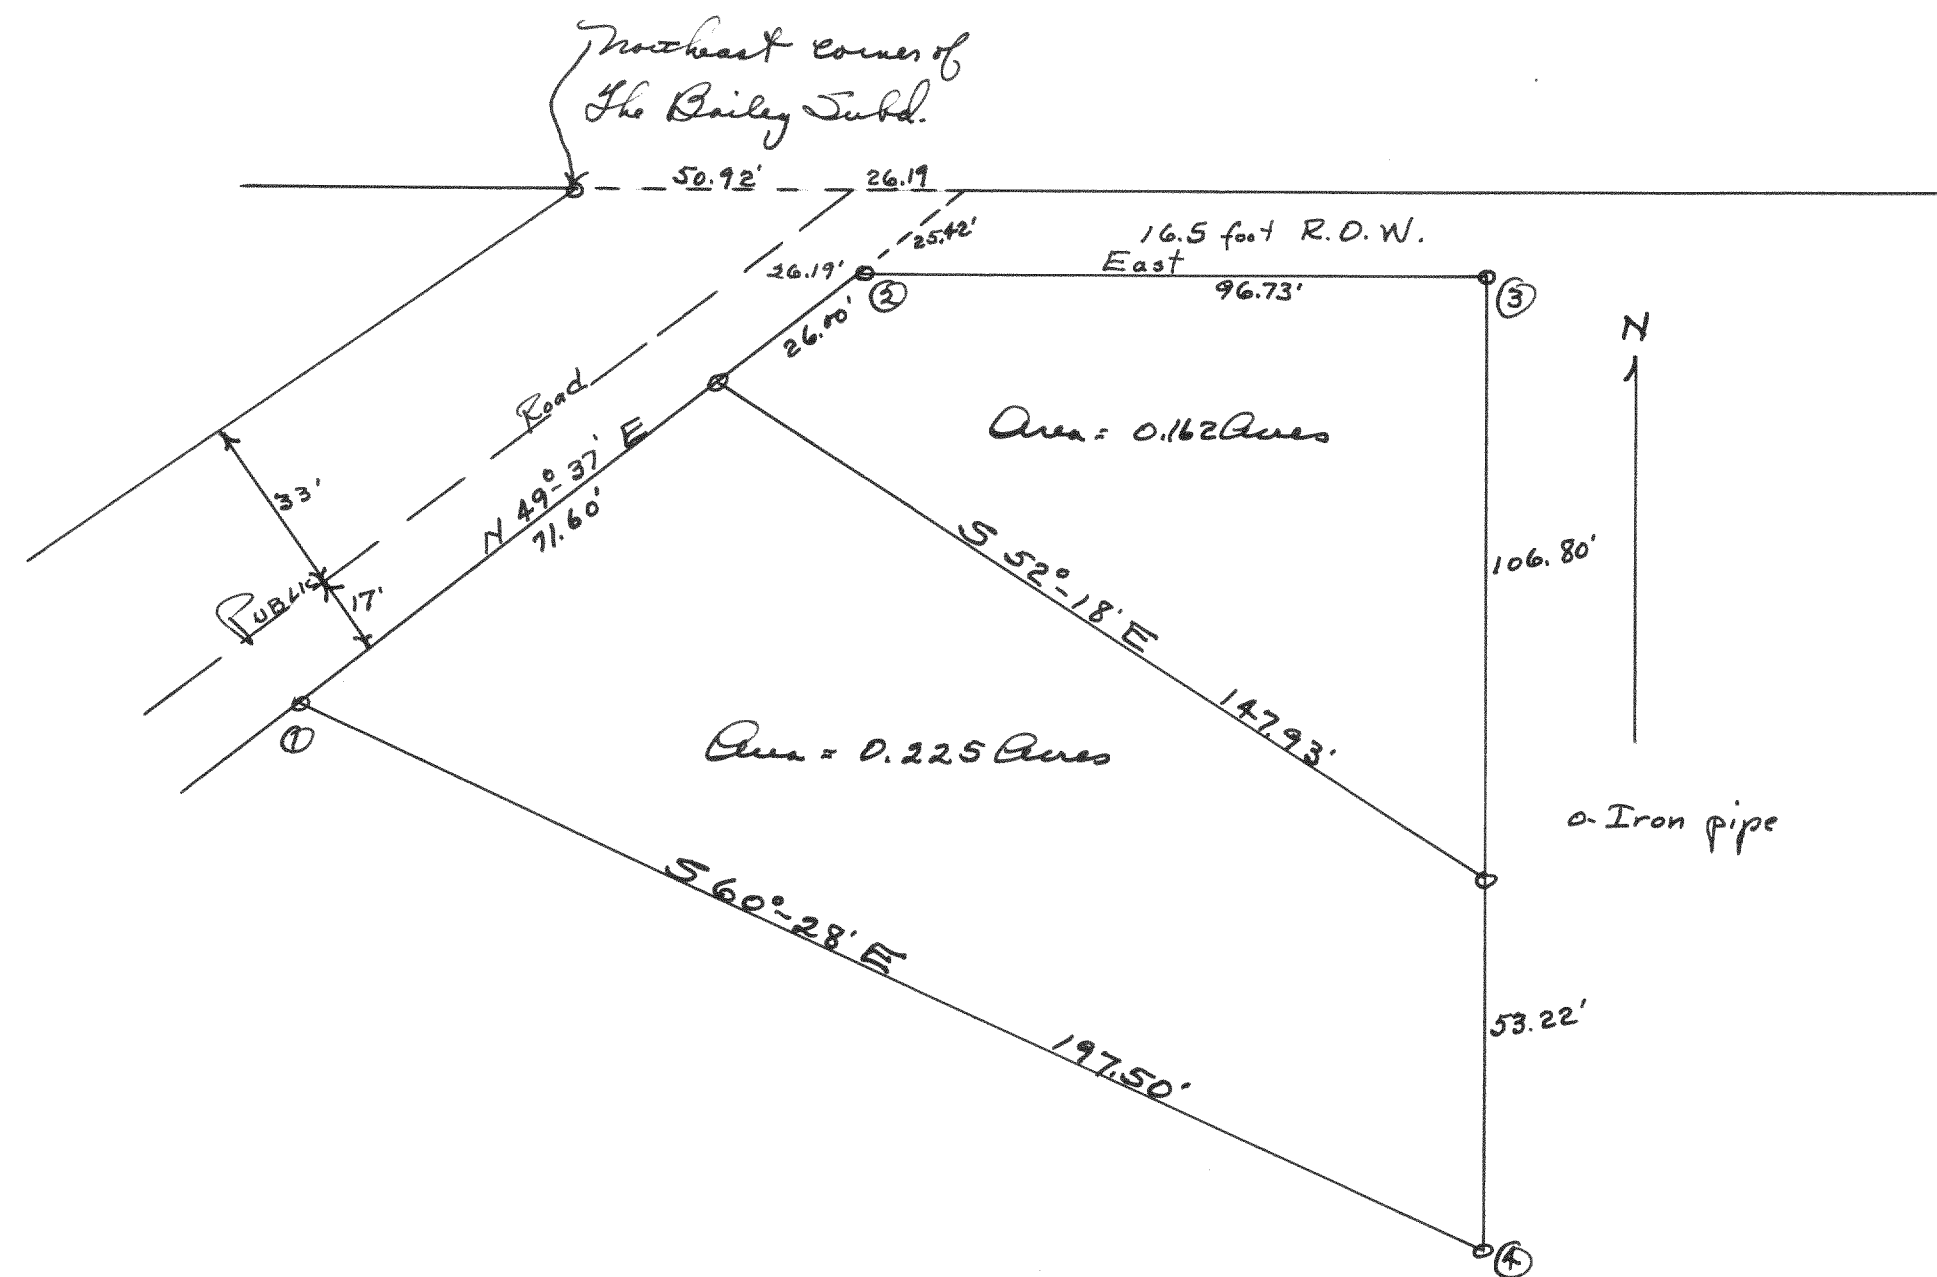


Plot of survey of land located in the West fractional $\frac{1}{2}$ of Section 27, T27N R16E of Walworth County Wisconsin.
 Iron pipes were found at points numbered 1, 2, 3 and 4.

July 1944

Lloyd L. Jensen
 County Surveyor

#1482

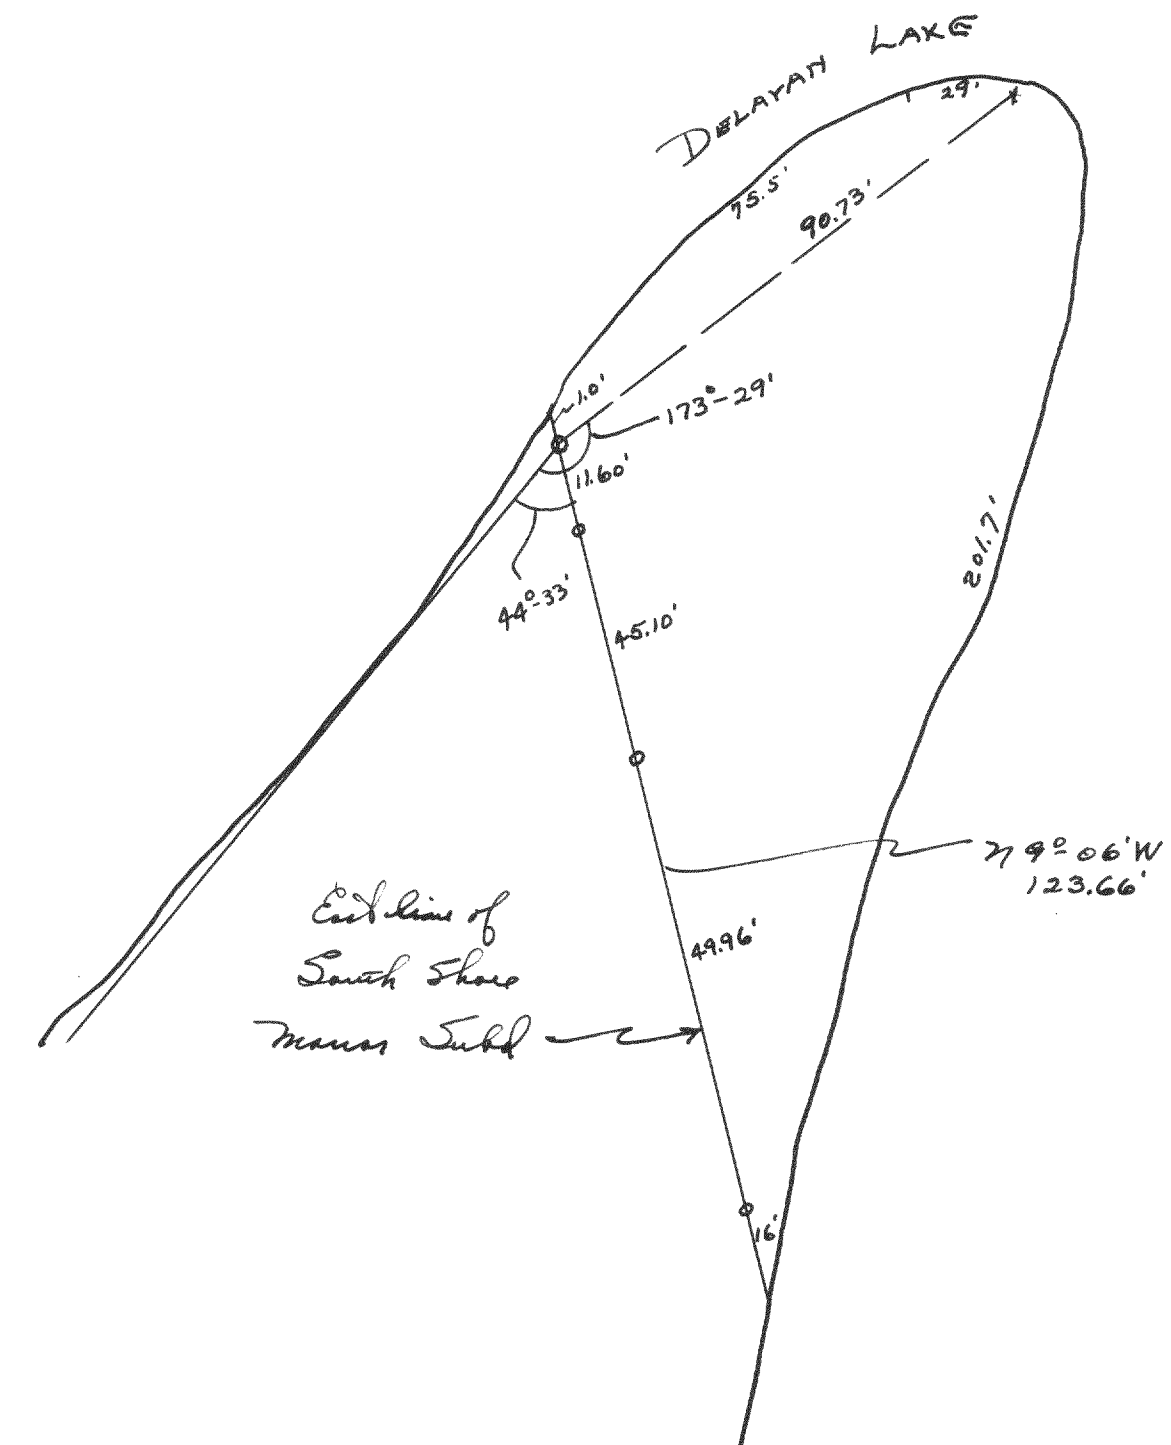

Plot of survey of a parcel of land lying just East of South shore Manor Subd. on the tip of the point.

June 1944

Lloyd L. Jensen
 County Surveyor