


#1486

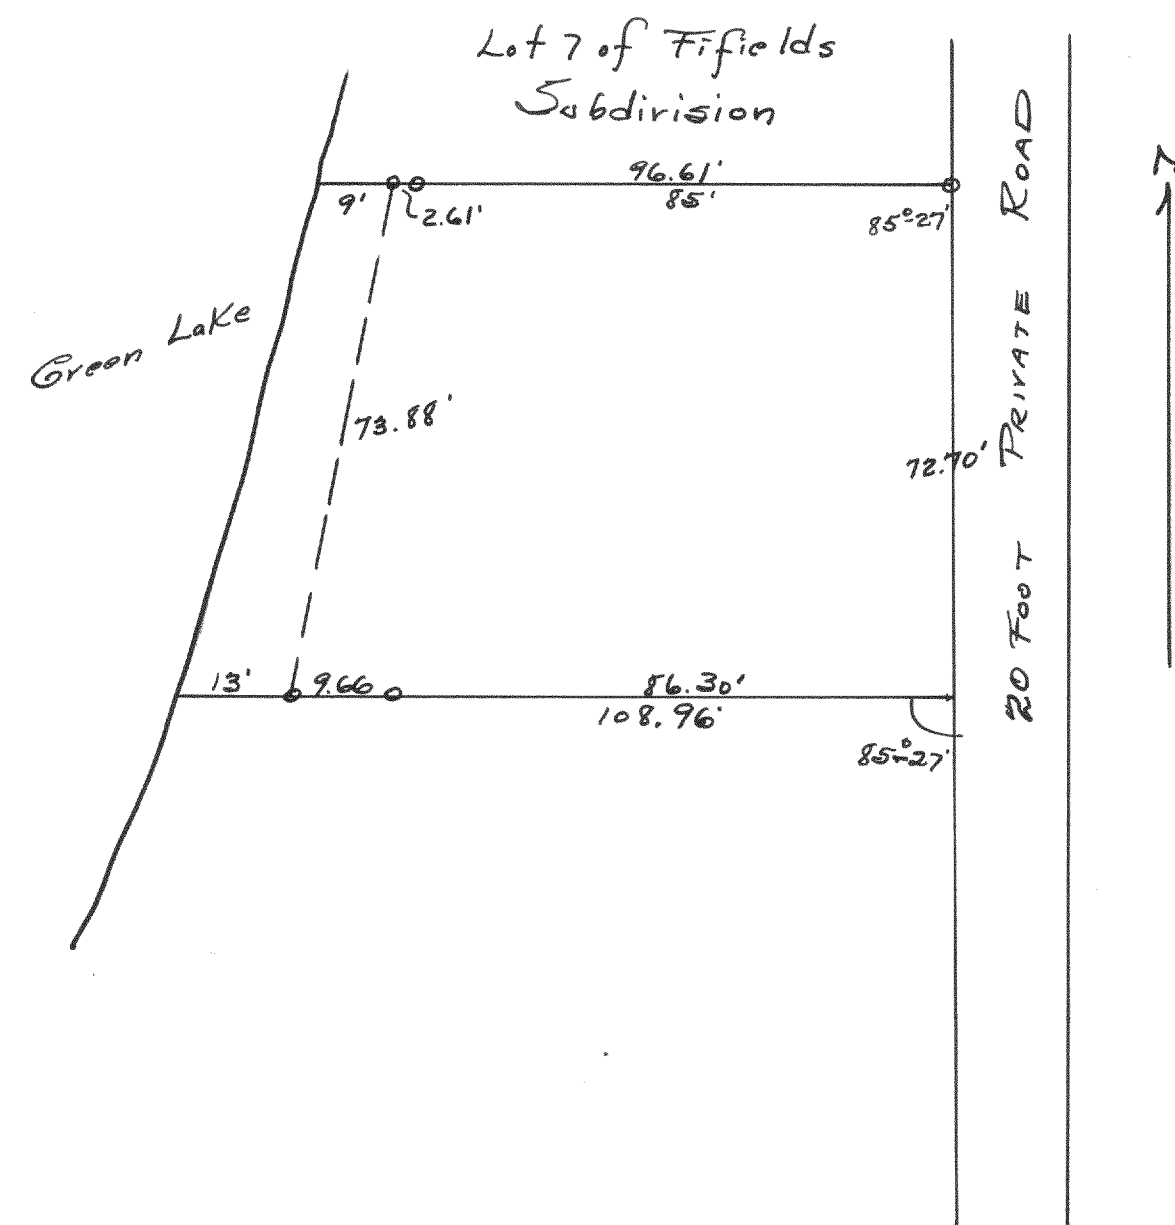


Plot of survey of part of the Outlet of Highland Park Subdivision, which is located in the NE  $\frac{1}{4}$  of Fractional Section 26, T47N R16E of Walworth County Wisconsin.

Aug. 1944

Lloyd L. Jensen  
County Surveyor

#1487

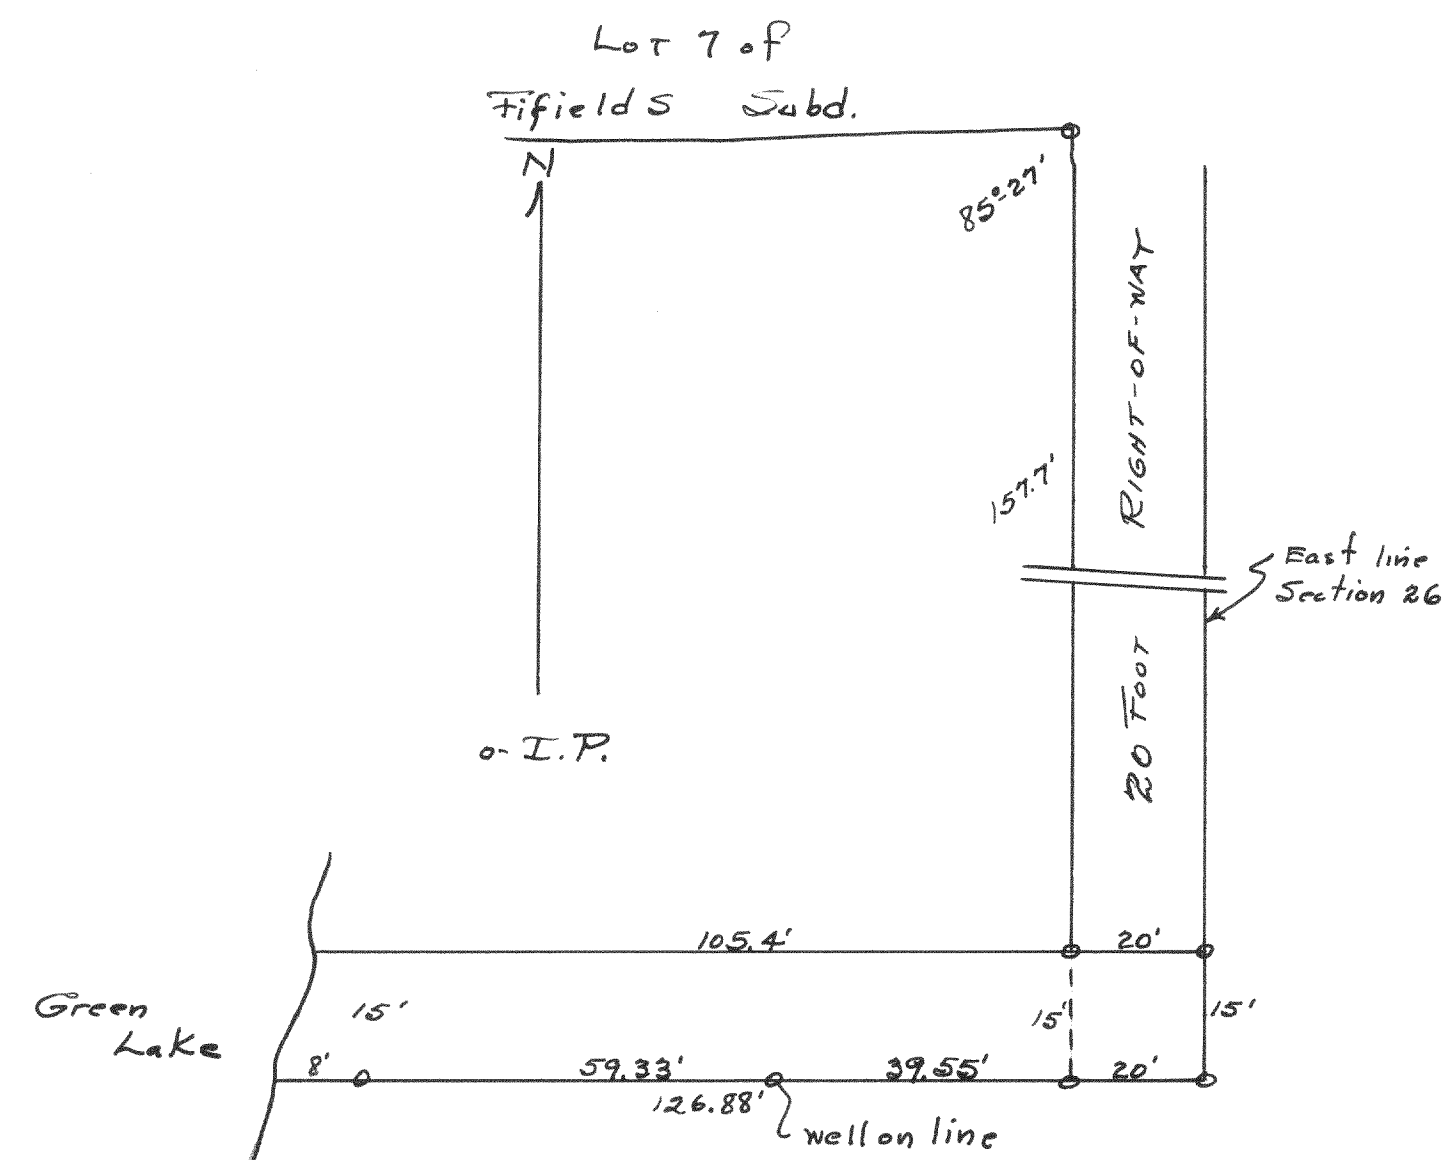

Plot of survey of part of the Outlet of Highland Park Subdivision, located in the NE  $\frac{1}{4}$  of Fractional Section 26, T47N R16E of Walworth County.

Aug. 1944

Lloyd L. Jensen  
County Surveyor