



#1491

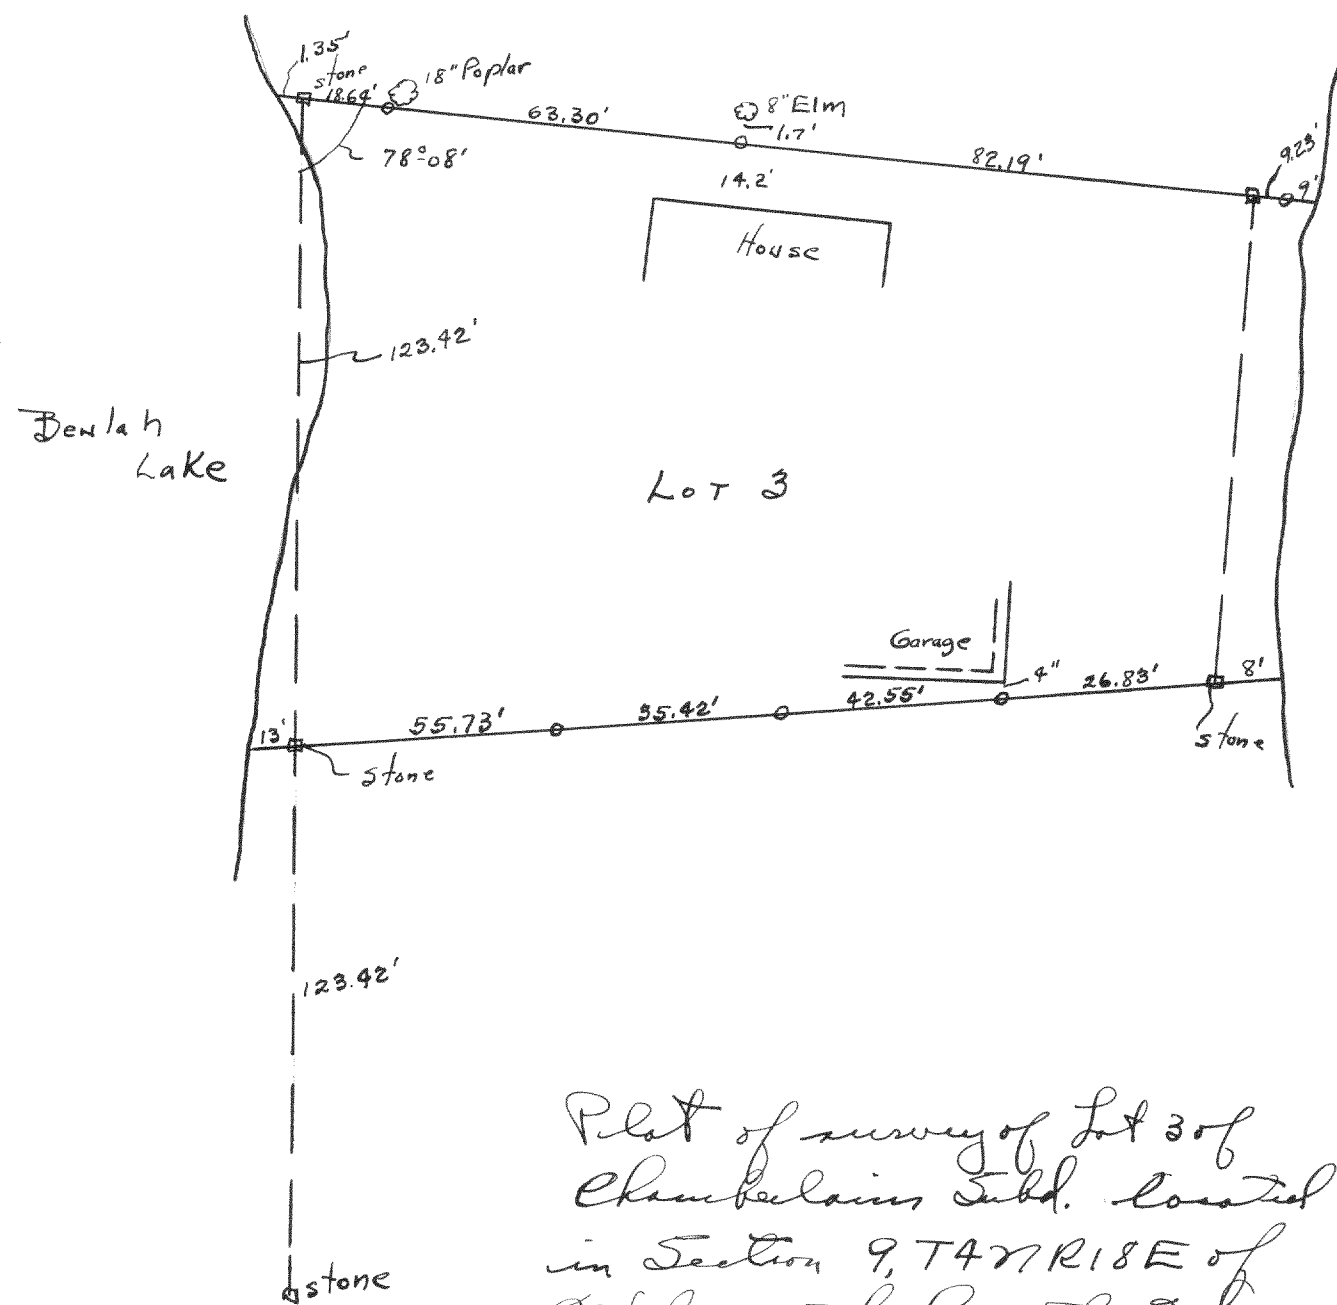

Plot of survey of Lot 3 of
Chamberlains Subd. located
in Section 9, T47N R18E of
Walworth County Wisconsin
July 8, 1944 Lloyd J. Jensen
County Surveyor

#1492

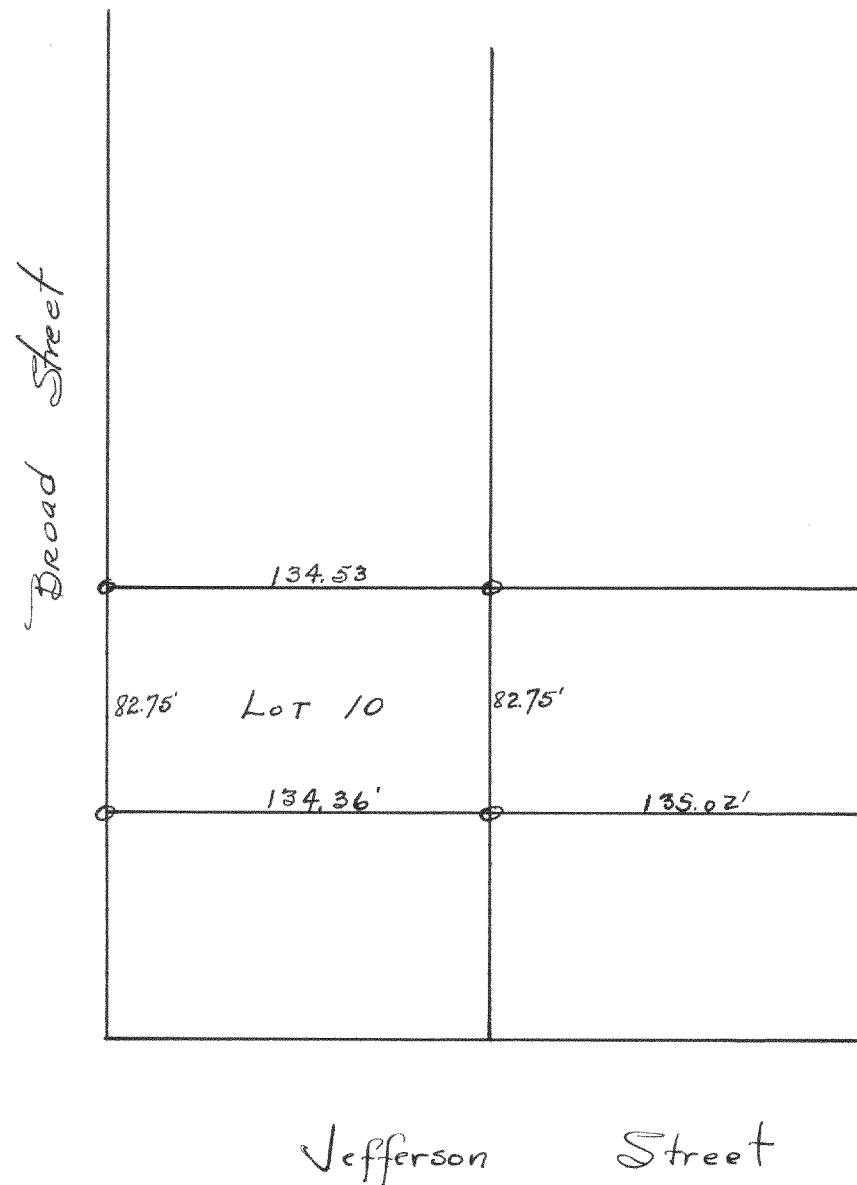

Plot of survey of Lot 10 of Blk. 9 of
the original Plat of City of Oakhorn.
March 1944 Lloyd J. Jensen
County Surveyor