


#1493

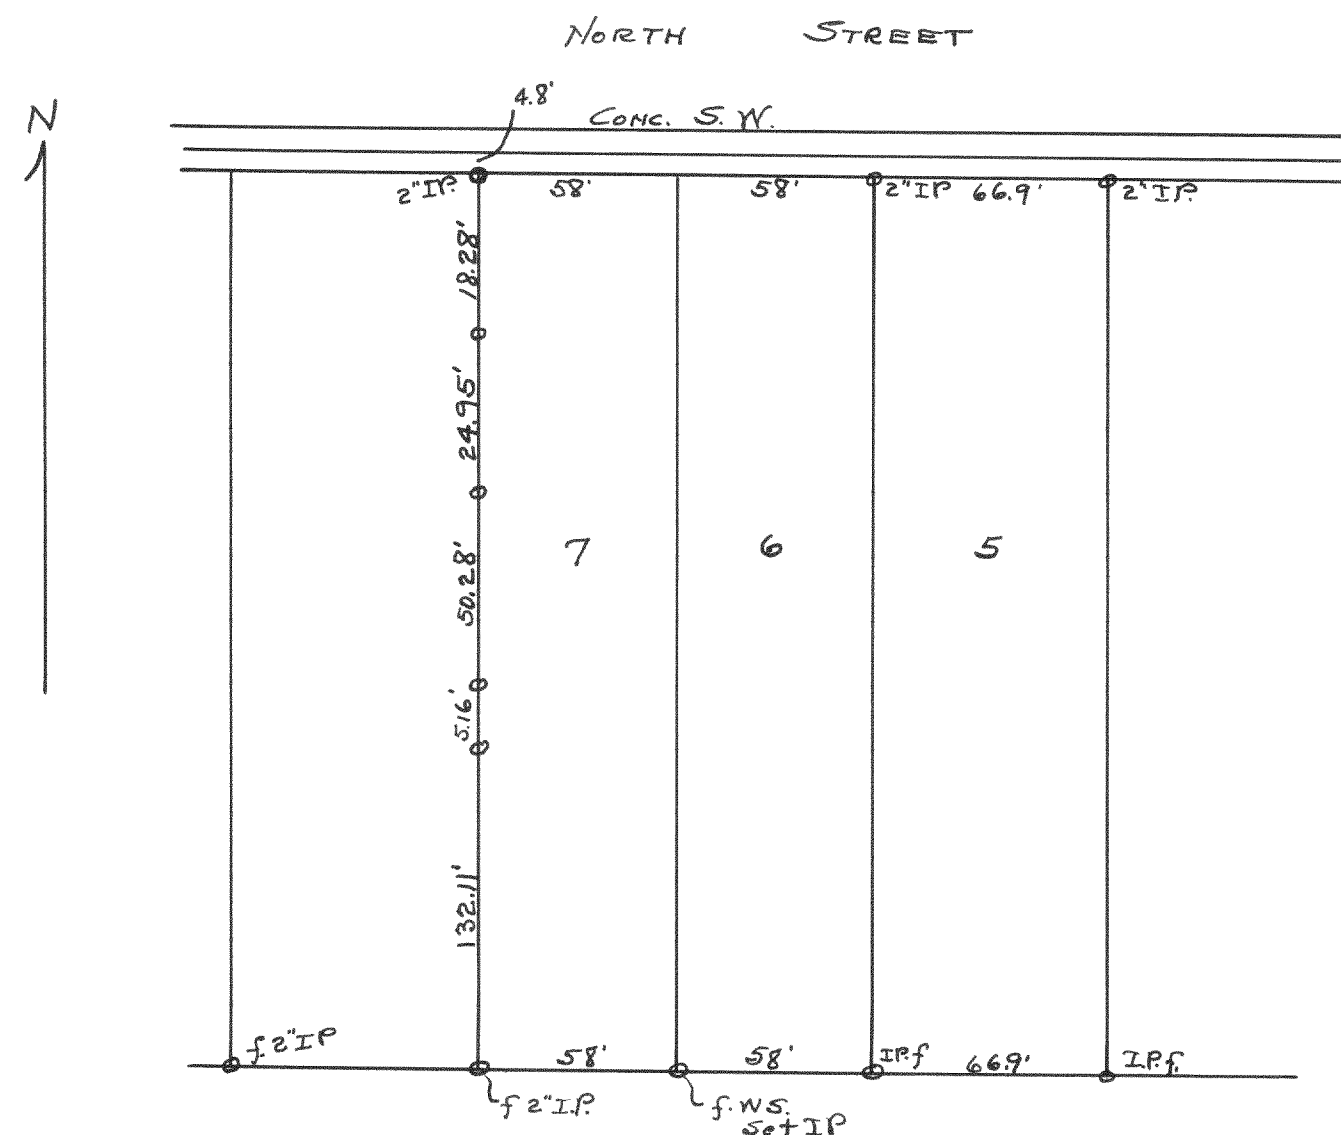


Plot of survey of the West line of Lot 7
of Fair View Subd., located in the City
of Ekham, Walworth County Wis.

July 13, 1944

Floyd S. Jensen
County Surveyor

#1494

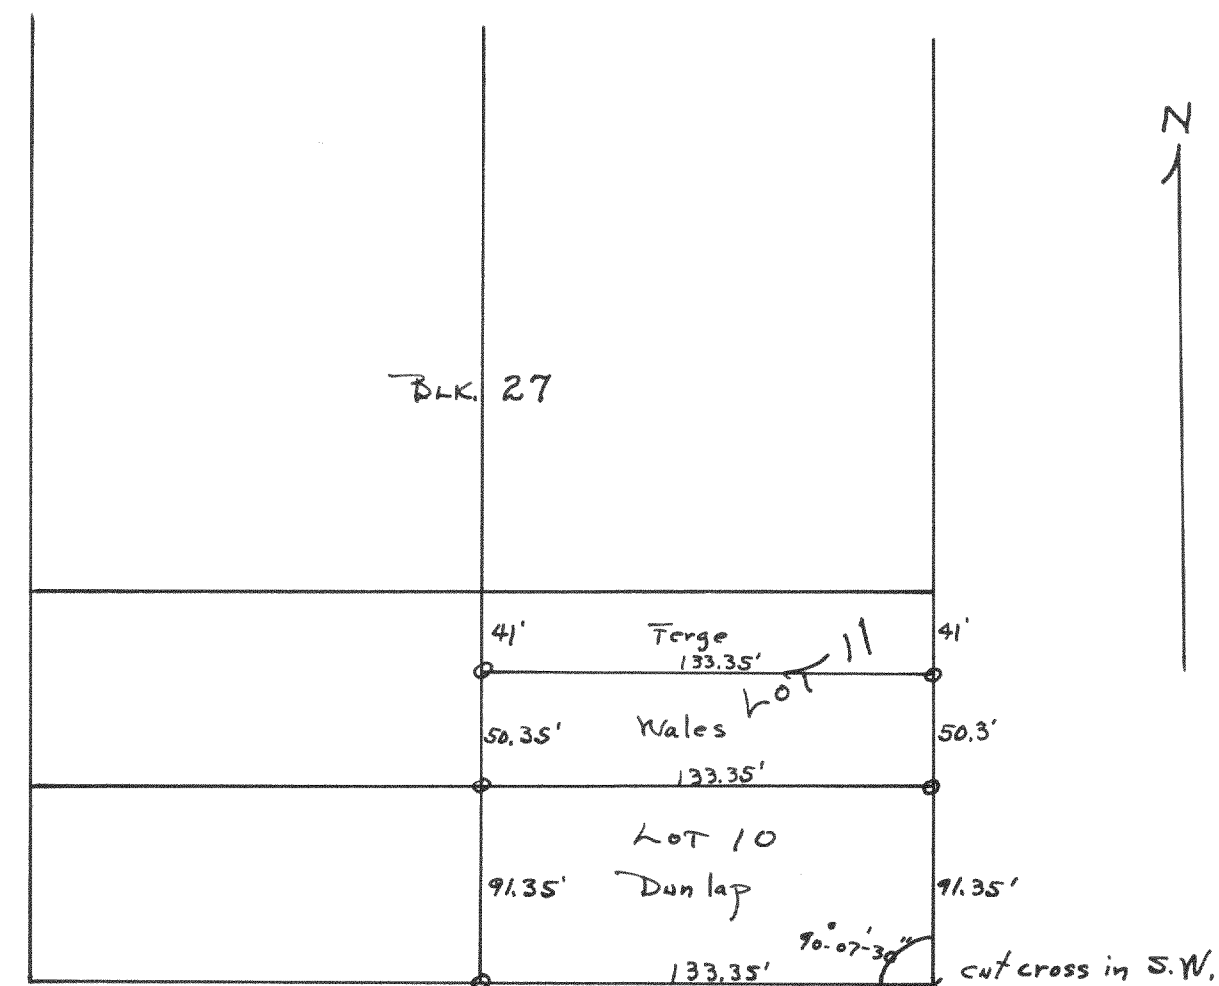

Plot of survey of Lot 10 and part of Lot 11
of Bk. 27 of The Original plat of the
City of Okhom.

June 14, 1944

Lloyd L. Jensen
County Surveyor