


#1495

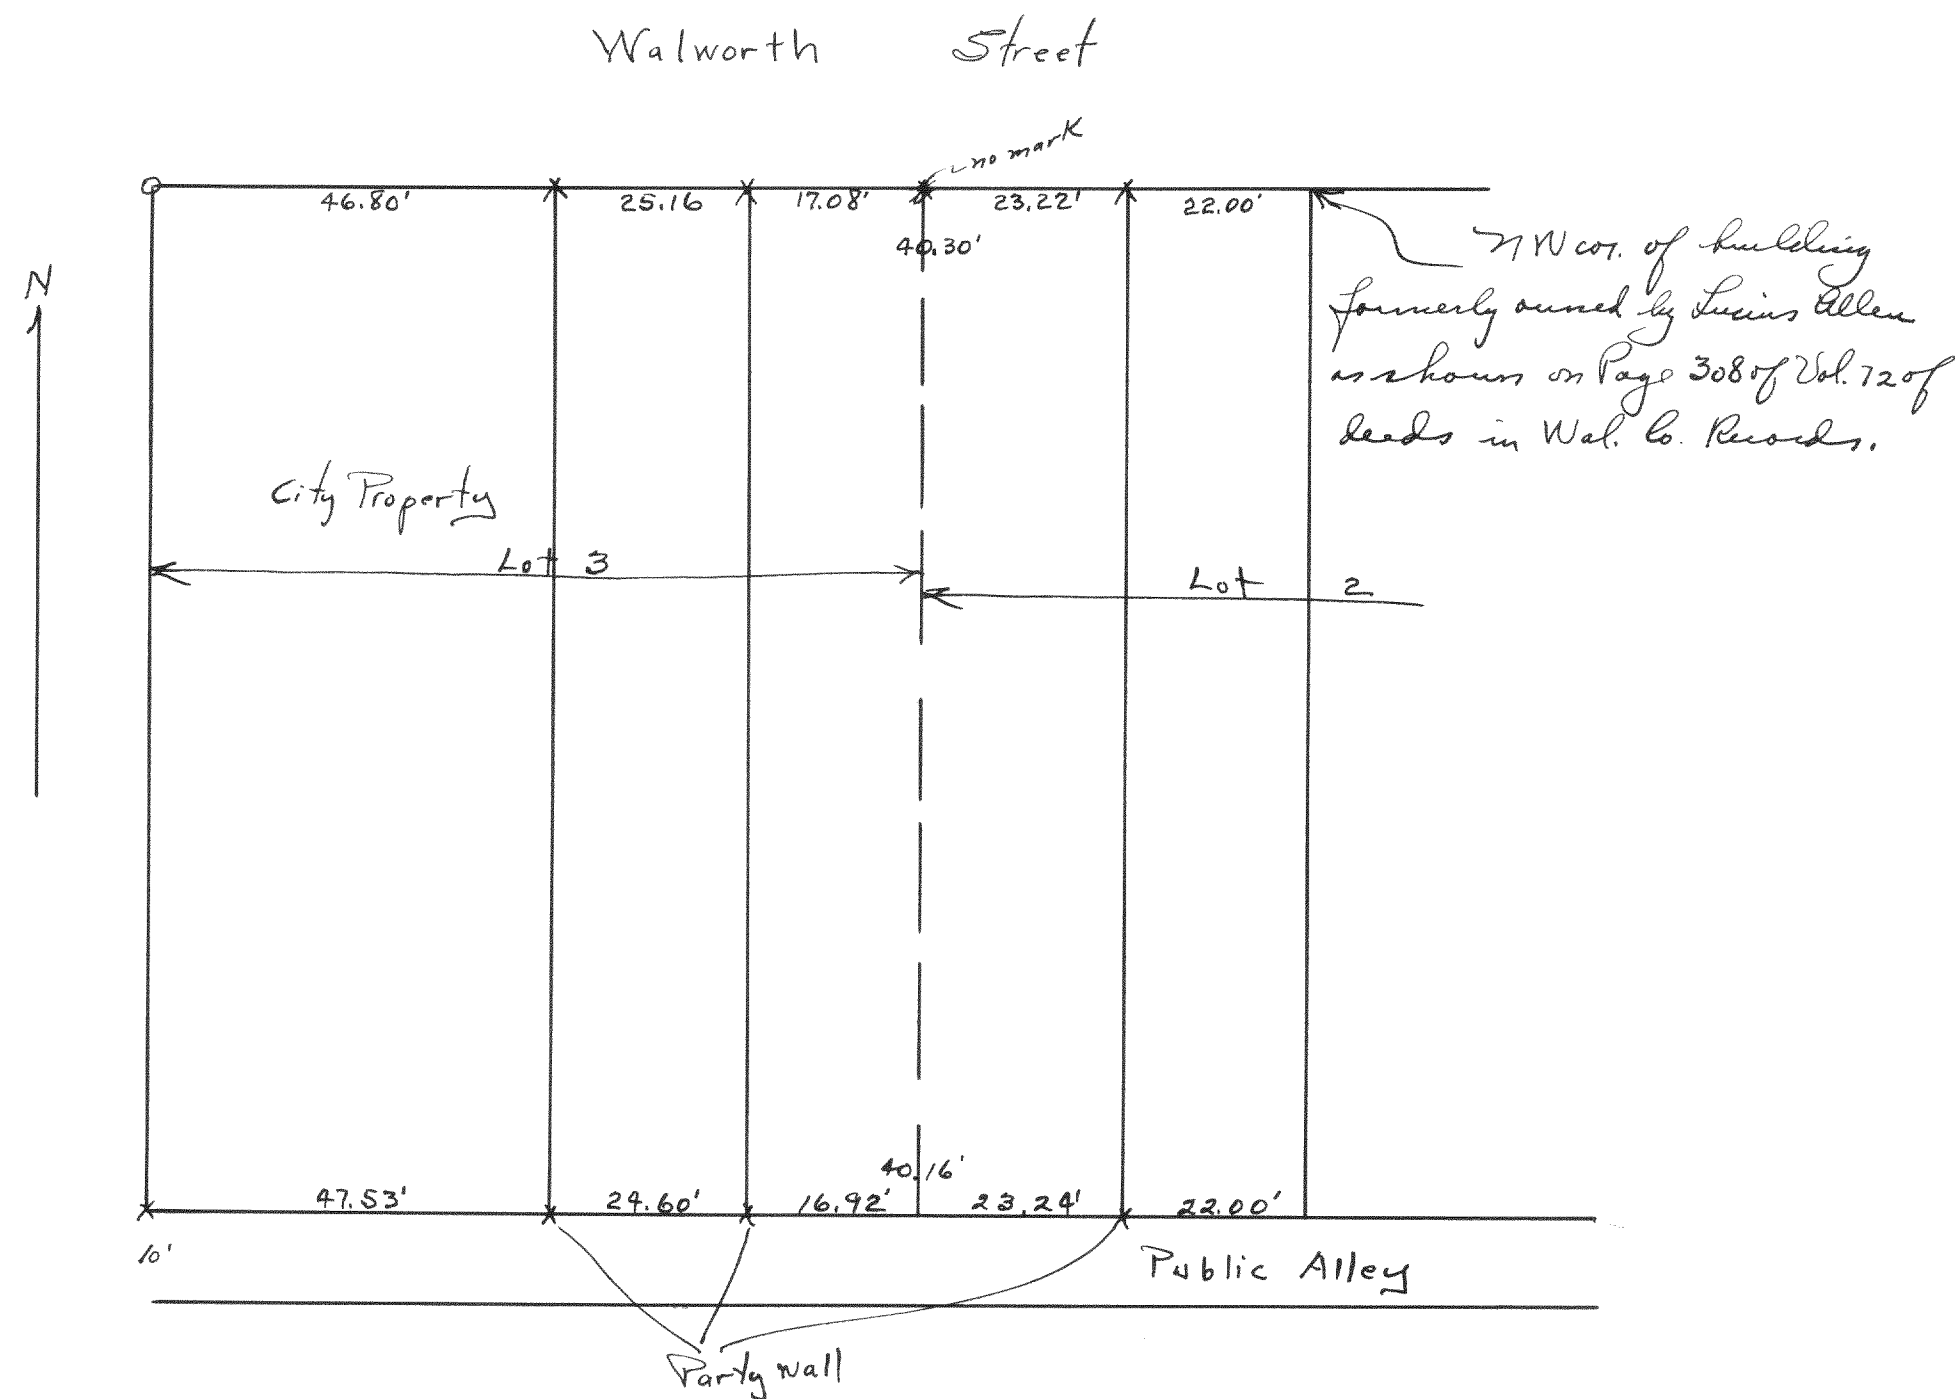


Plot of survey of part of Lot 2 and 3 of Blk. 26 of the Original plat of City of Elkhorn, Neb. Co. Wisconsin.

March 1944

Lloyd L. Jensen
County Surveyor

#1496

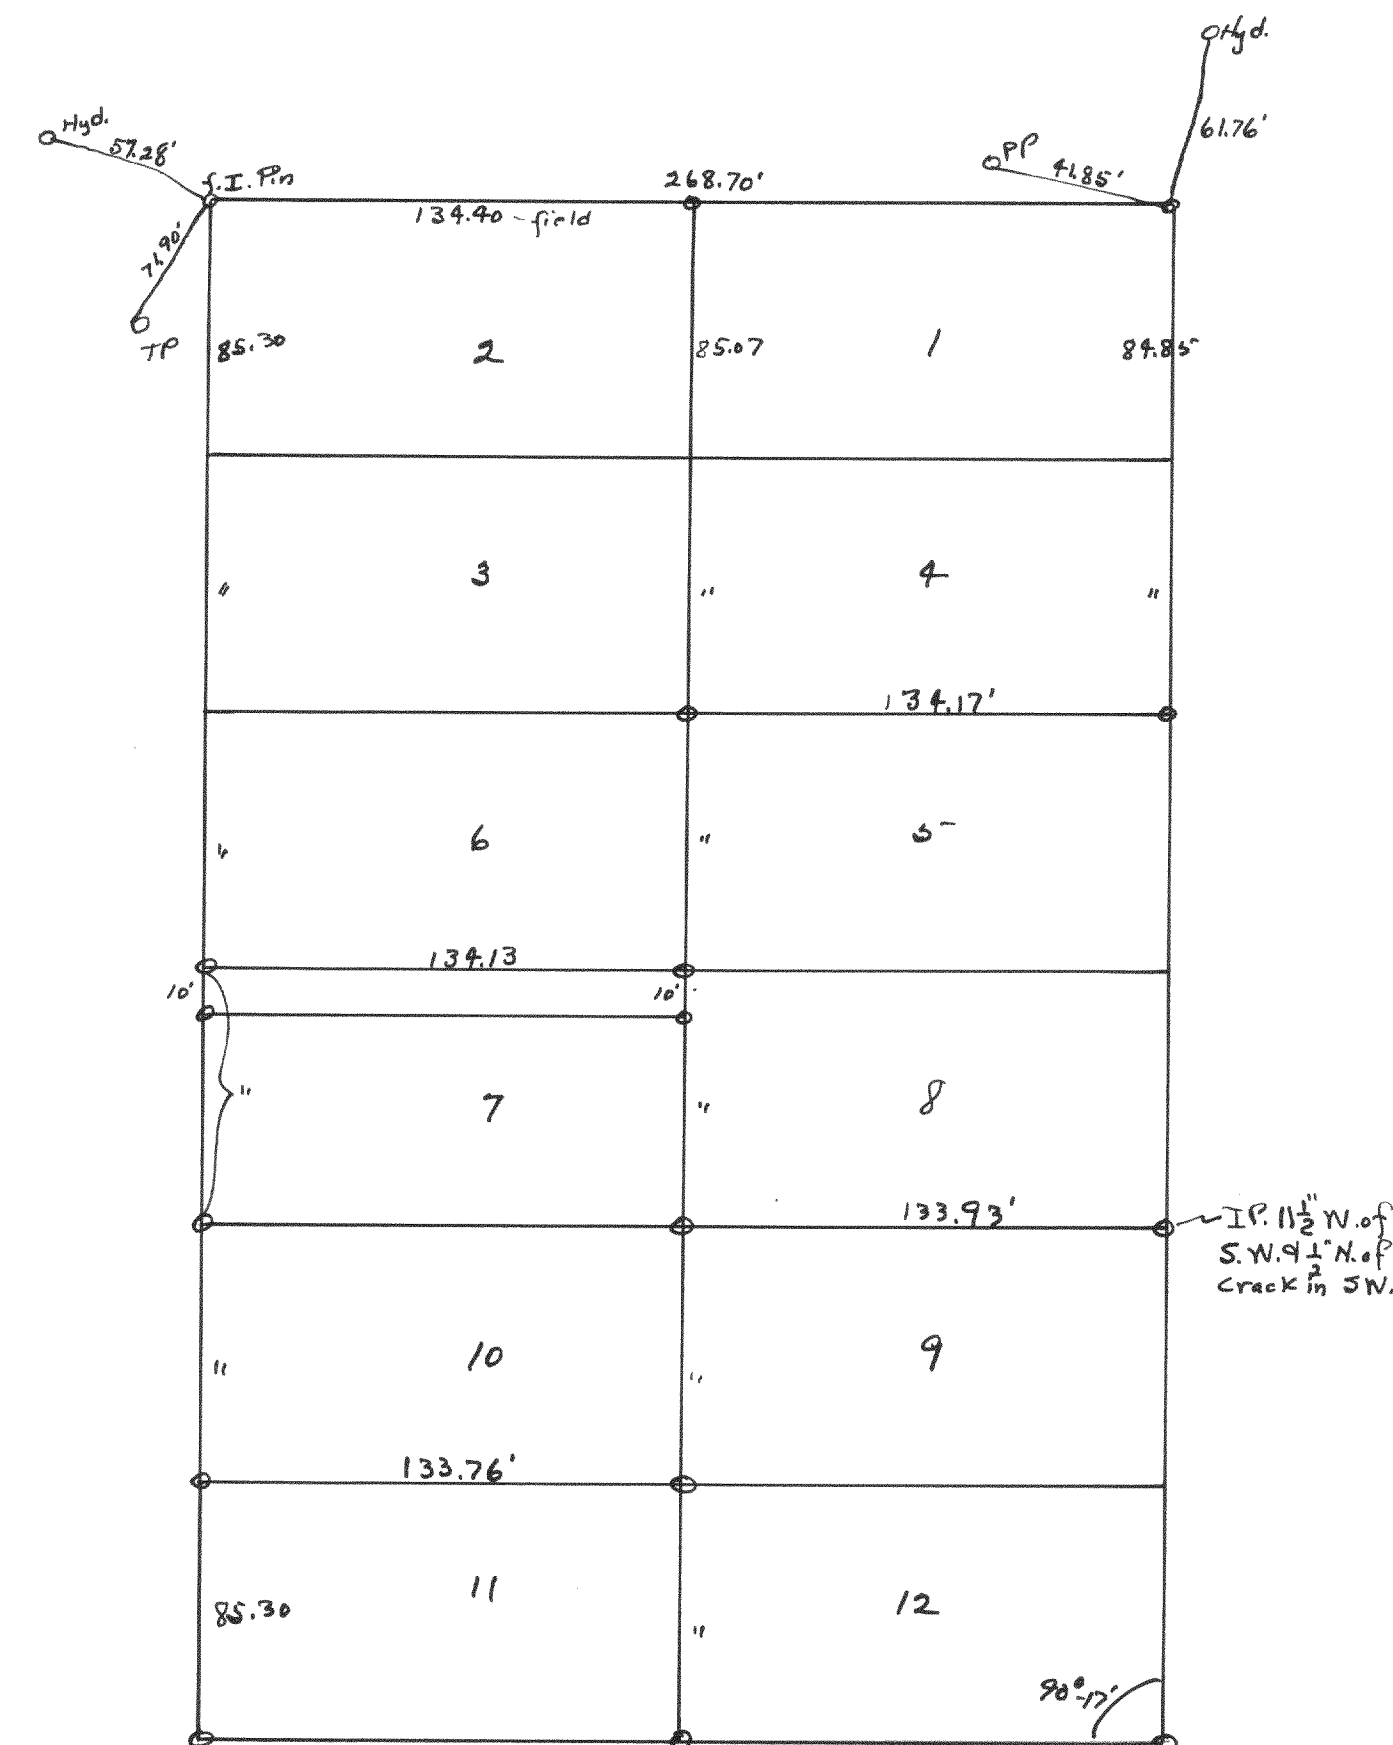

Plot of survey of Lots 5, 8, 7 and 10 of Blk. 39 of Plank Addition to The City of Elkhorn.

April 19, 1944

Lloyd L. Jensen
County Surveyor