


#1497

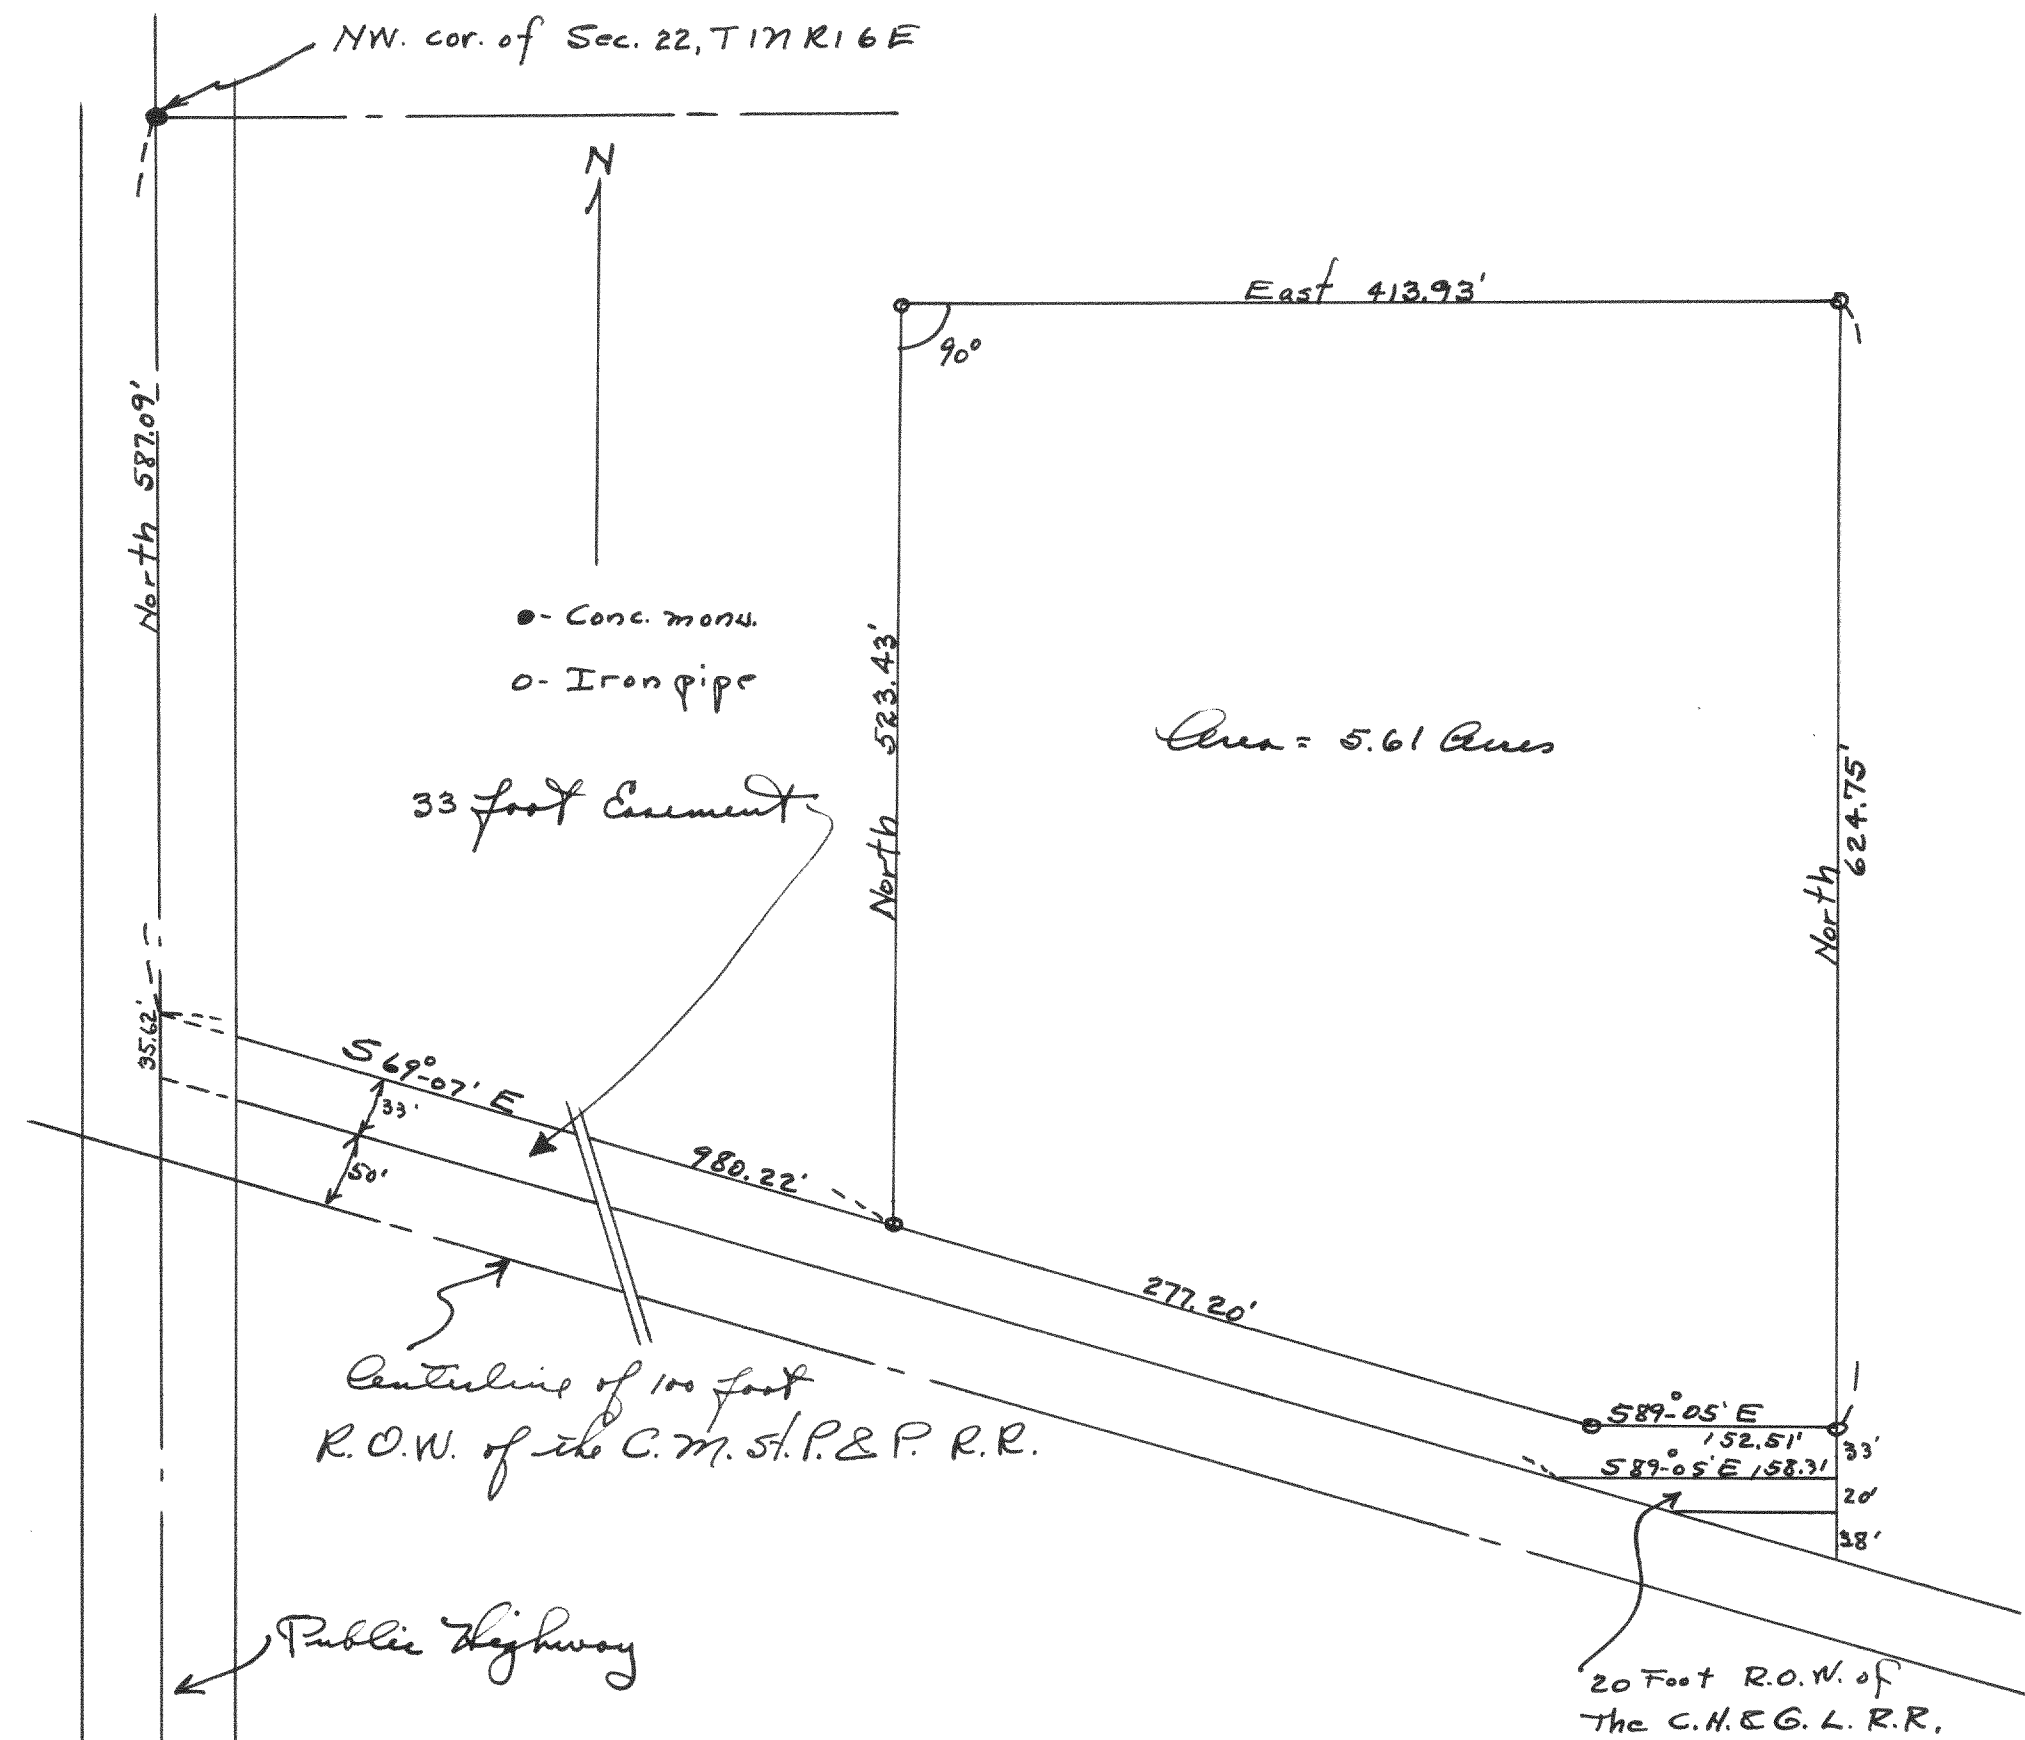


Plot of a survey of the old Hammer Mill Factory at
Waleworth Village, Walworth County Wisconsin.

March 17, 1944

Lloyd L. Jensen
County Surveyor

#1498

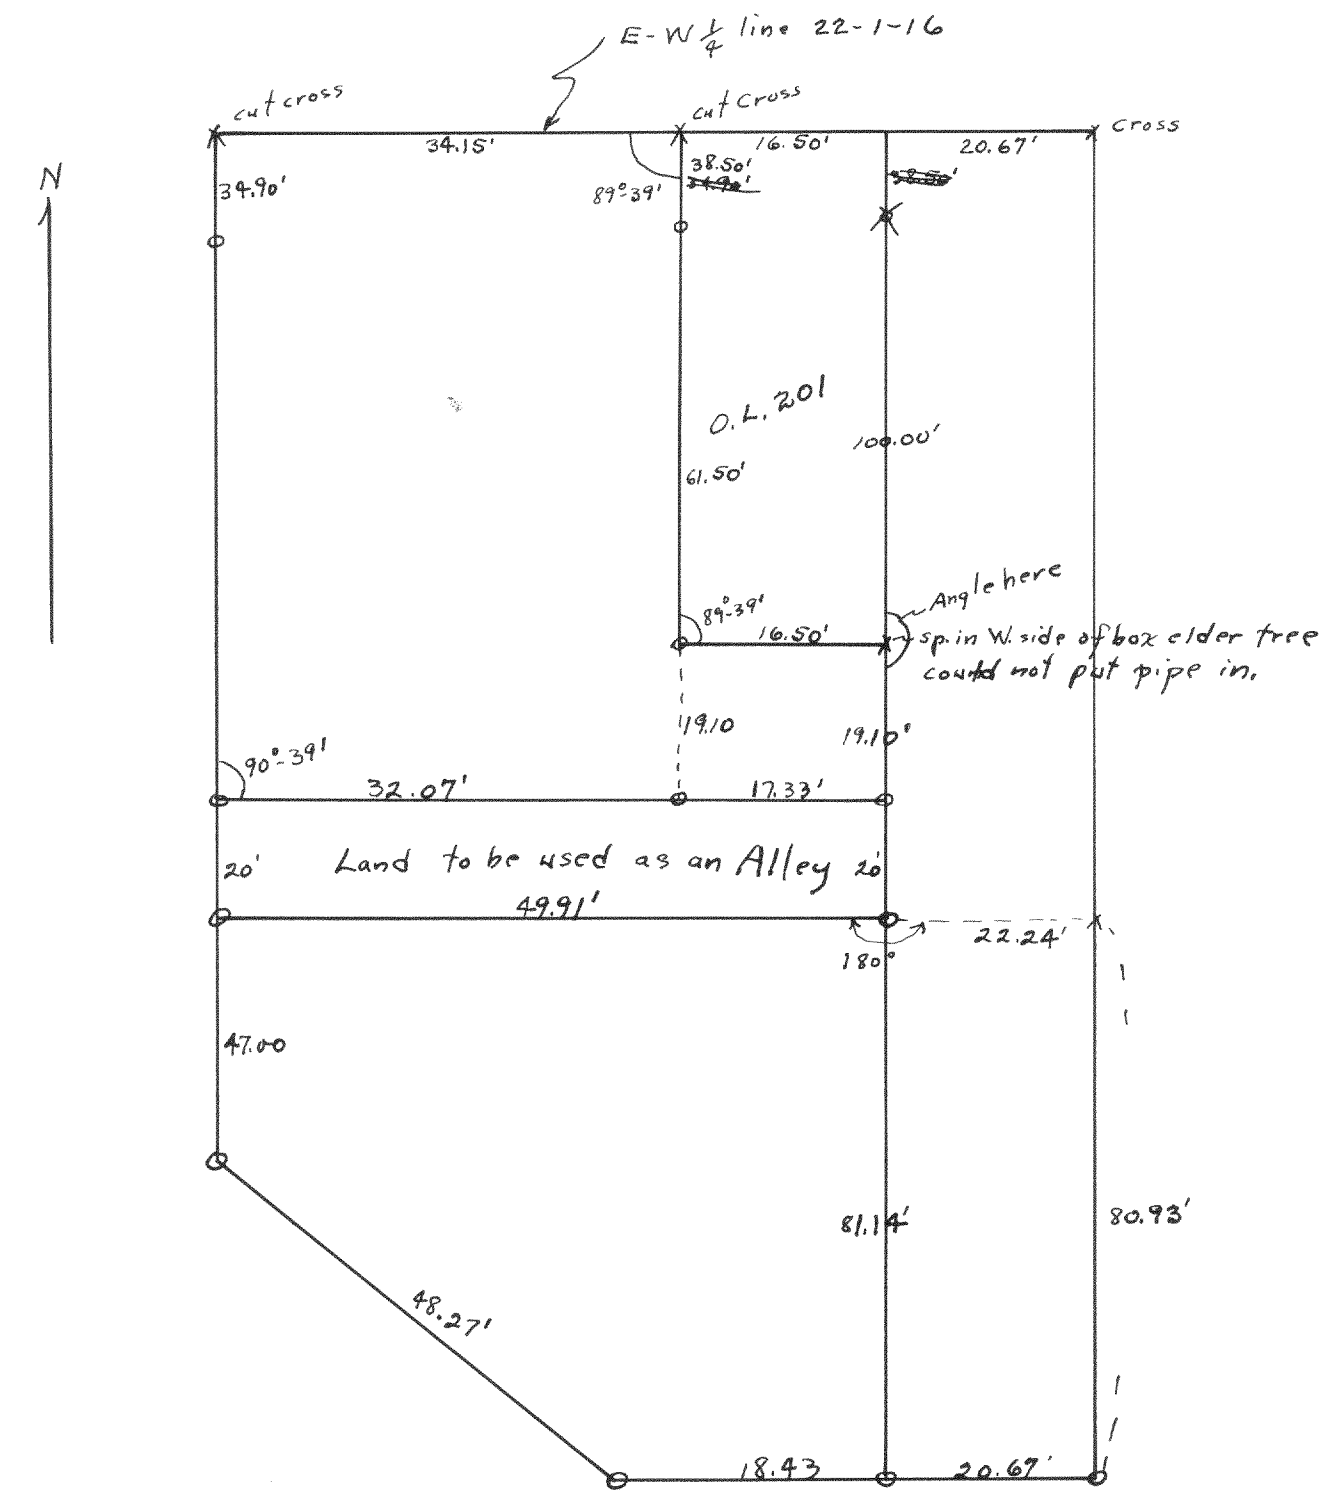

Plot of survey of part of O.L. #200
of the Currier's Plot to the
Village of Fort Walworth.

June 24, 1944

Lloyd L. Jensen
County Surveyor