


#1499

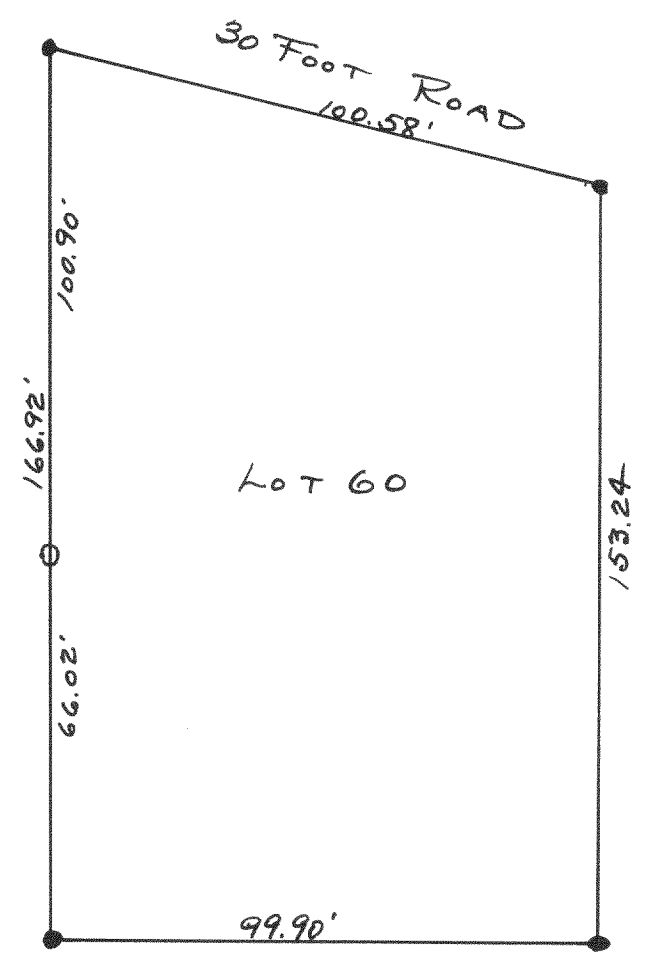


● - Conc. monu.
○ - Iron pipe

Plot of survey of Lot 60 of Unit No. 2
of Country Club Estates, located in
Fontana Wisconsin.

Aug. 8, 1944

Lloyd L. Jensen
County Surveyor

#1500

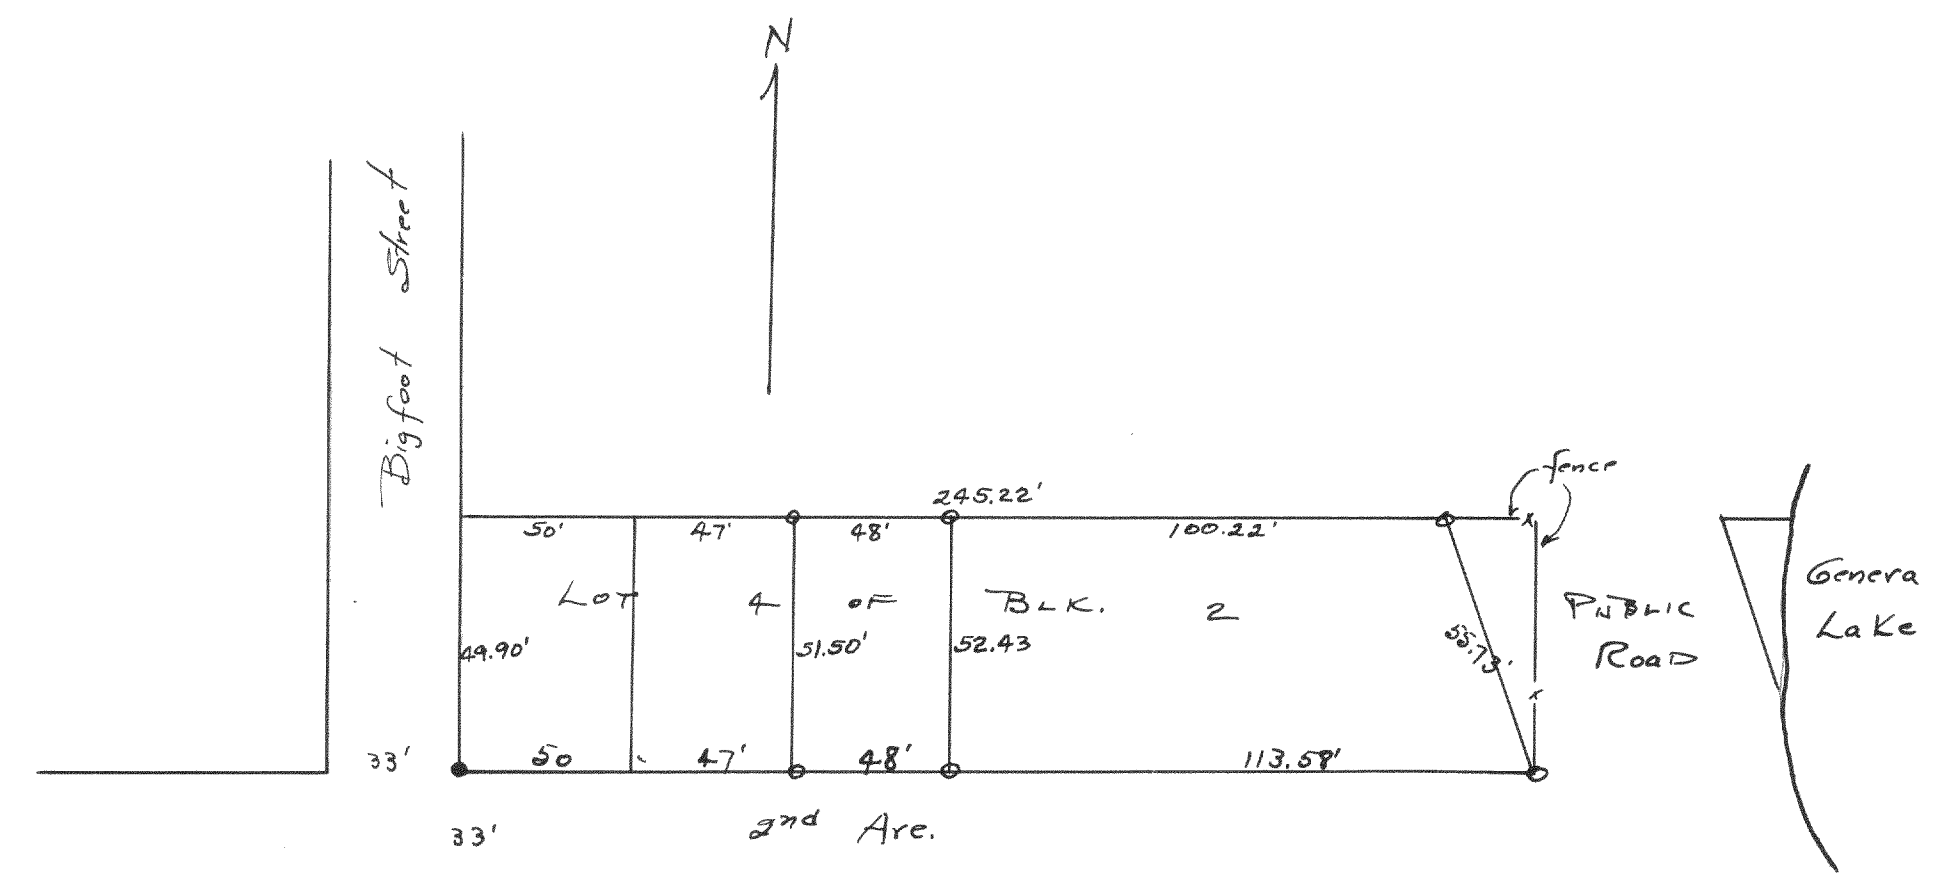

Plot of survey of part of Lot 4 of
Blk. 2 of D. G. Reid's Add. to
Reid's Park, Fontana Wisconsin.

June 16, 1944

Lloyd L. Jensen
County Surveyor