


#1501

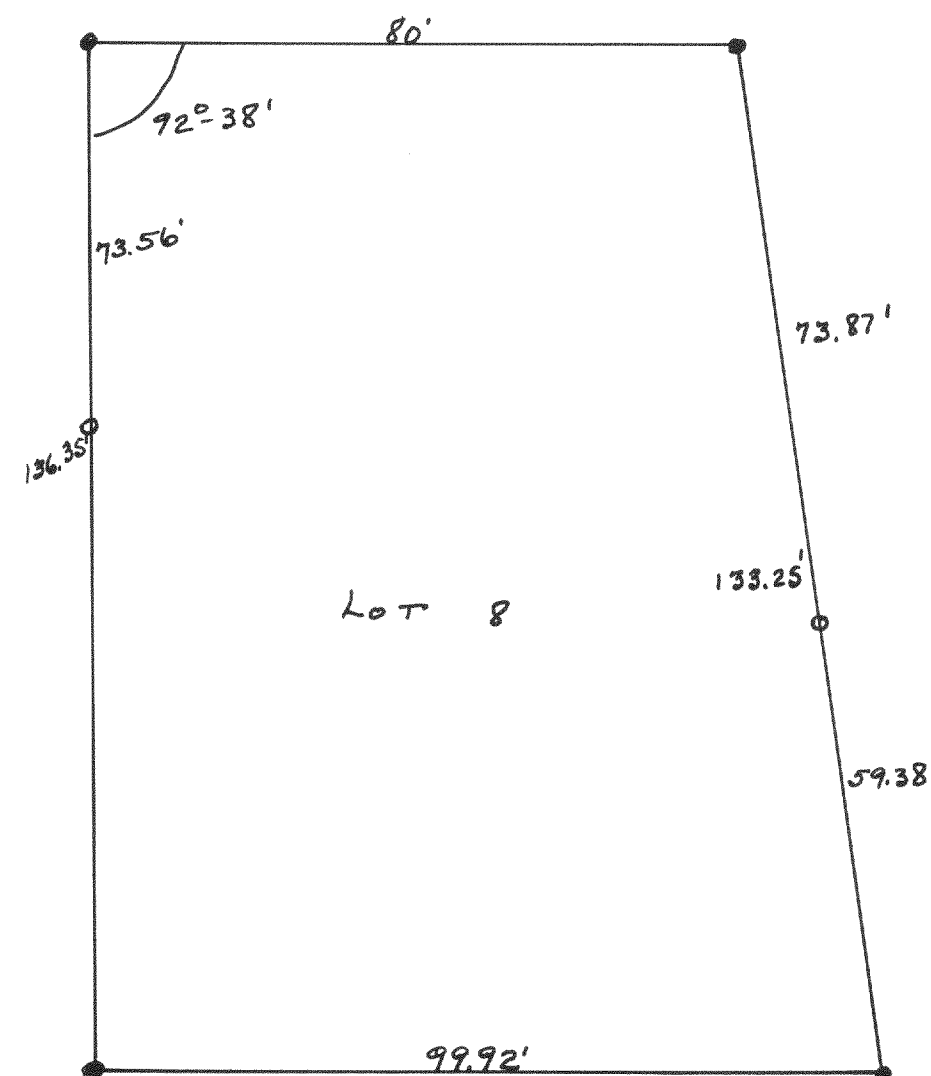


Plot of survey of Lot 8 of Bk. D
of Unit 3 of County Club Estates,
located in the Village of Fontana.

June 18, 1944

Lloyd L. Jensen
County Surveyor

~~#~~1502

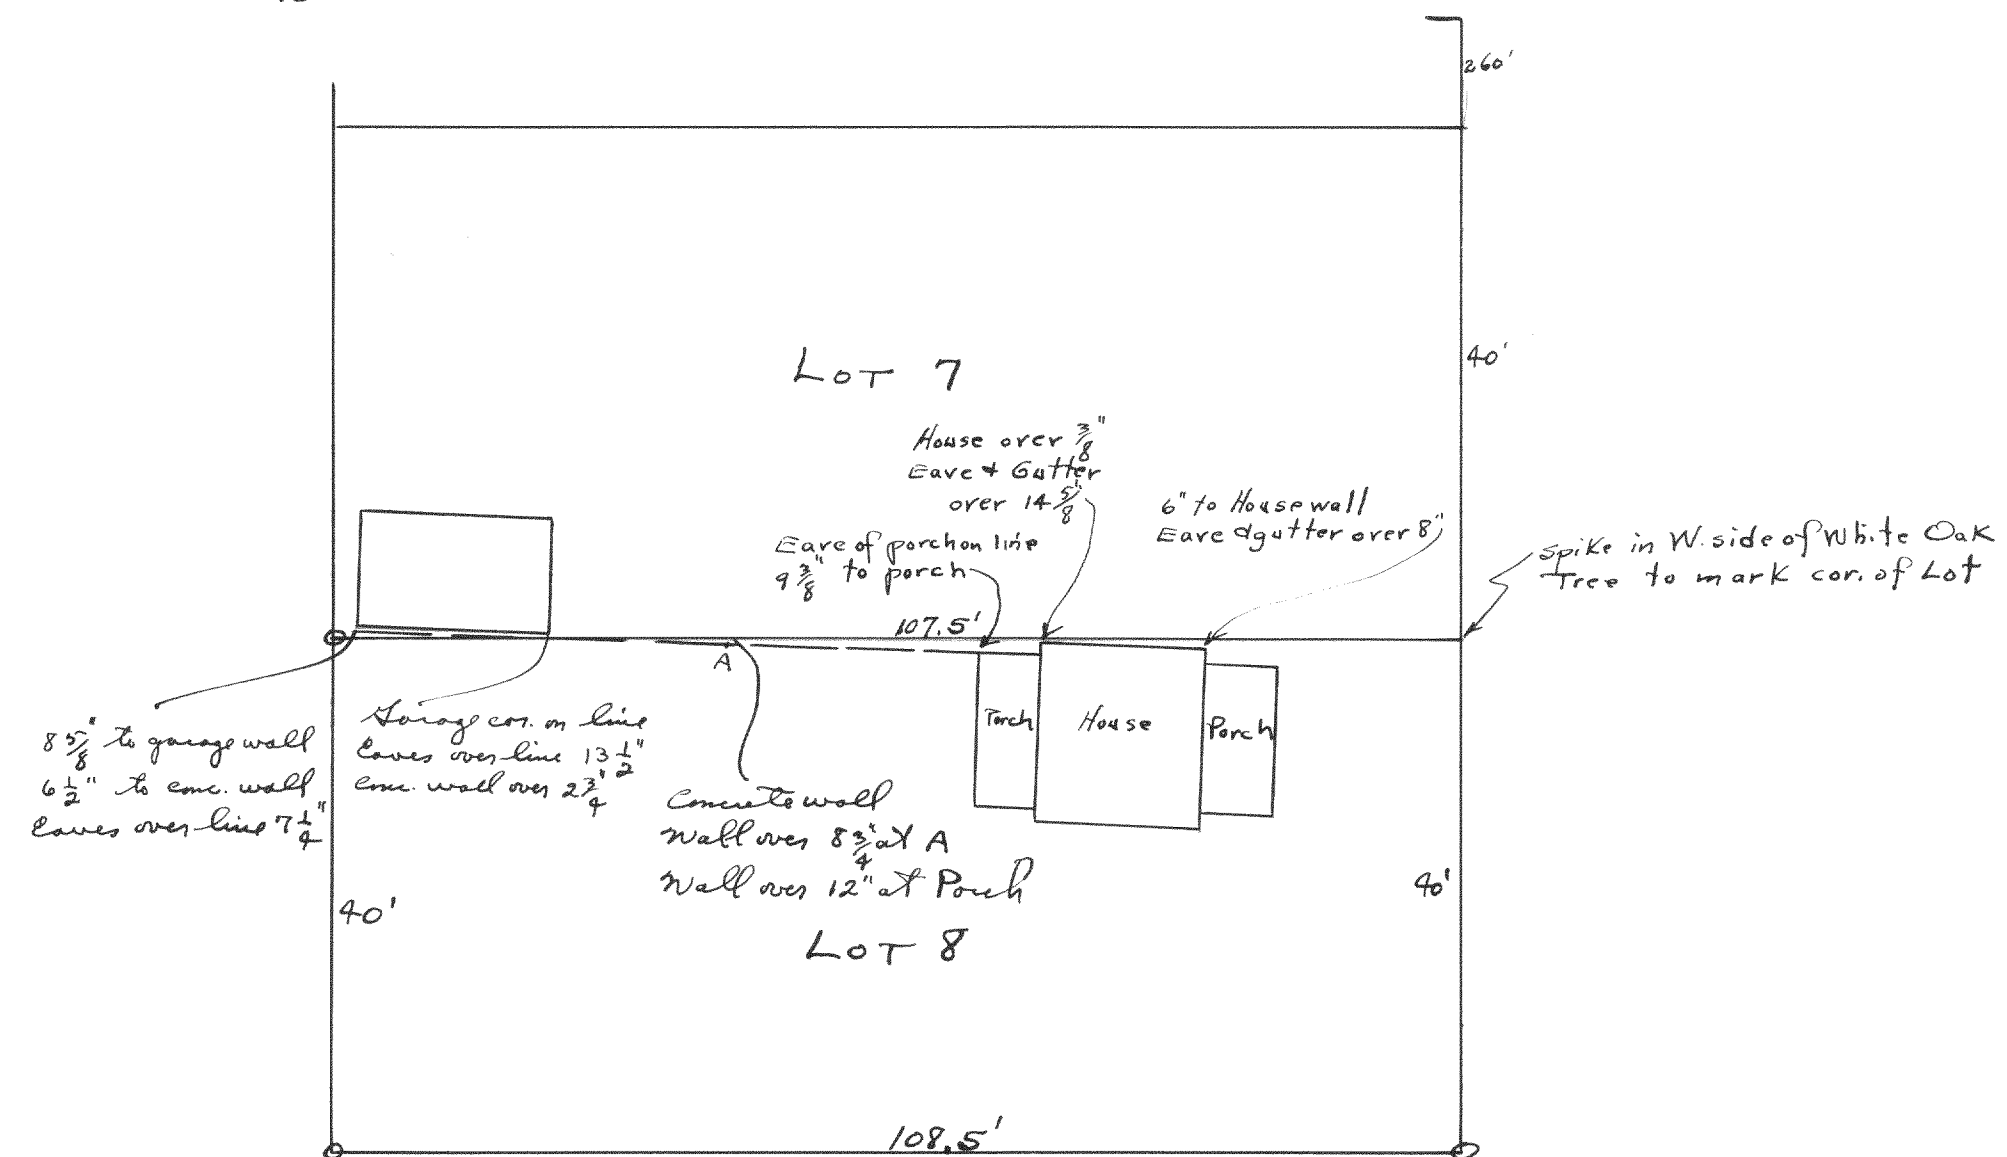

Plot of survey of the line between Lot 7 and 8
of Bk. 4 of D. G. Reid's Addition to Reid's Park,
located in Fontana Wisconsin.

April 1944

Flagd Jensen
County Surveyor