


#1503

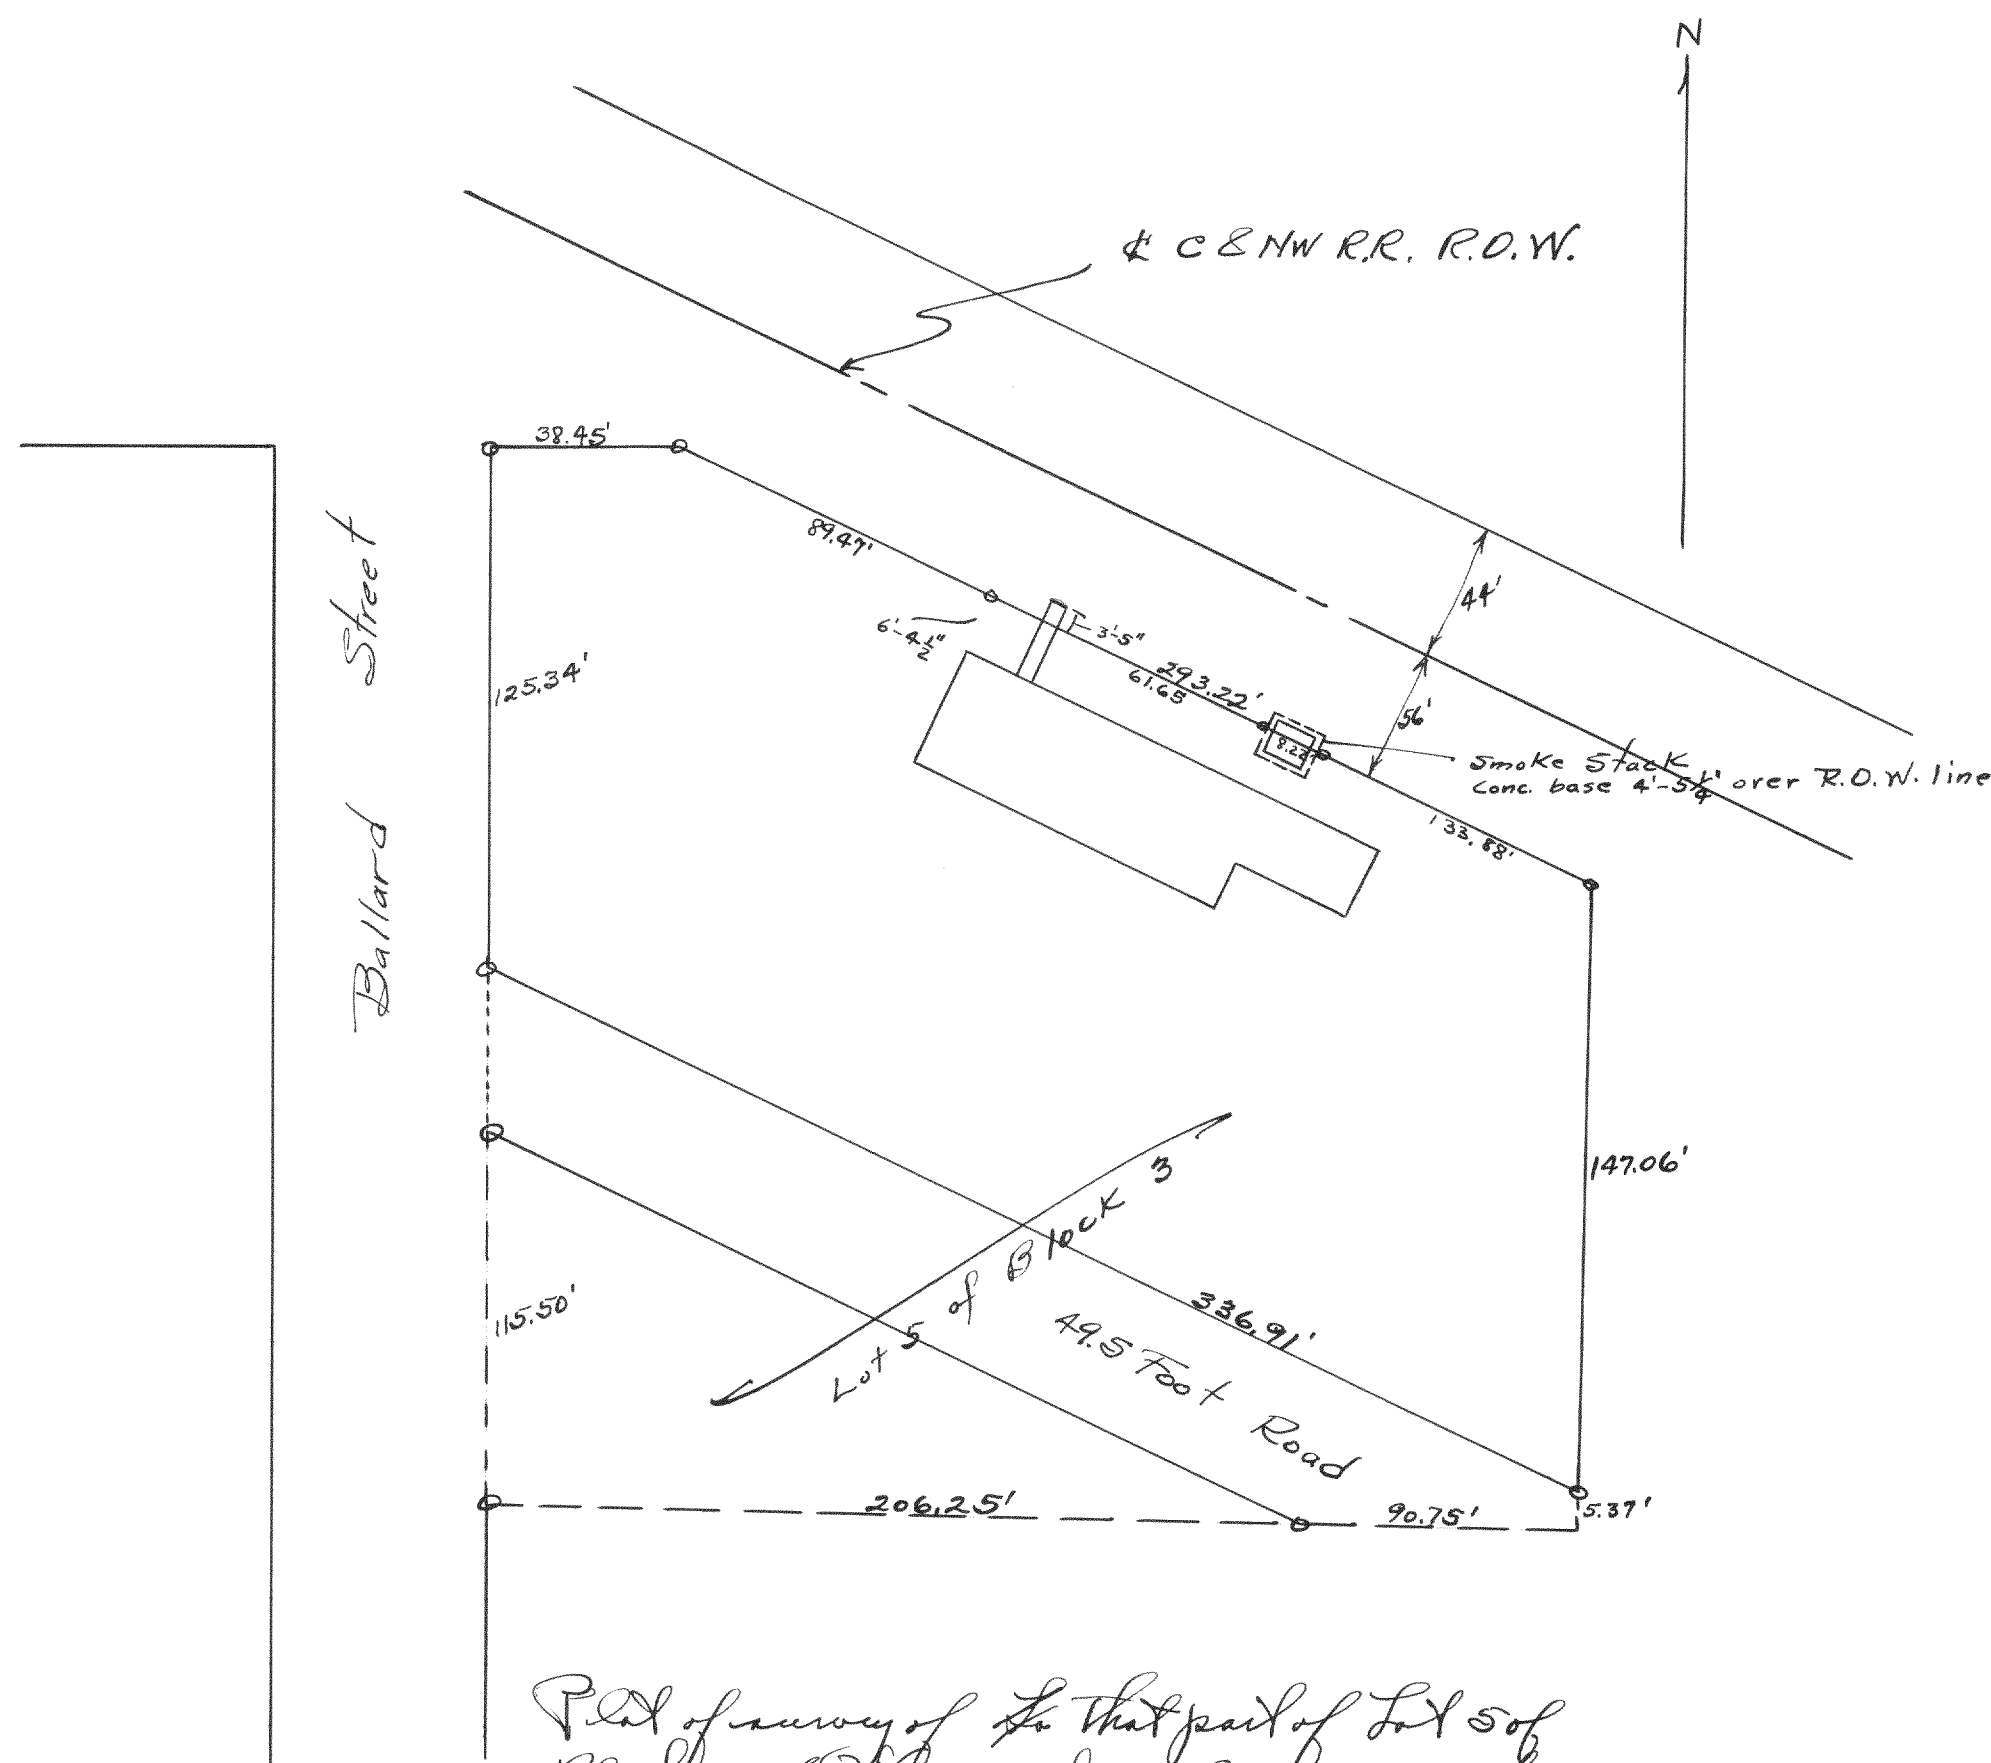


Plot of survey of that part of Lot 5 of Block 3 of Wise and Nelsons South Side Addition to The Village of Sharon, Walworth County Wisconsin.

May 25, 1944

Lloyd S. Jensen
County Surveyor

#1504

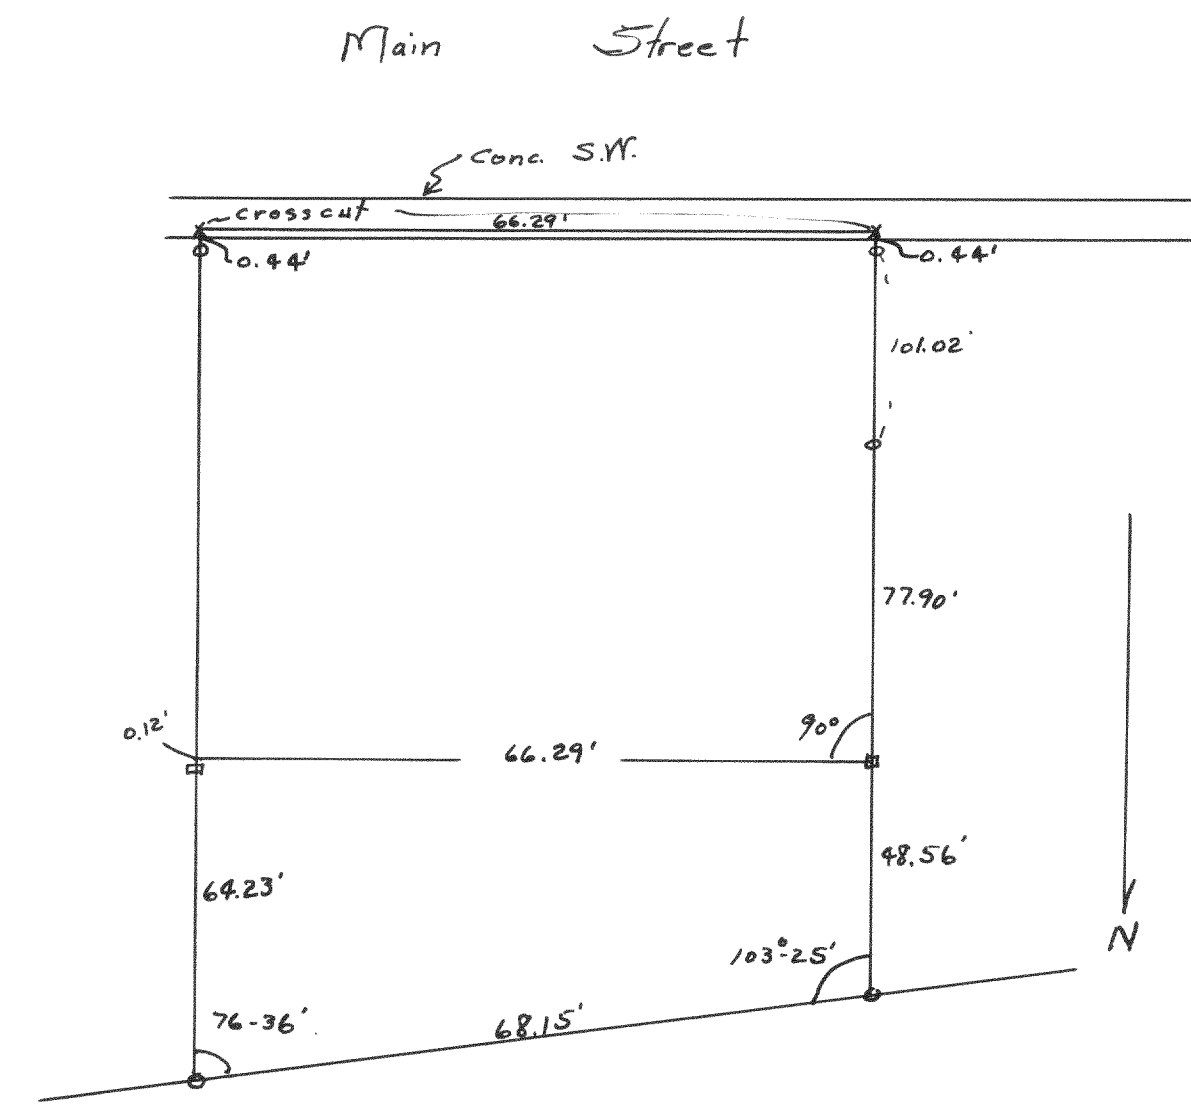

Plot of survey of Lot 2 of Block 3 of the Original Plat of the City of Whitewater.

March 1941

Lloyd S. Jensen
County Surveyor