


#1505

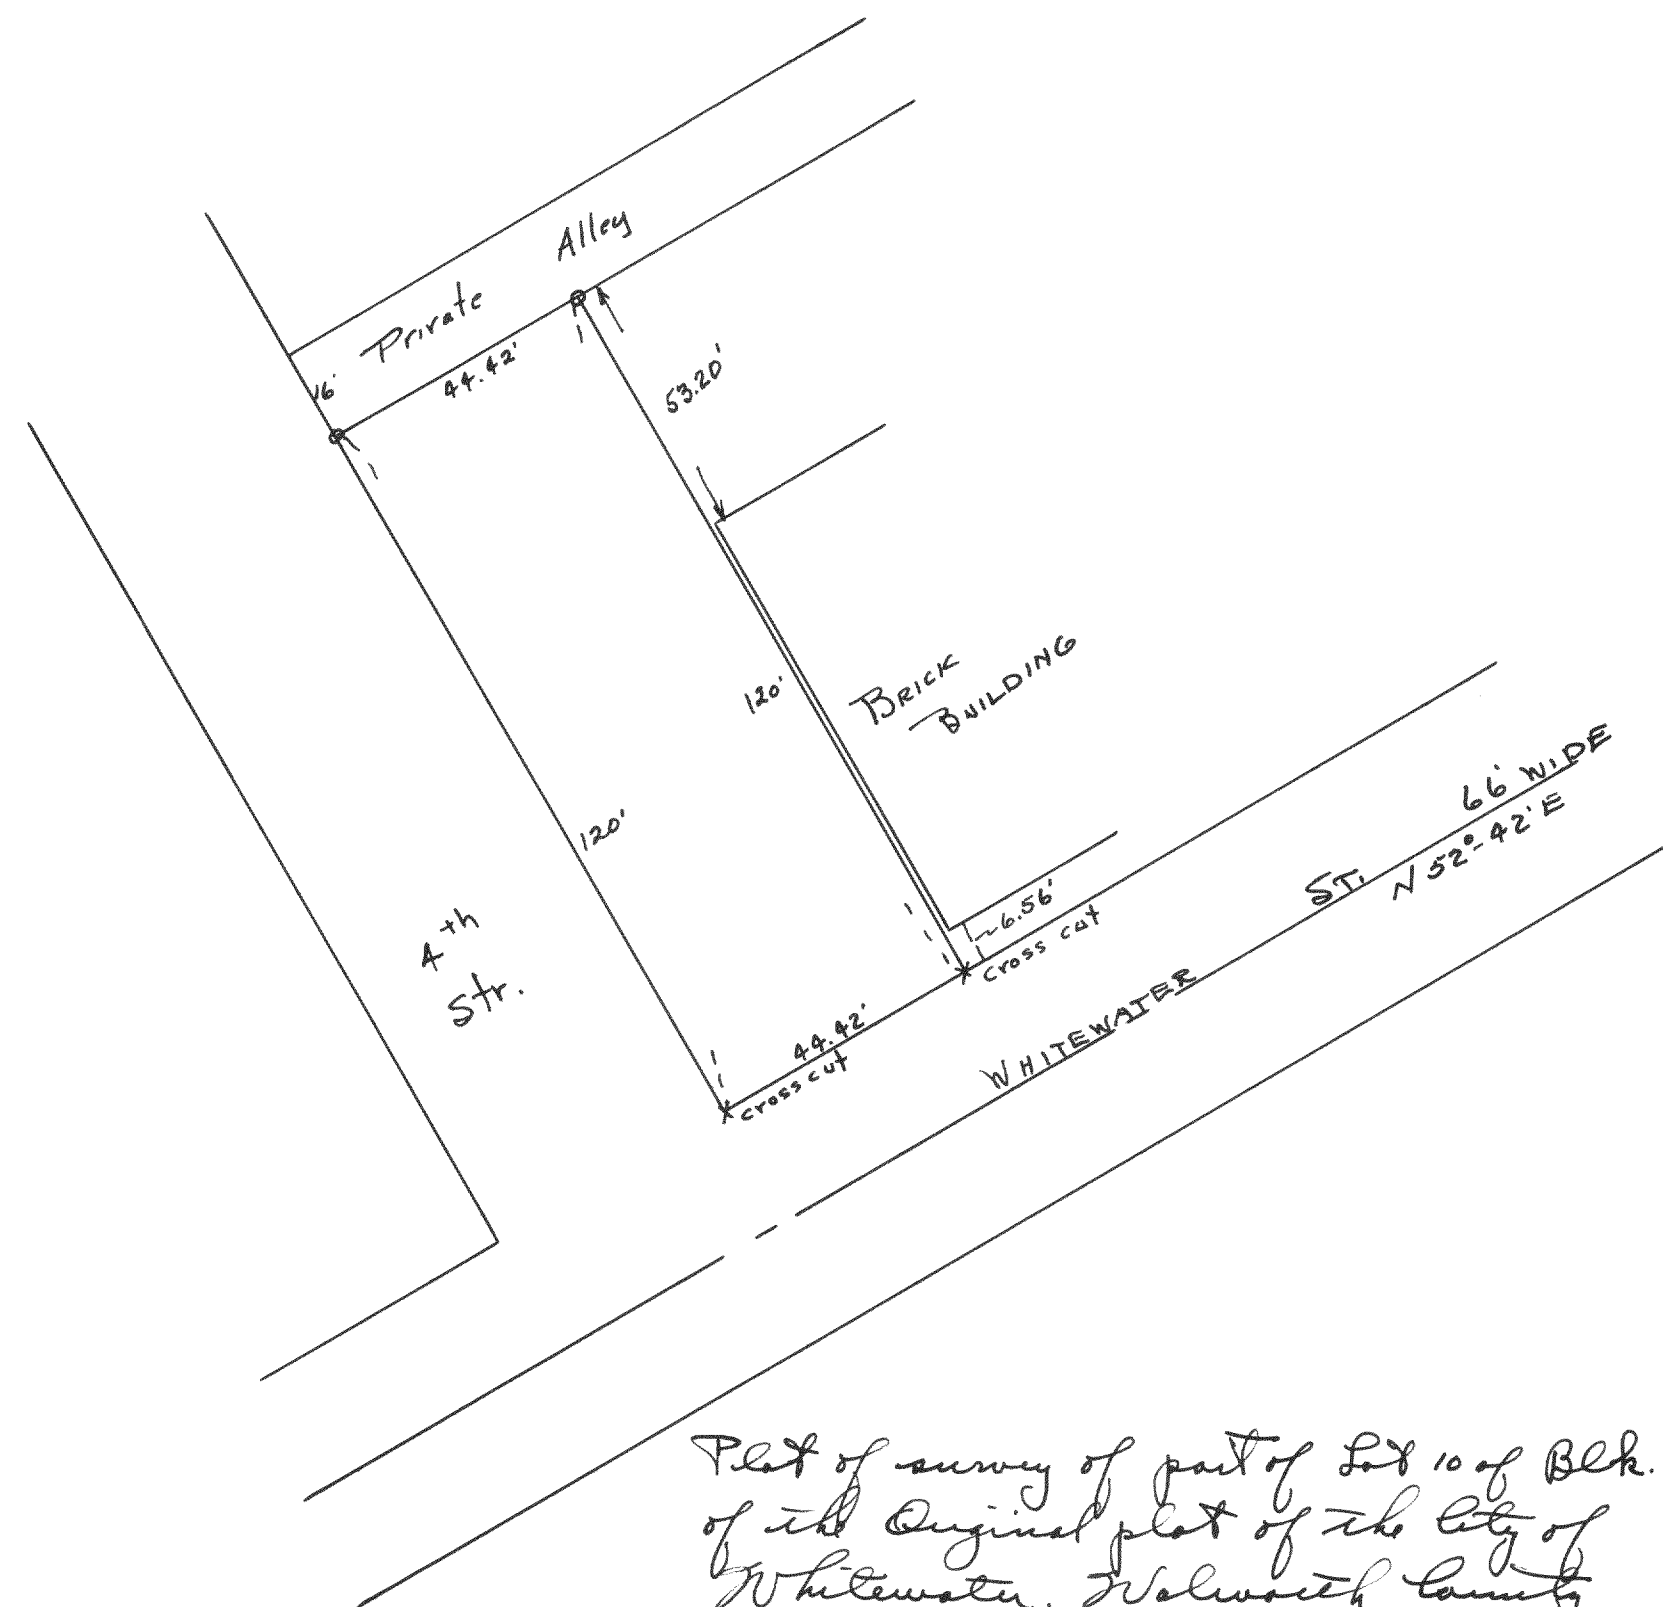


Plot of survey of part of Lot 10 of Blk. 14  
of the Original plot of the City of  
Whitewater, Walworth County  
Wisconsin.

March 21, 1944

Lloyd L. Jensen  
County Surveyor

#1506

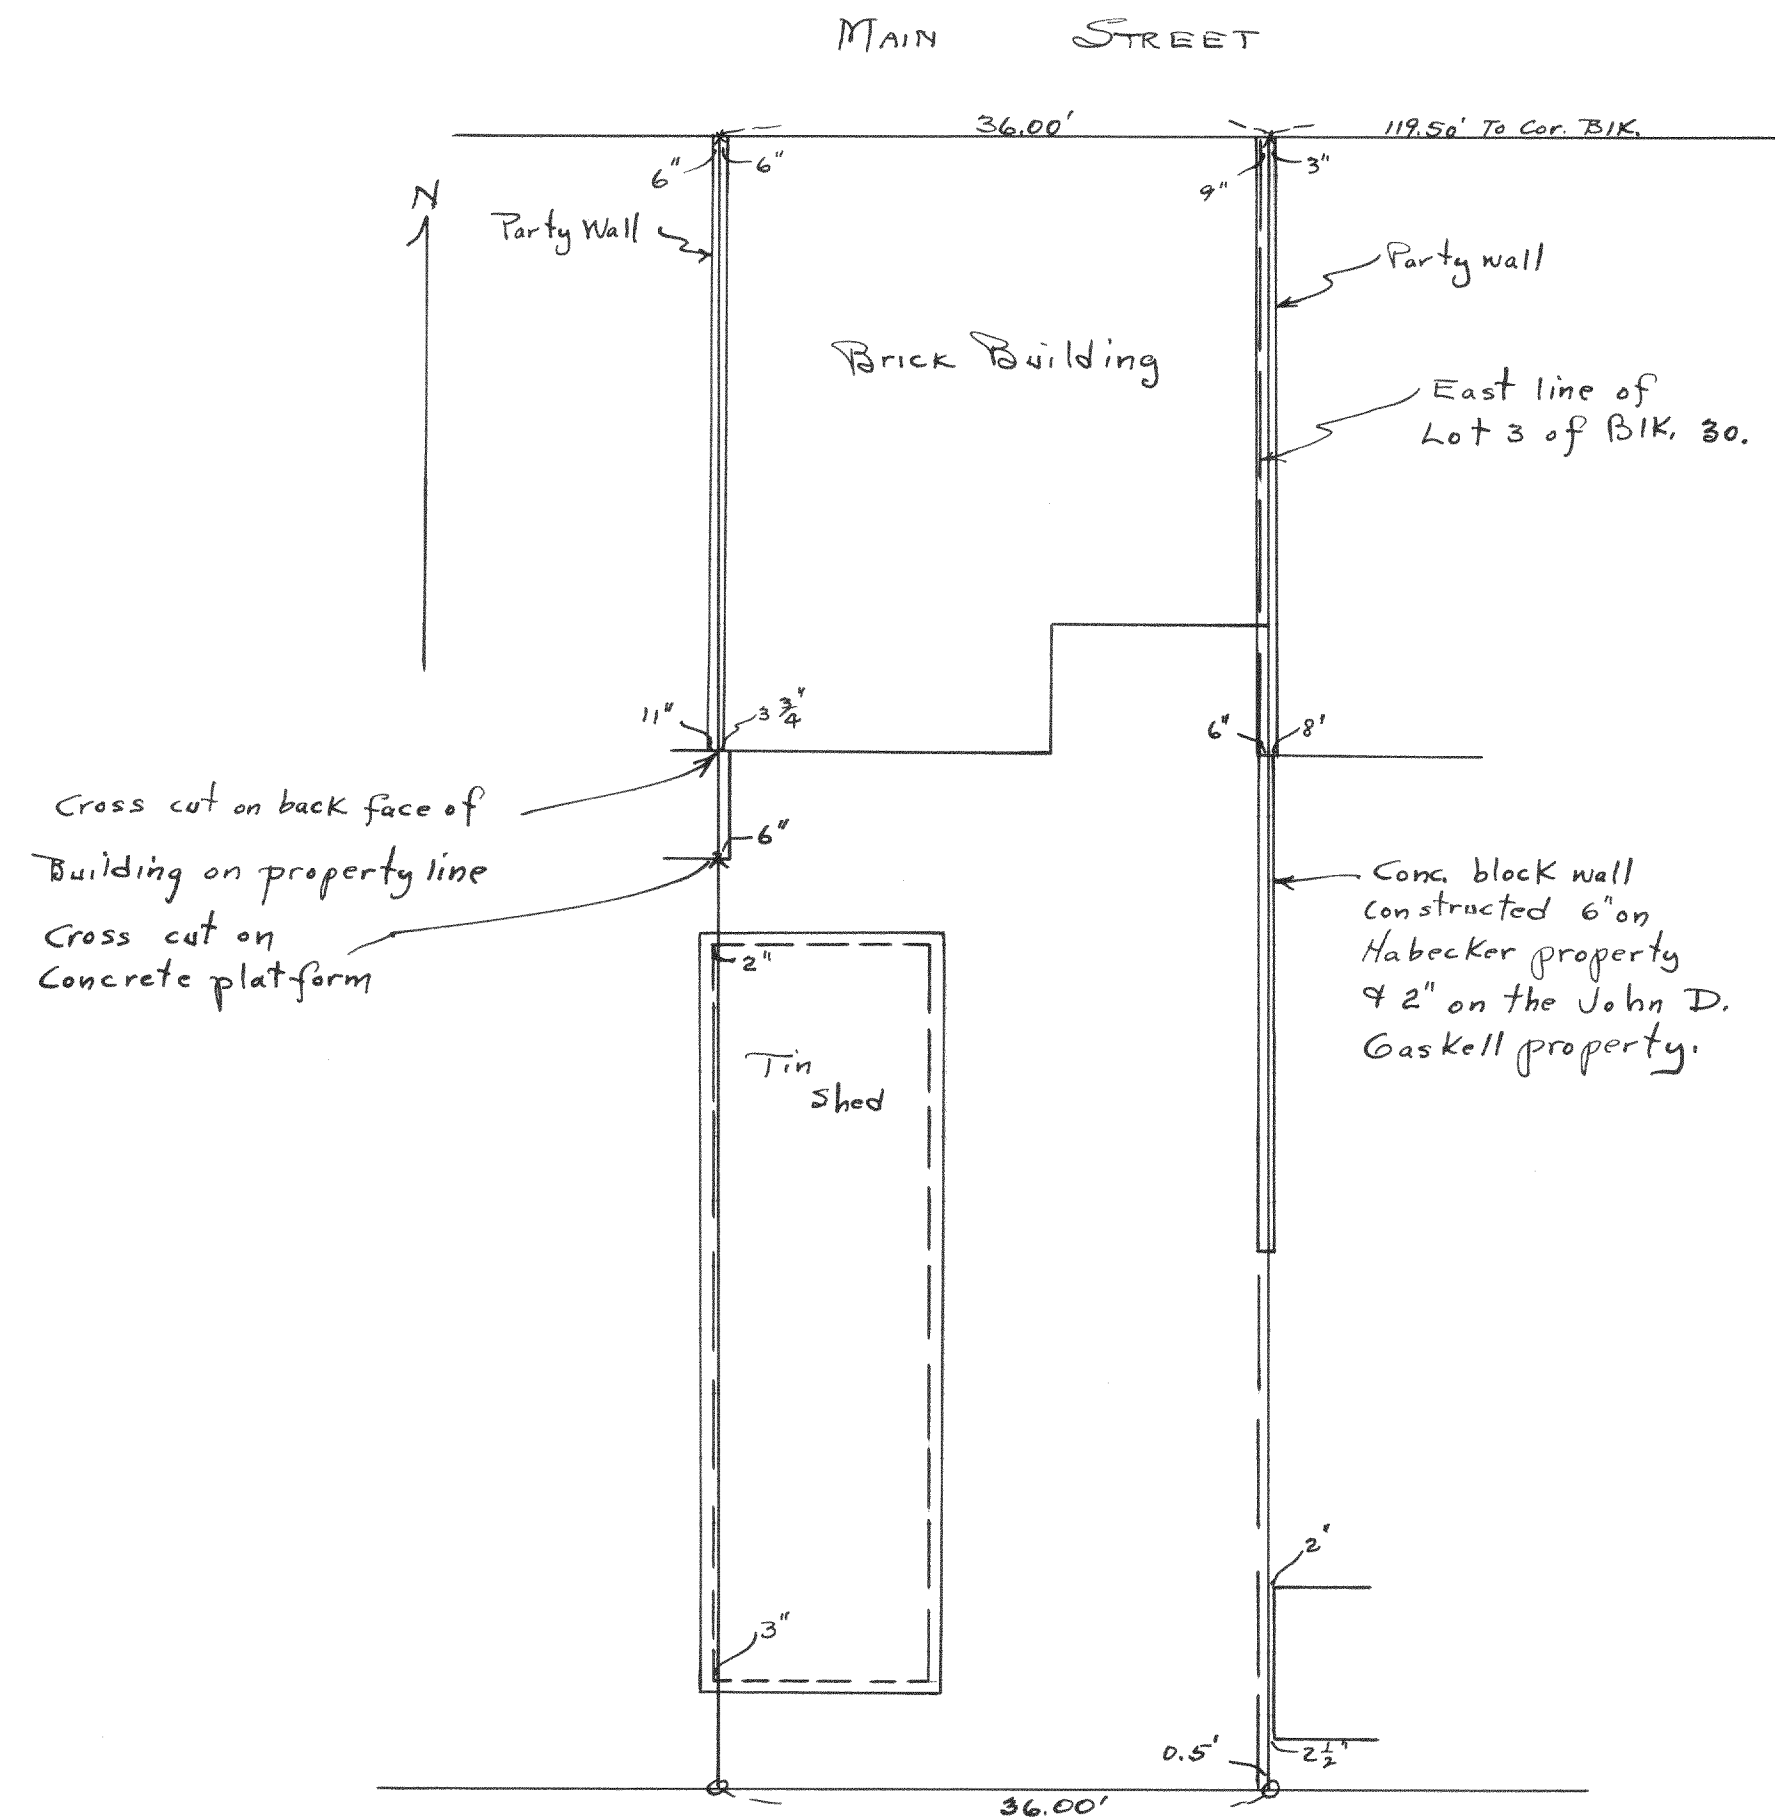

Plot of survey of part of Lots 2 and 3 of  
Block 30 of the Original Plot of the  
City of Lake Geneva, Walworth  
County Wisconsin.

Sept. 1944

Lloyd L. Jensen  
County Surveyor