


#1507

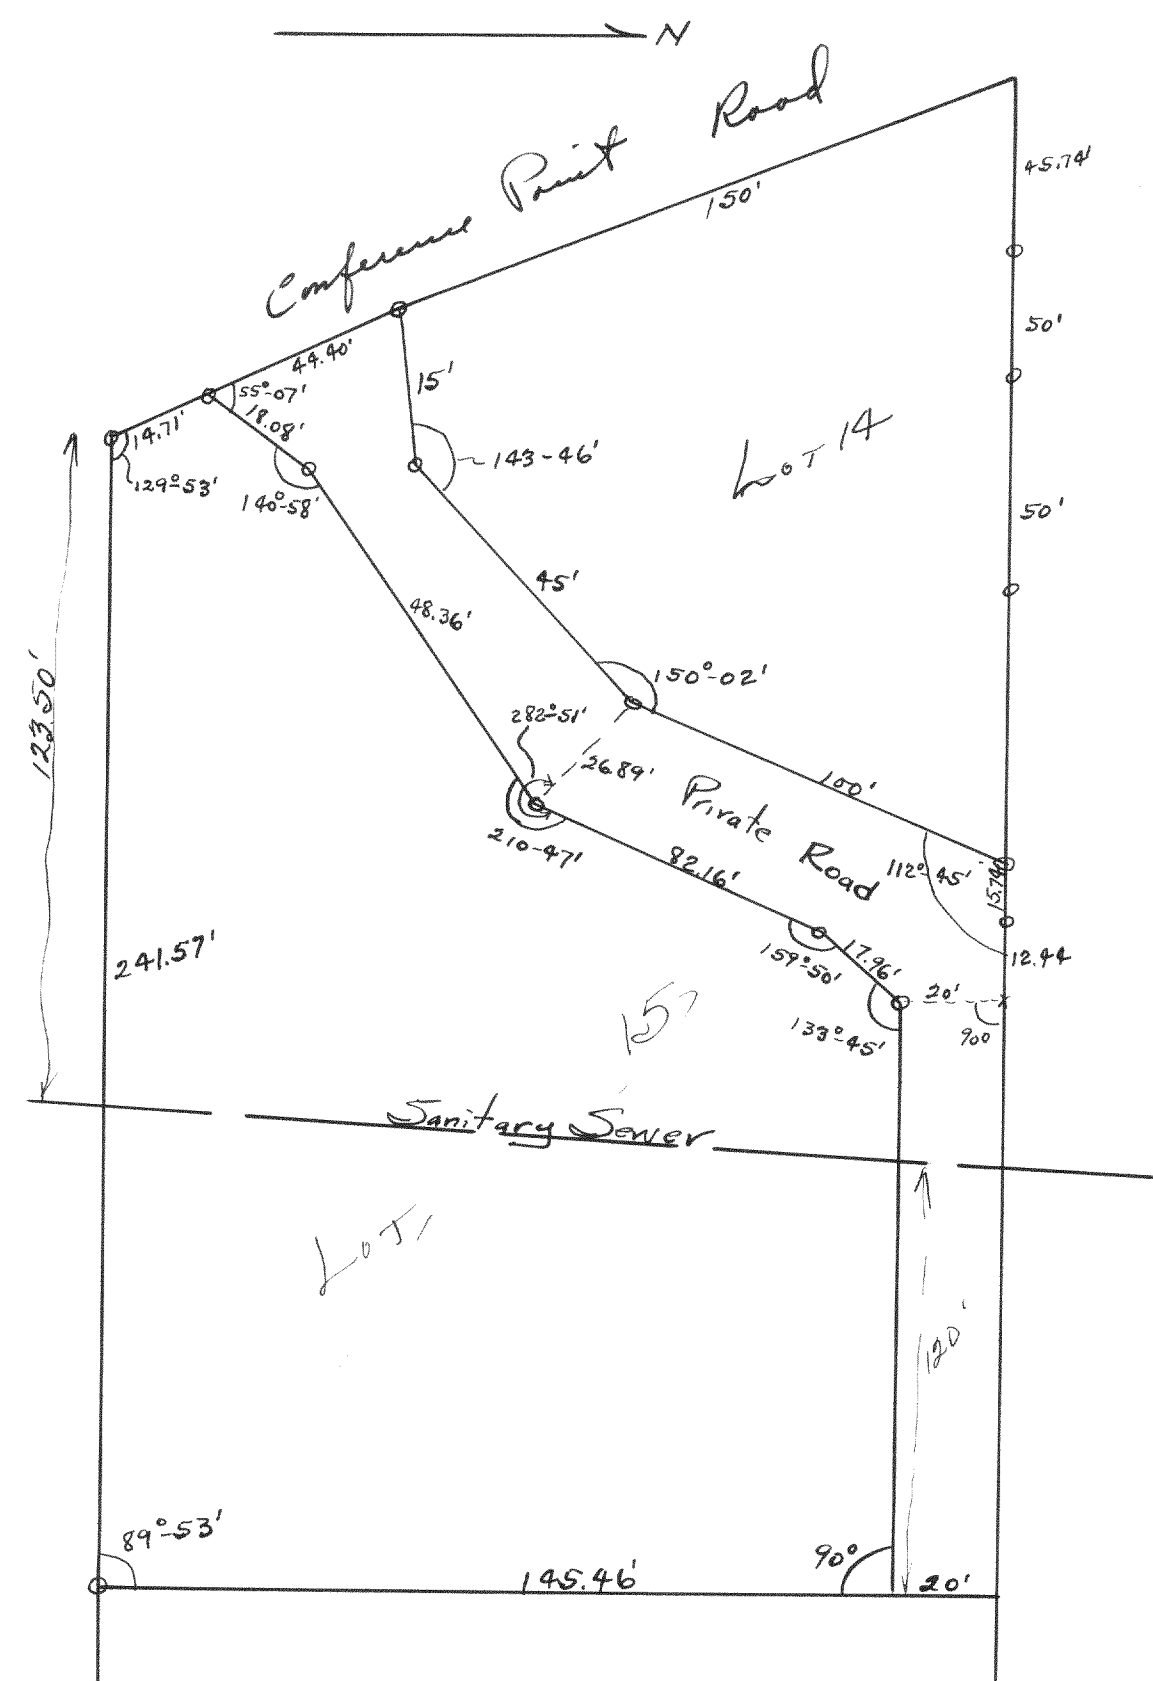


Plot of survey of part of Lot 15 of
Jewell's Subdivision, located in
The Village of Williams Bay Wisconsin.

July 11, 1944

Lloyd L. Jensen
County Surveyor

#1508

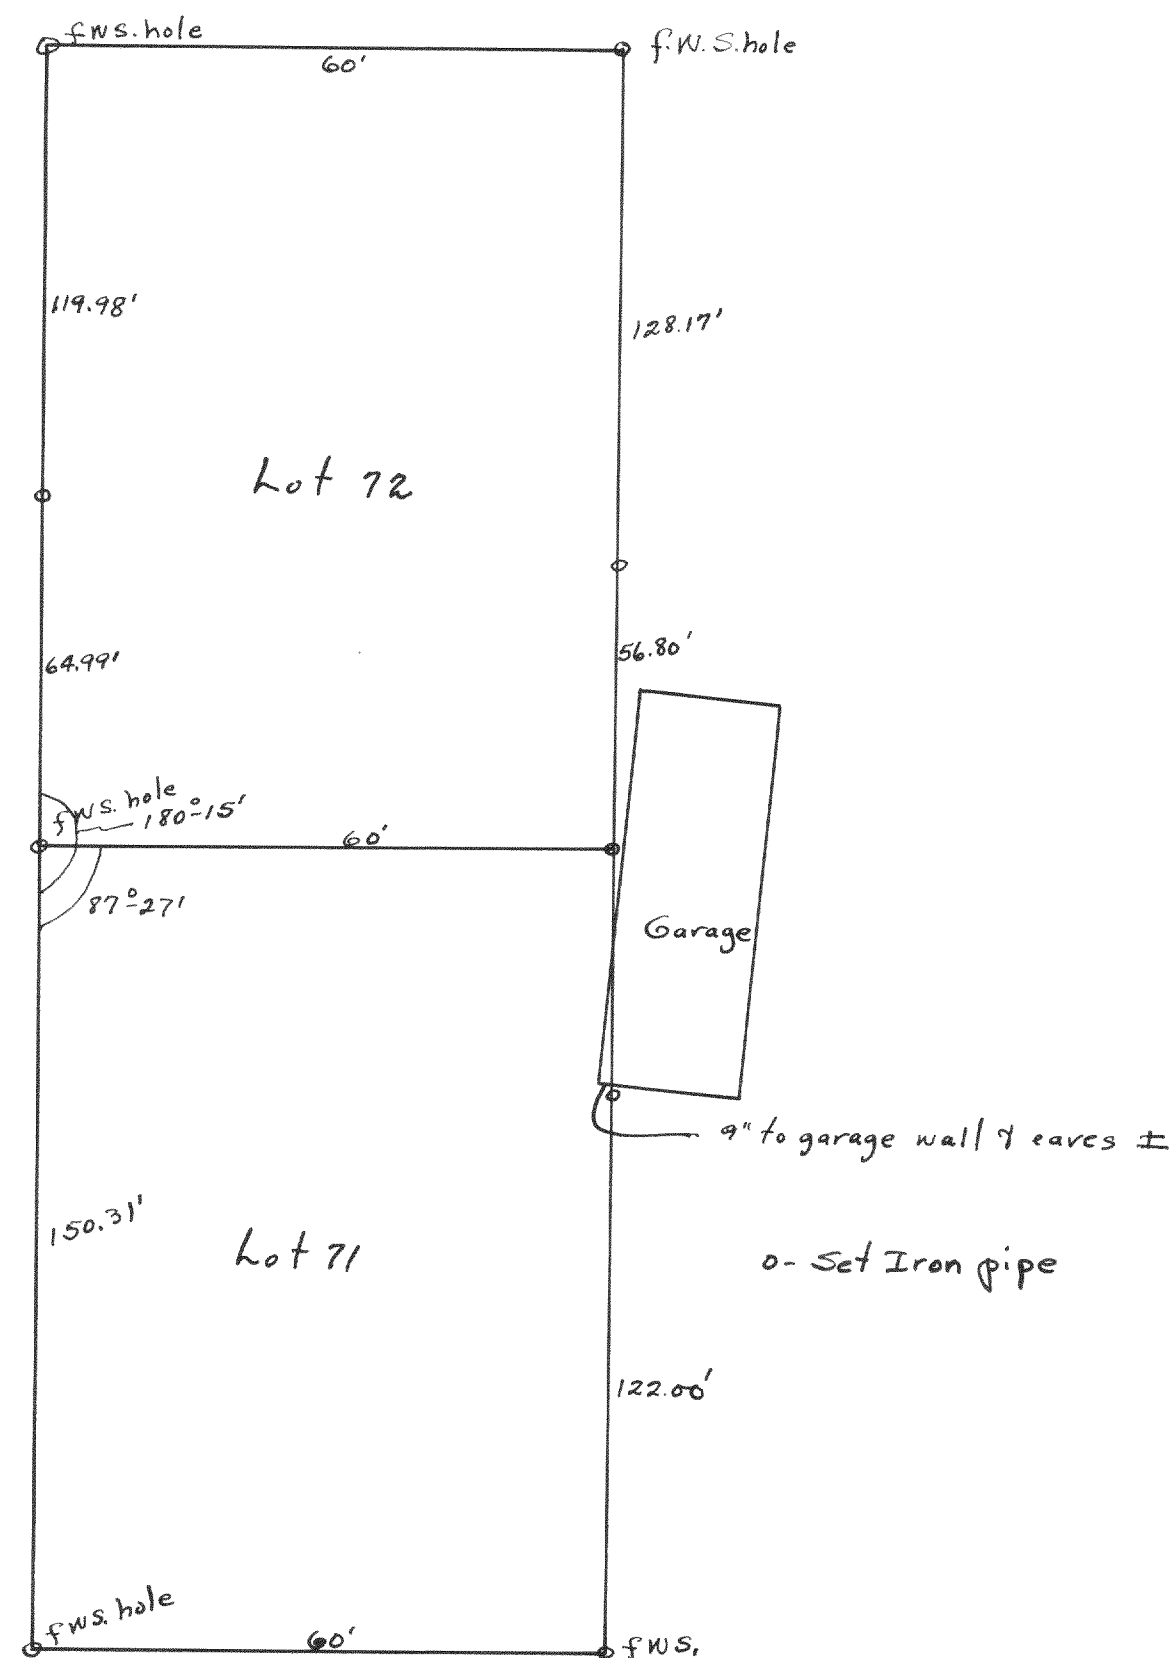

Plot of survey of Lots 71 & 72 of
Bay View Subdivision located
in the Village of Williams
Bay Wisconsin.

June 29, 1944

Lloyd L. Jensen
County Surveyor