


#1509

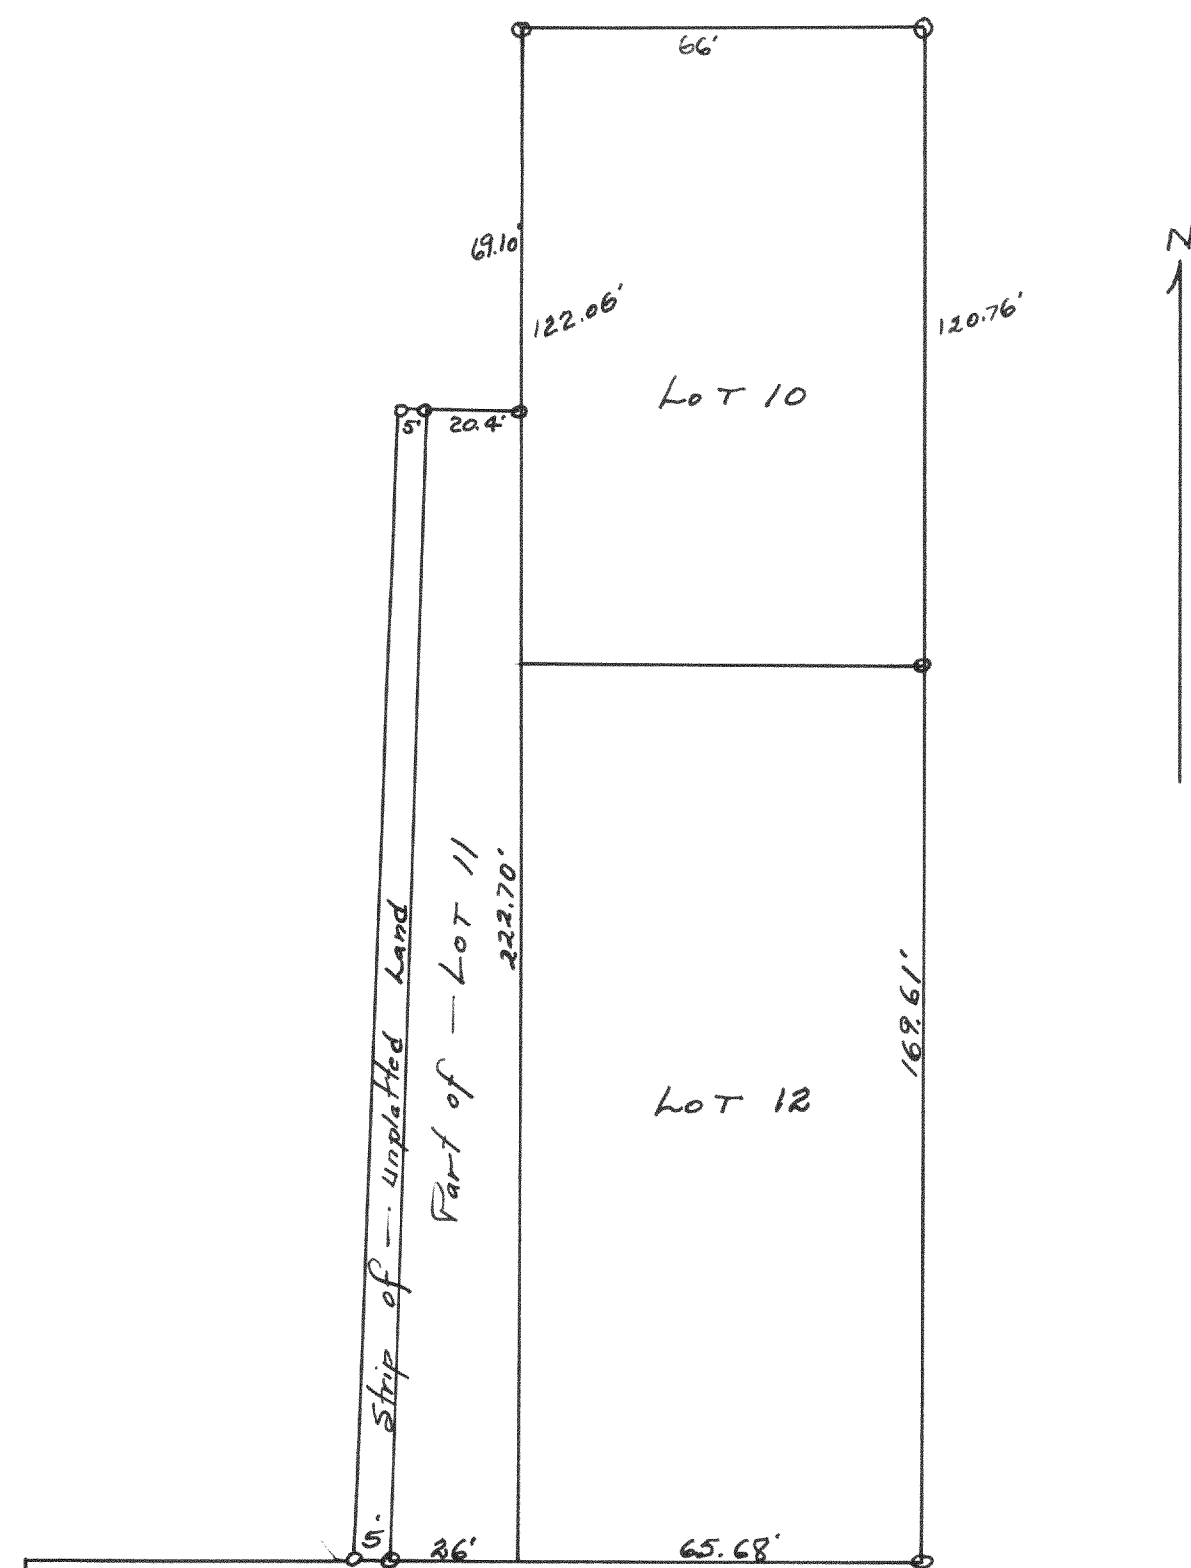


SW corner of the $E\frac{1}{2}$ of the $NE\frac{1}{4}$ of Fractional Section 1, T17N R16E

Plot of survey of Lot 10, 12, part of 11 of Johnson's Addition to the Village of Williams Bay and a 5 foot strip lying West of part of Lot 11.

May 1944

Lloyd L. Jensen
County Surveyor

#1510

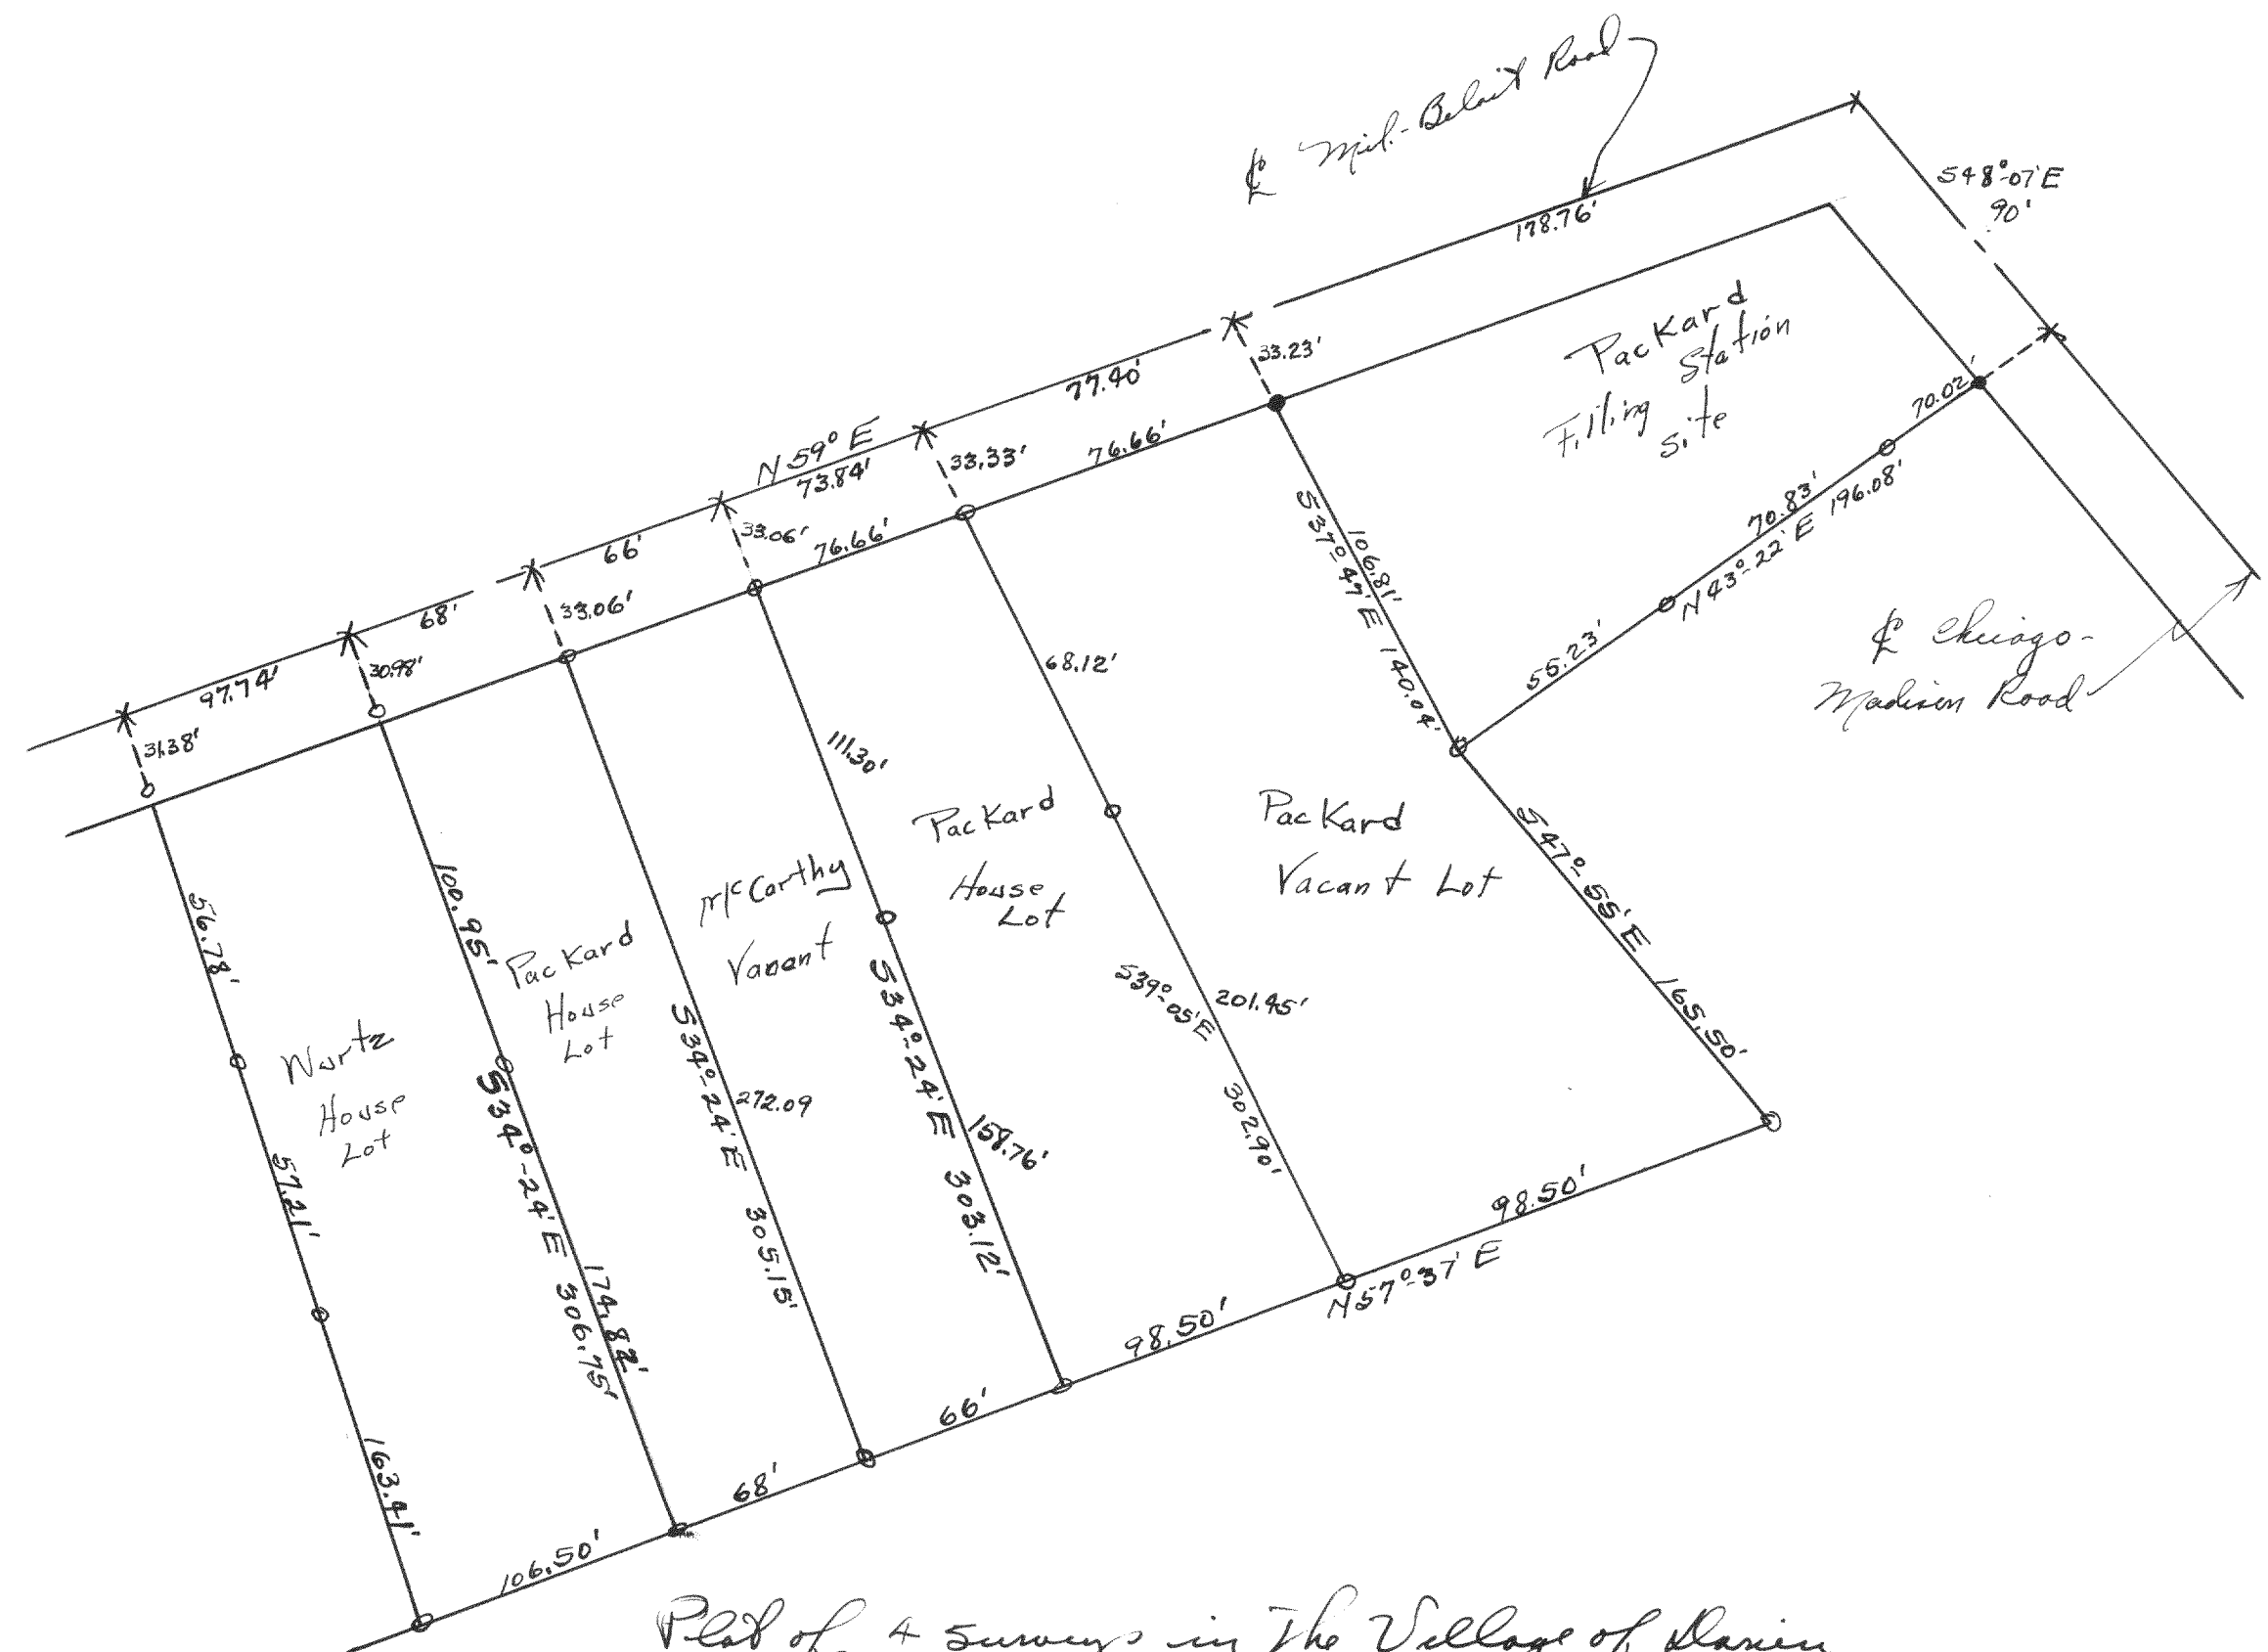

Plot of 4 surveys in the Village of Danien at the intersection of the 2 main highways as shown on the plat.

July 1944

Lloyd L. Jensen
County Surveyor