



#1516

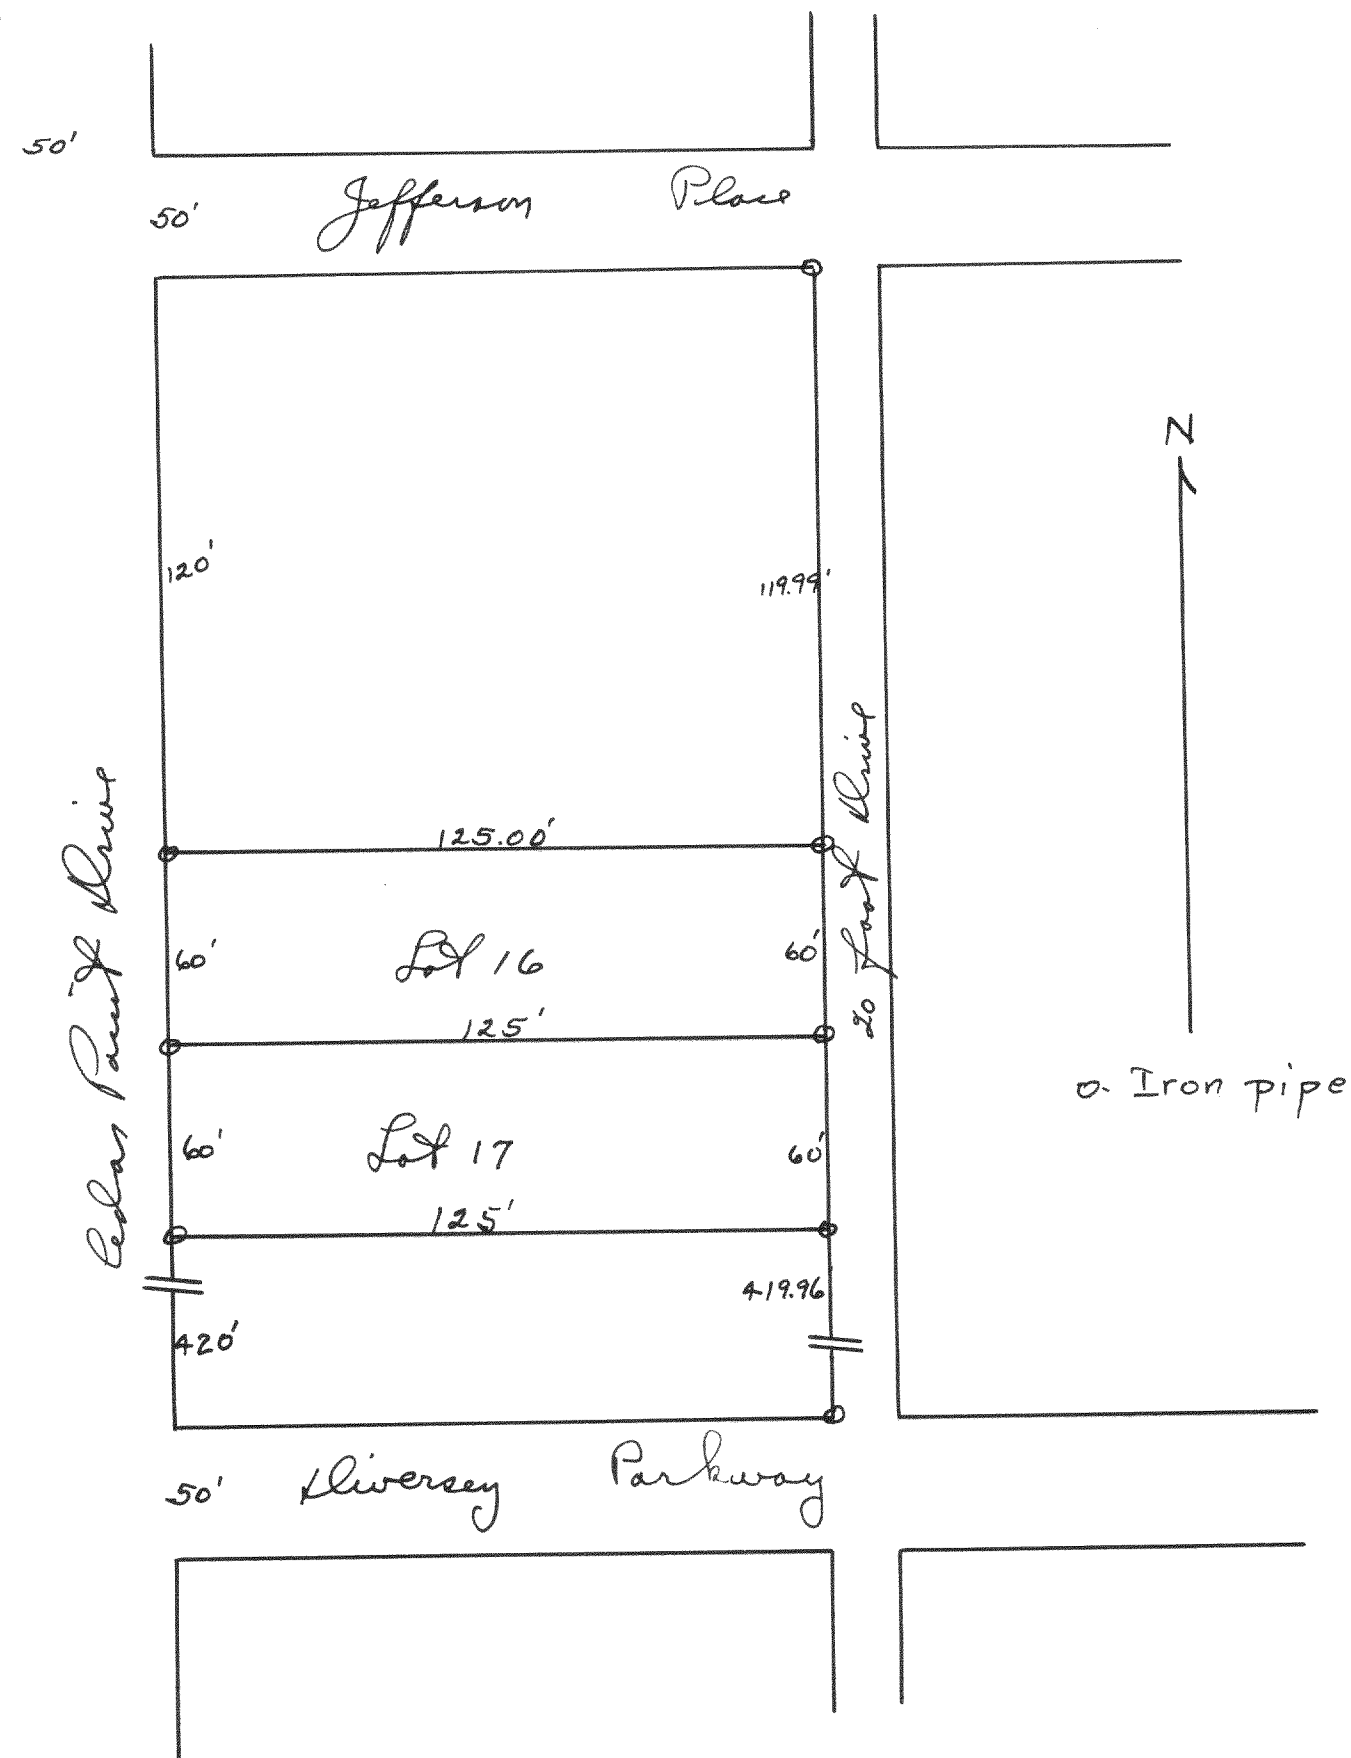

Plot of survey of Lots 16 and 17 of Cedar Point Park Subdivision in the Village of Williams Bay, Walworth County Wisconsin.
Oct. 18, 1945

Lloyd S. Jensen
County Surveyor

#1517

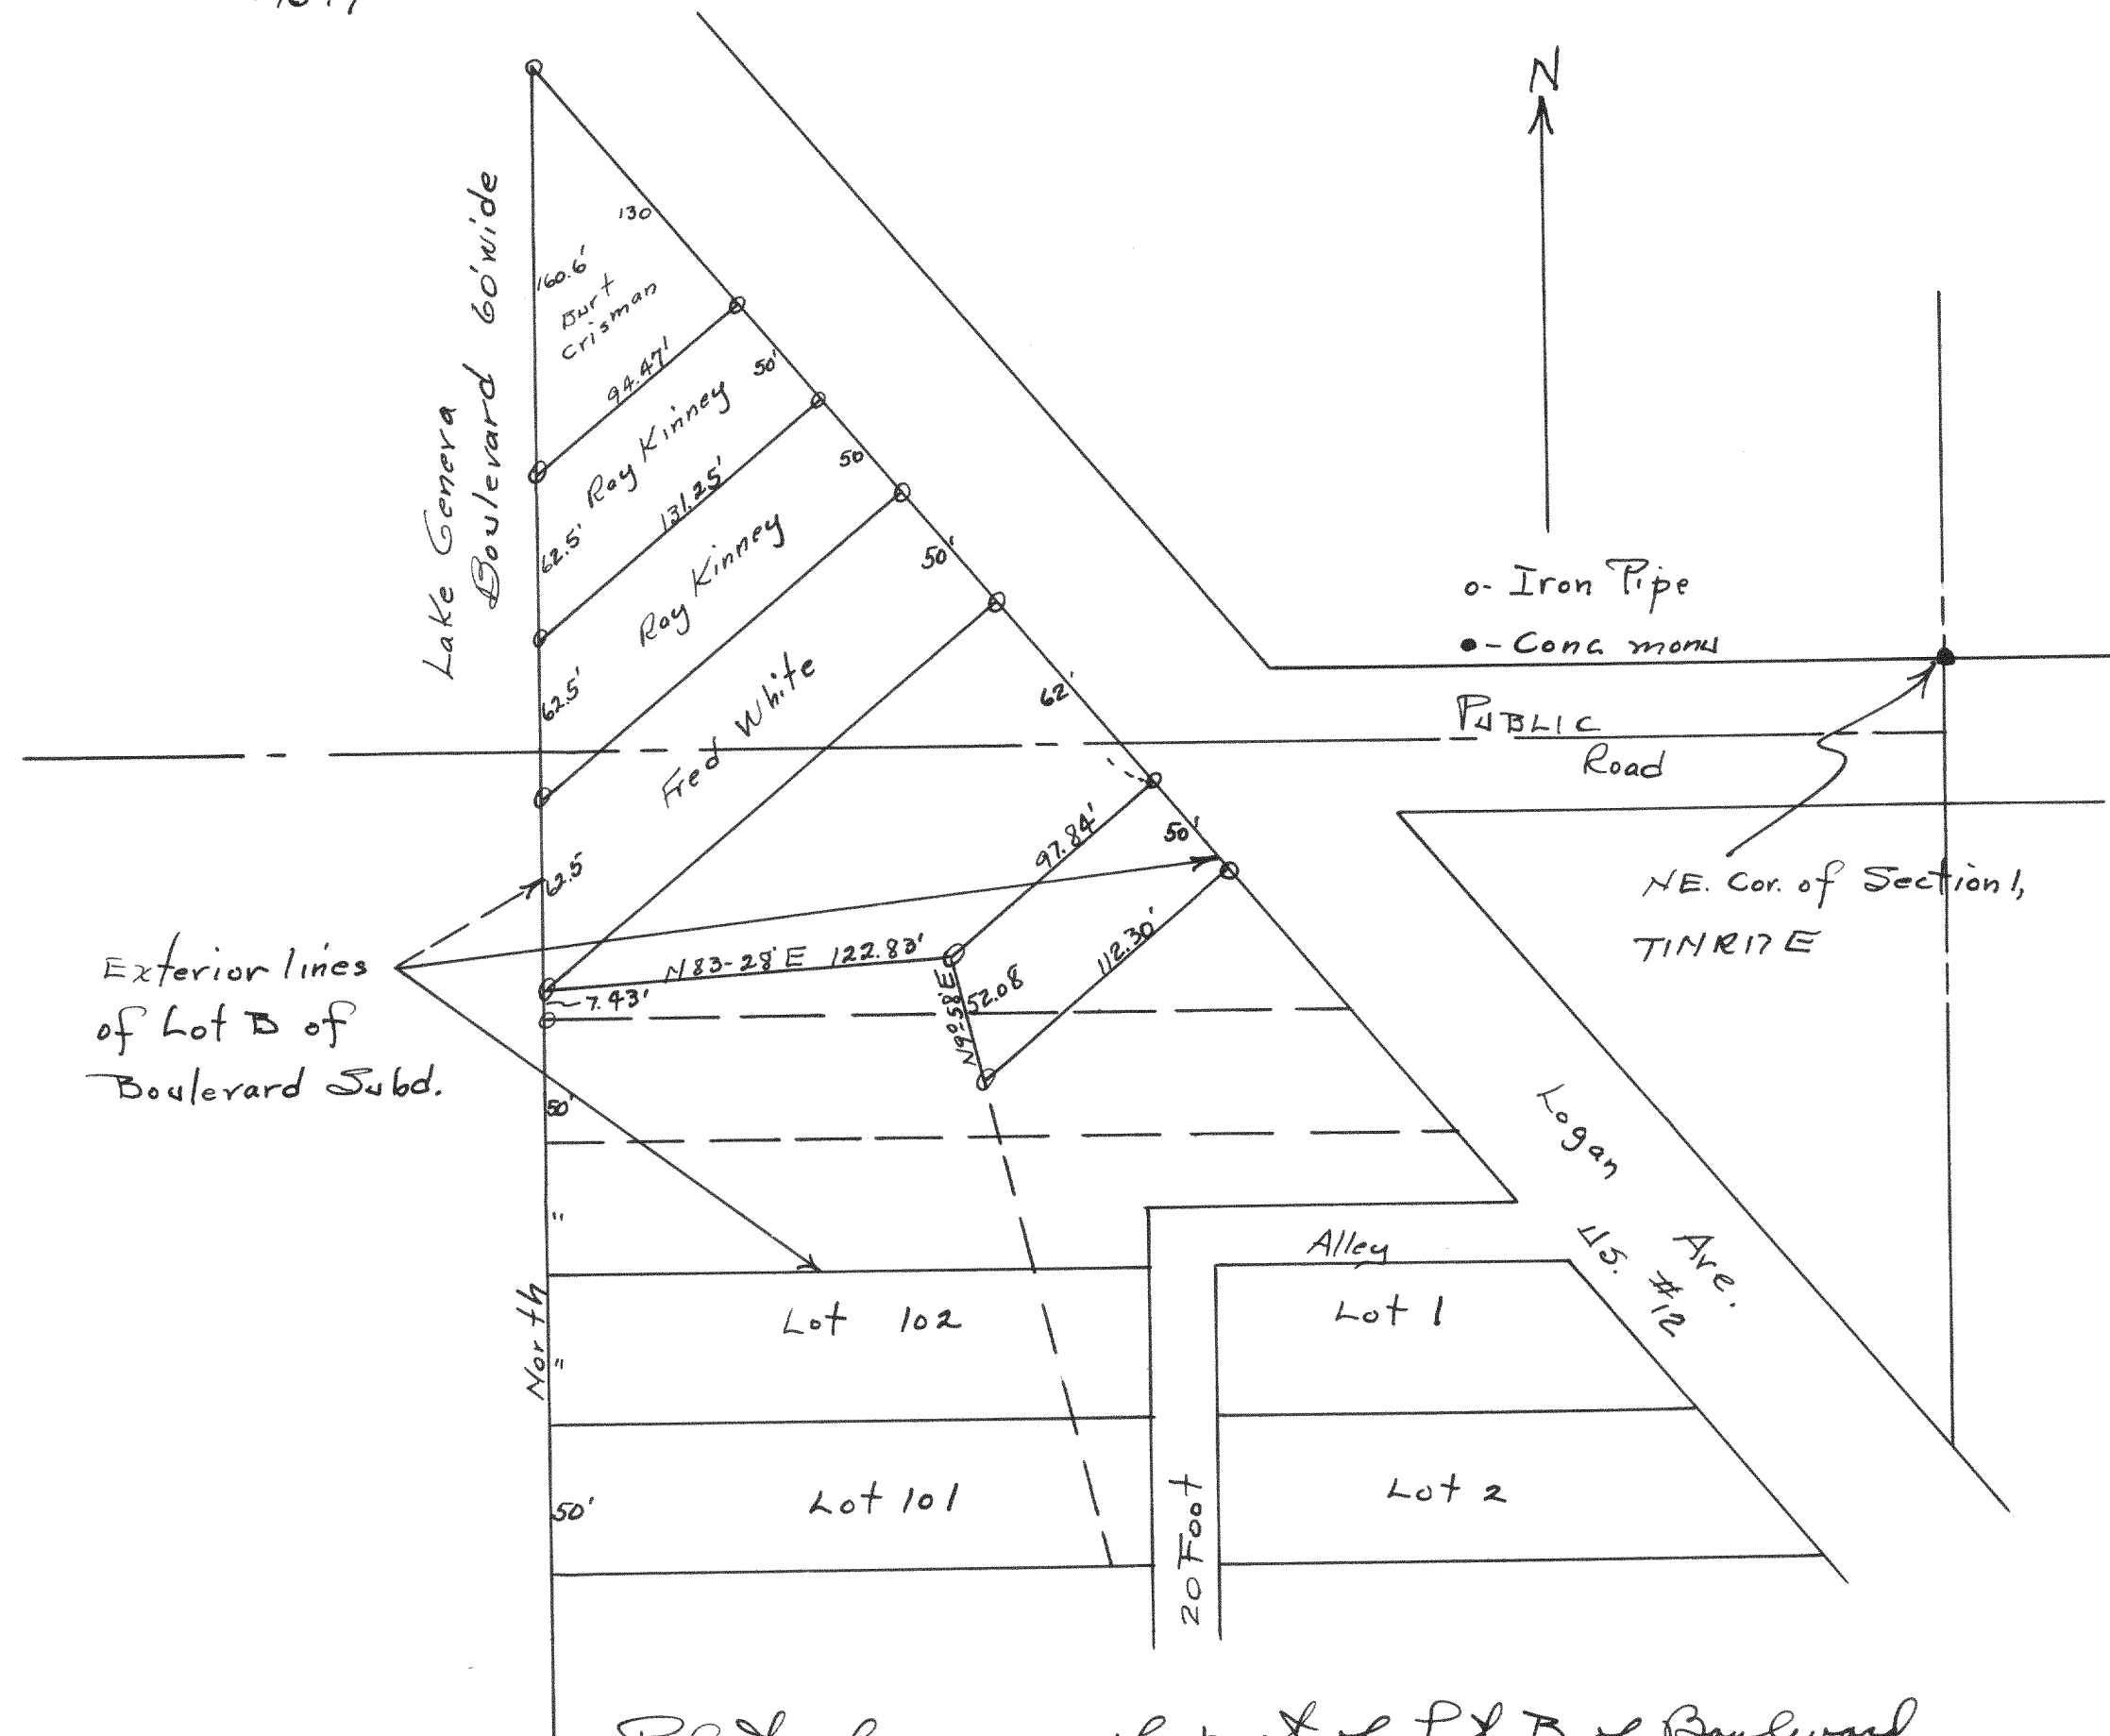

Plot of survey of part of Lot B of Boulevard Subdivision, which is located in Section 1, T17N R17E City of Lake Geneva.

May 1945

Lloyd S. Jensen
County Surveyor