


#1520

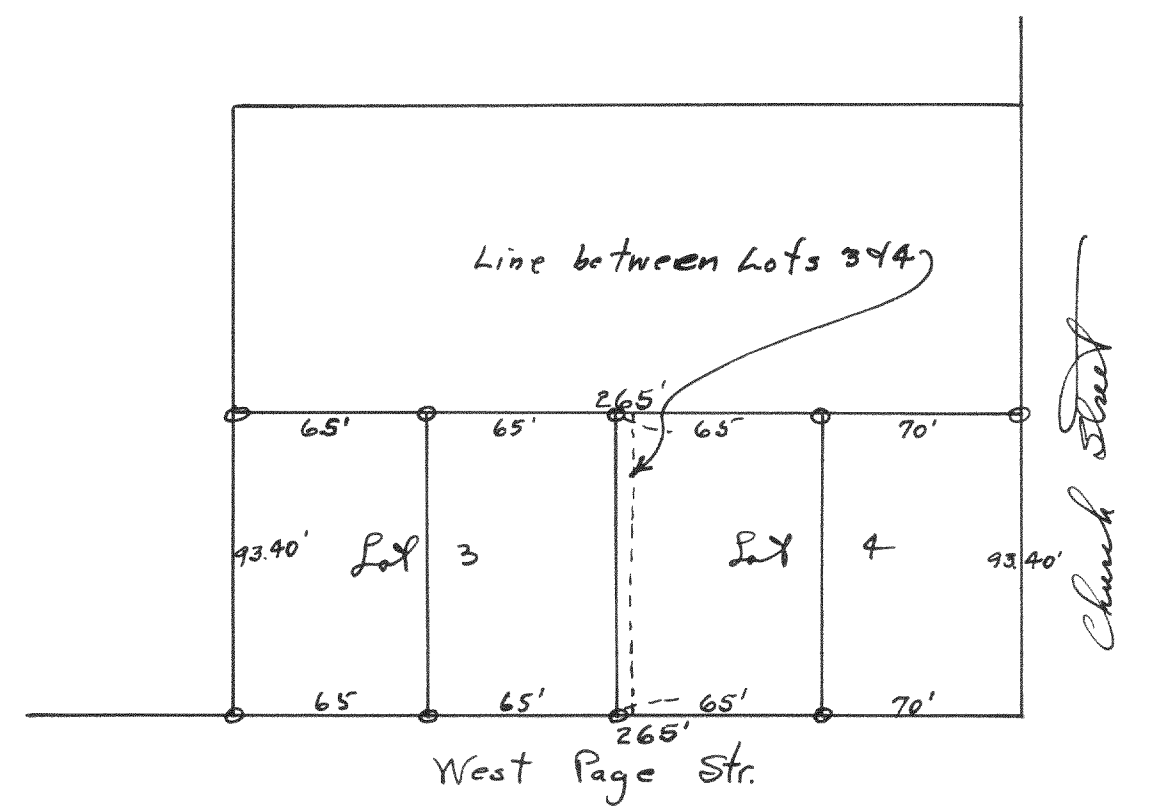

Plot of survey of the division of Lots
3 & 4 of Blk. 6 of the original plat
of Cokhom.


Nov. 1946

Lloyd L. Jensen
County Surveyor

N

0 - Iron Pipe

#1521

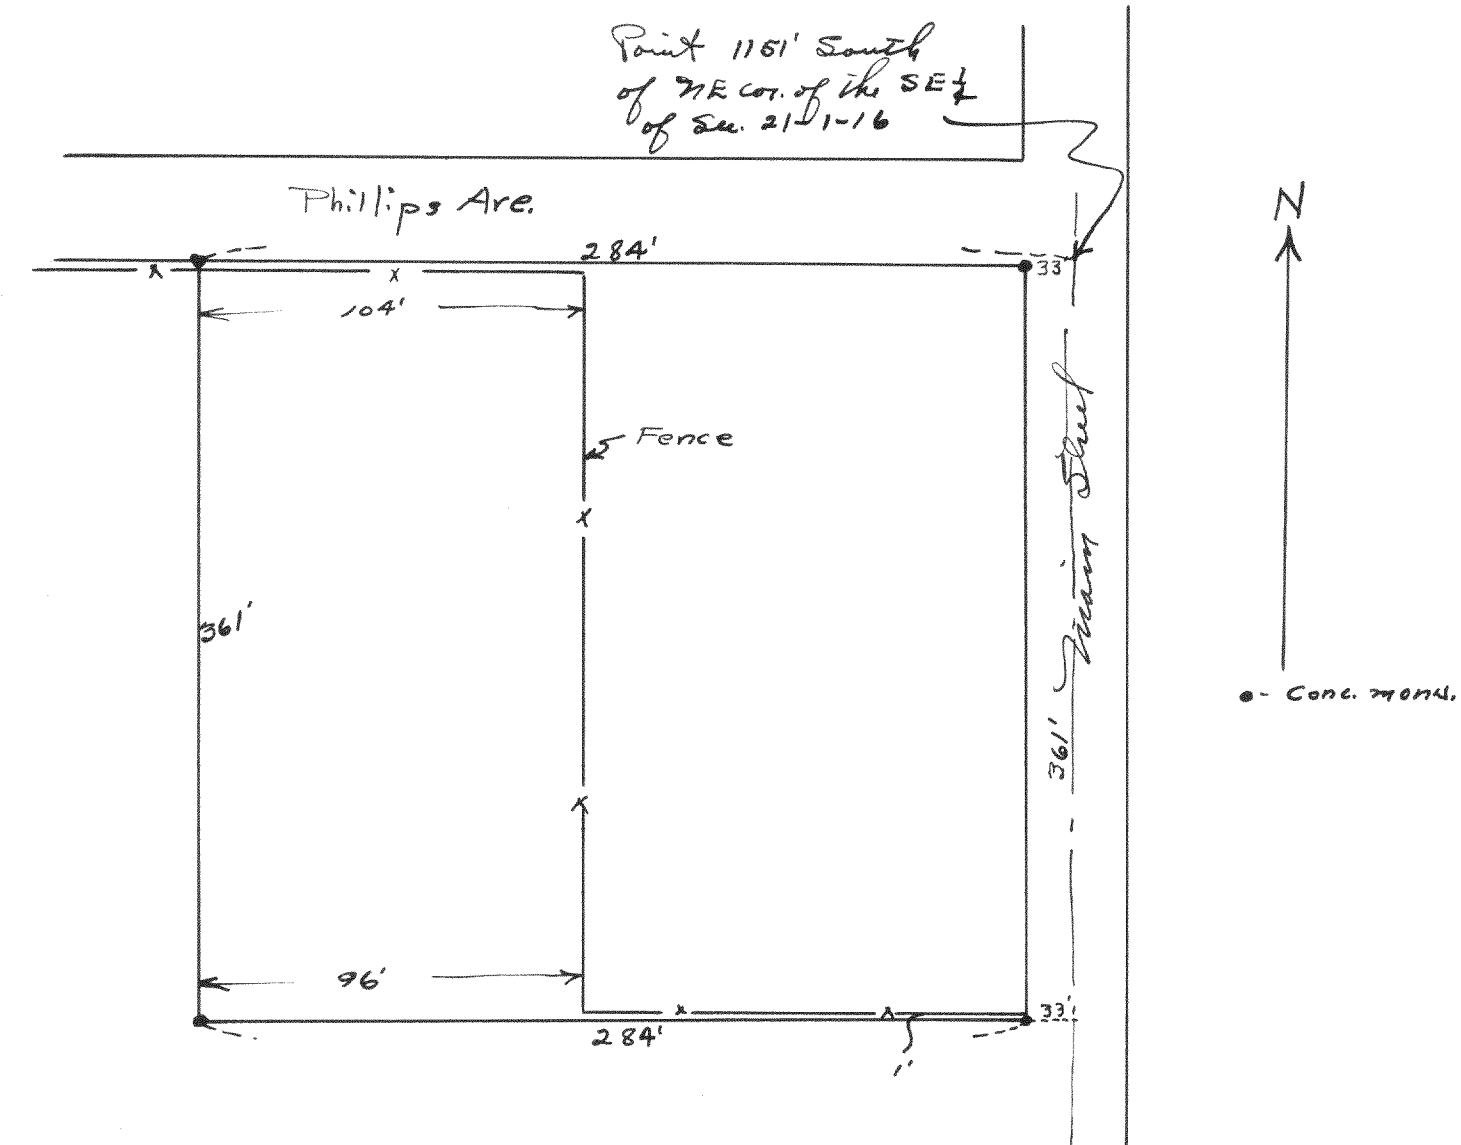

Plot of survey of land located
in the SE 1/4 of Section 21-1-16.

Jan. 1946

Lloyd L. Jensen
County Surveyor