


#1524

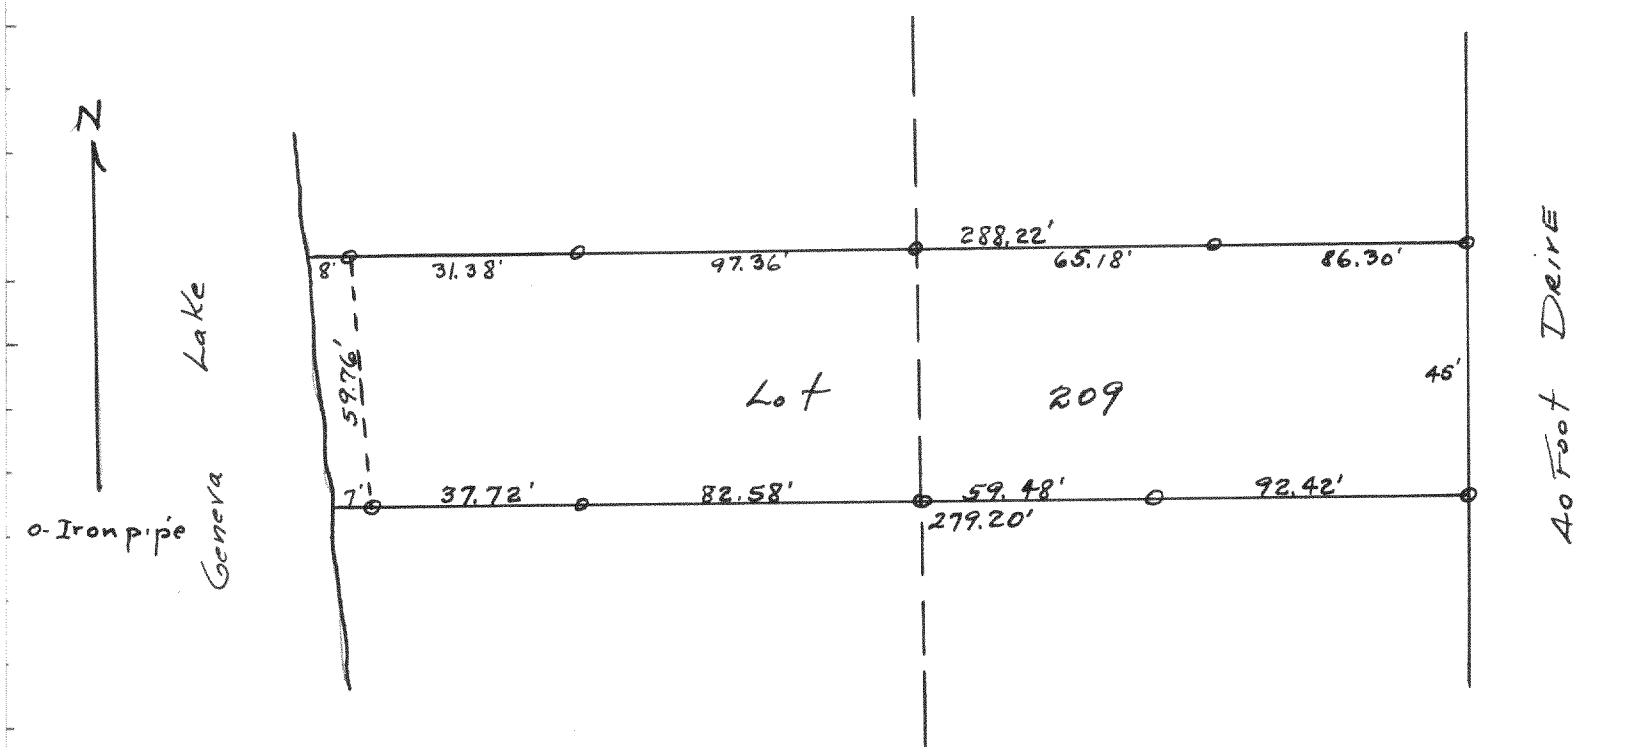


Plot of survey of Lot 209 of the 3rd Addition
to Cedar Point Park.

Oct. 1, 1945

Lloyd L. Jensen
County Surveyor

#1525

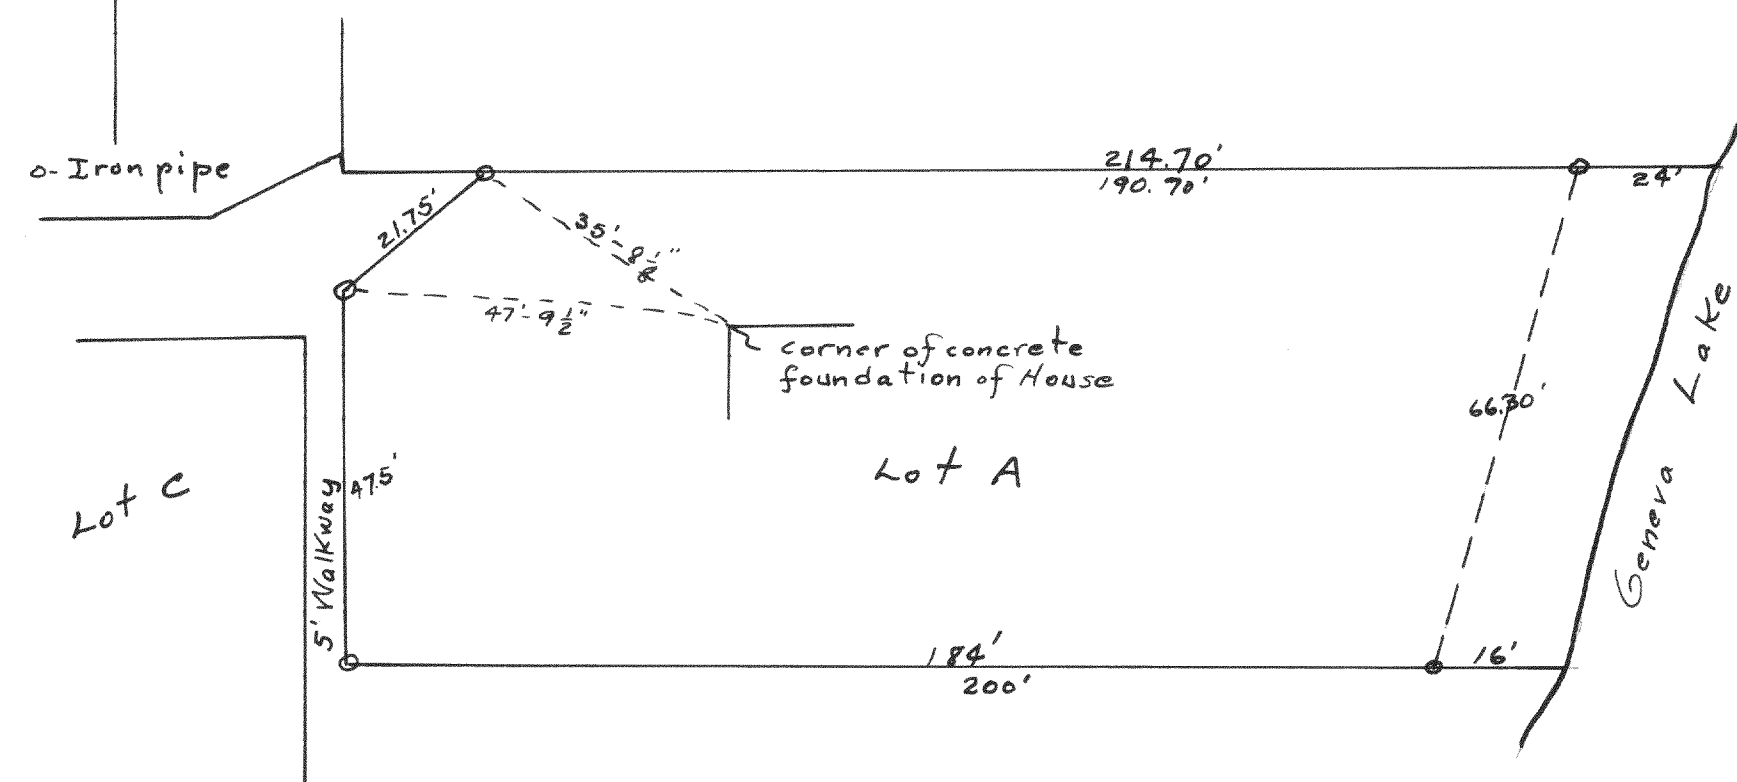

Plot of survey of Lot A of Lock Vista Subdivision
No. 2 of Williams Bay Wisconsin.

Oct. 1945

Lloyd L. Jensen
County Surveyor

#1526



Plot of survey of Lot 190 of Cedar Point
Park Subdivision of Williams Bay, Wis.

Dec. 1945

Lloyd L. Jensen
County Surveyor