


#1527

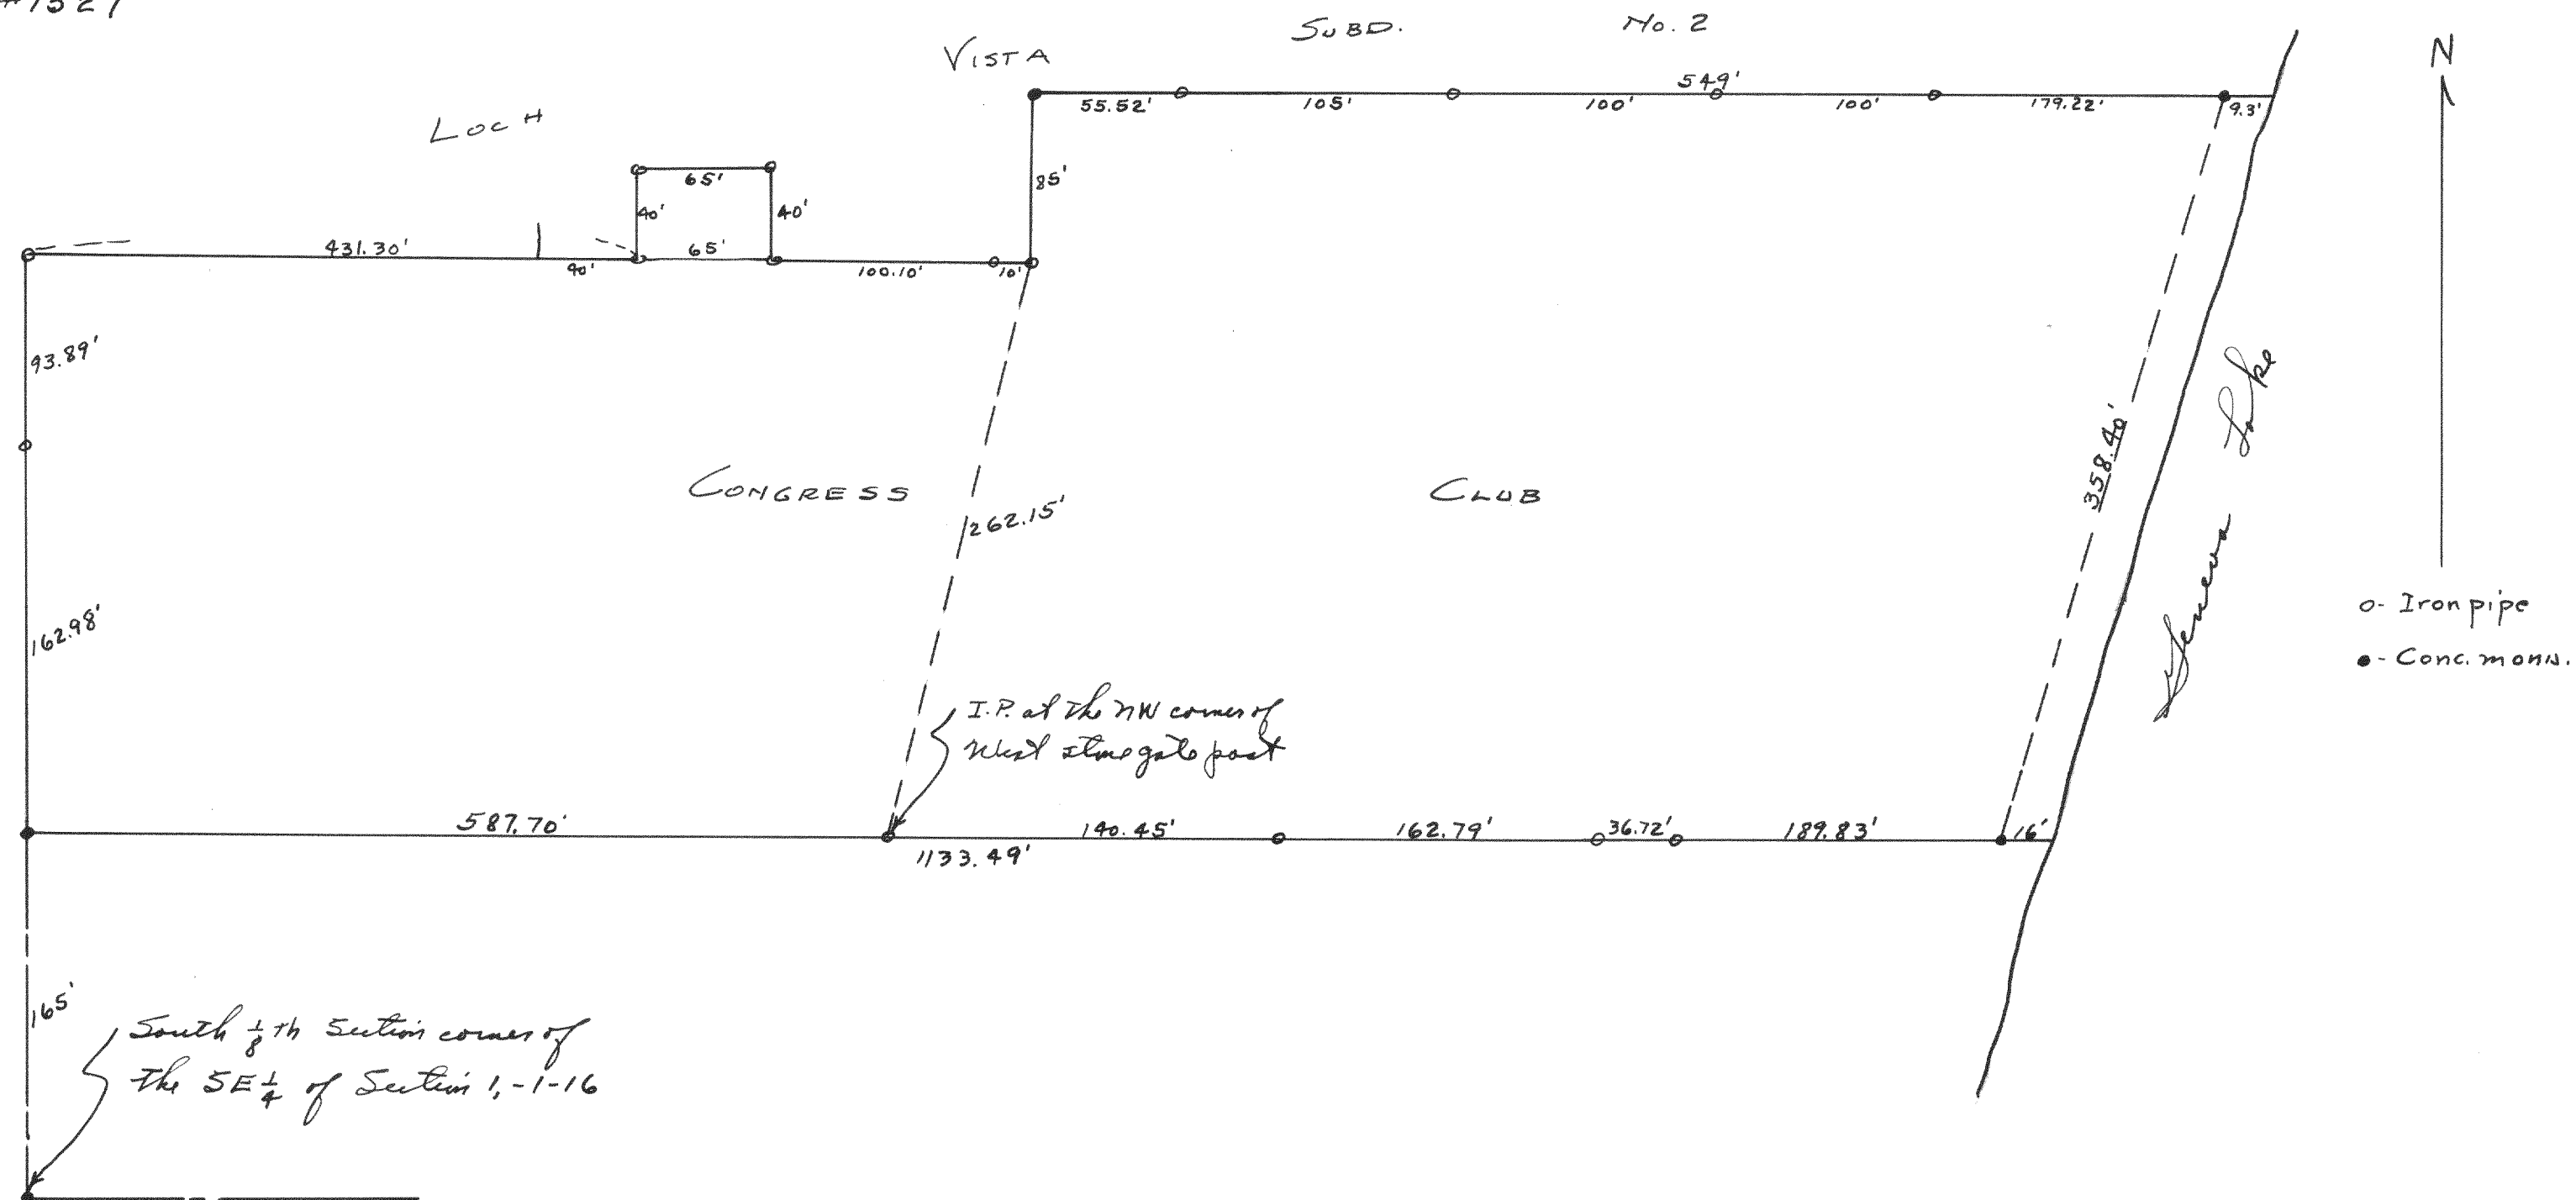

Plot of survey of land owned by the Congress Club and located in the East $\frac{1}{2}$ of the SE $\frac{1}{4}$ of Section 1-1-16 in the Village of Williams Bay, Walworth County Wisconsin

Oct. 27, 1945

Lloyd S. Jensen
County Surveyor