



#1547

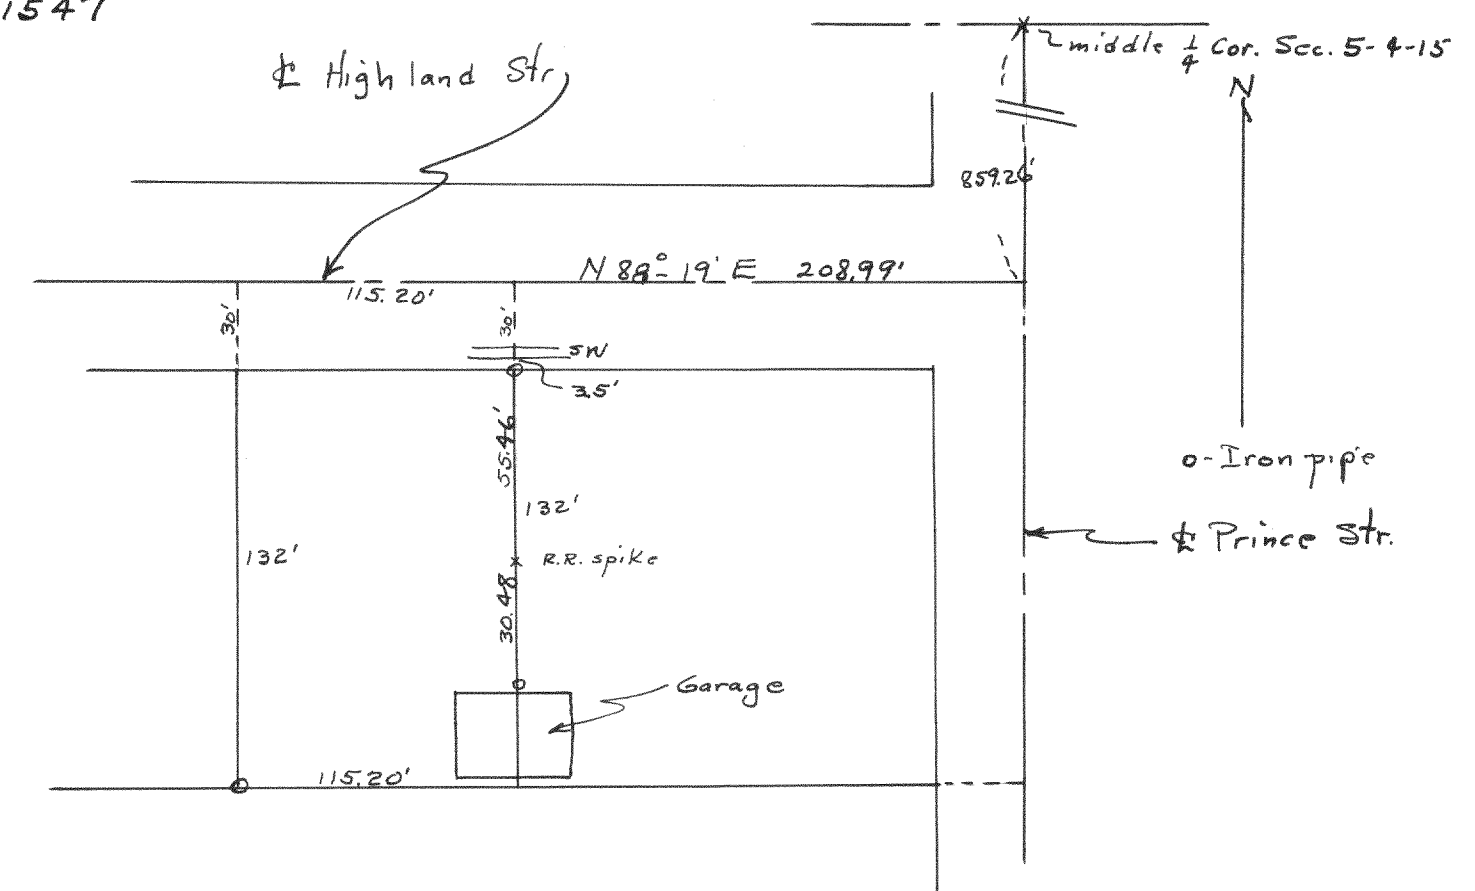

#1549

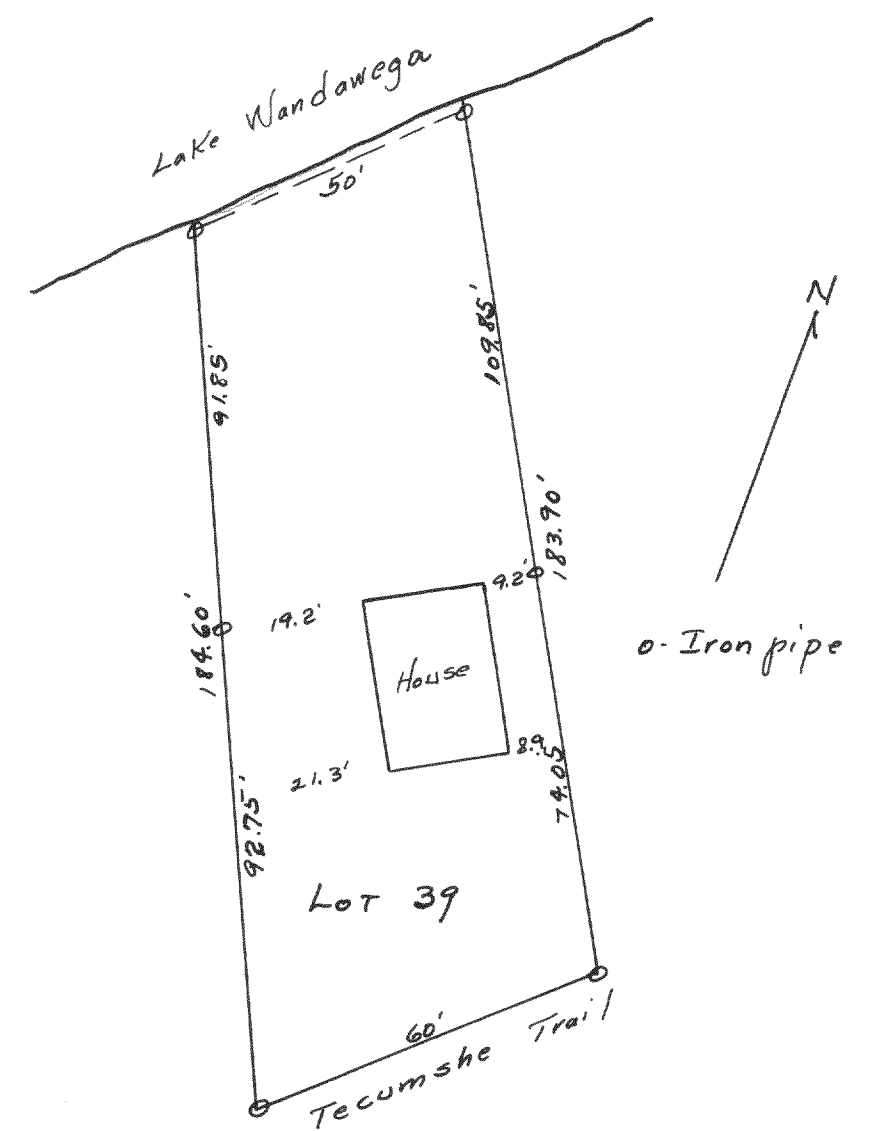


Plat of survey of land located in the SW 1/4 of Section 5, T4N R15E, Whitewater Wis.

July 1945

Lloyd B. Jensen
County Surveyor

#1548

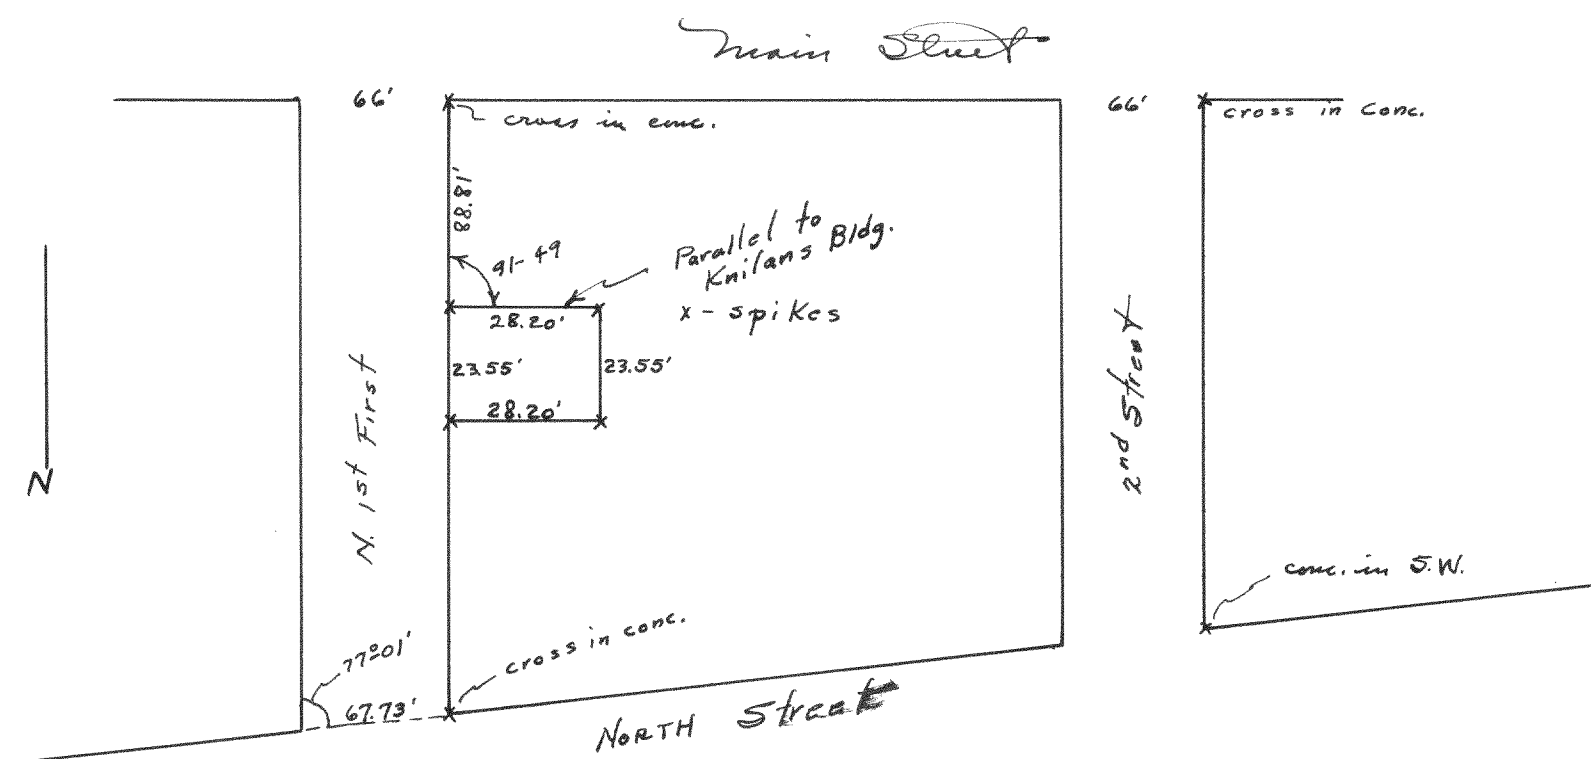


Plat of survey of part of lot 1 of Blk. 2 of Original plat of Whitewater Wisconsin

Nov. 1945

Lloyd B. Jensen
County Surveyor

#1550

Plat of survey of Lot 39 of Blk. I of Lake Waukegan Highlands, located in Sections 11 & 12, T3N R16E.
Oct. 1945
Lloyd B. Jensen
County Surveyor

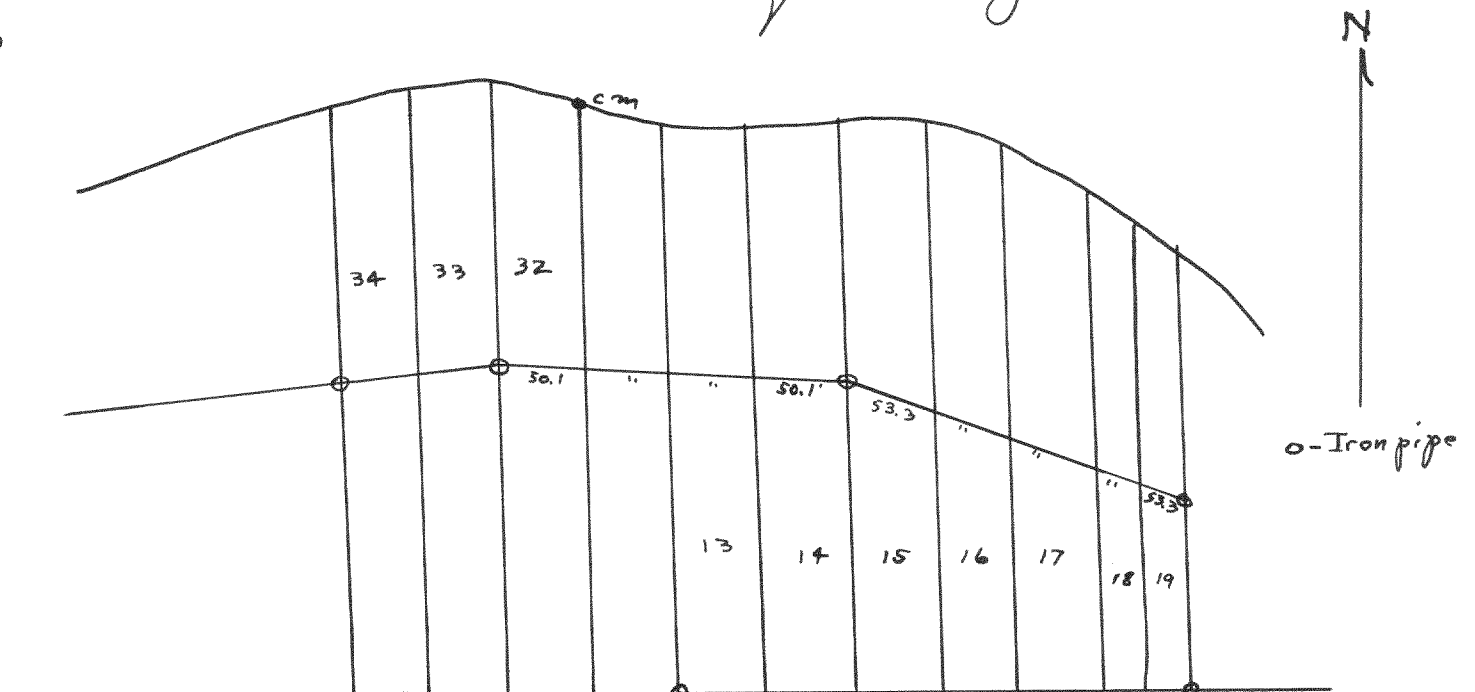

Plat of survey of lots of Blk 4 of Lake Waukegan Highlands.
April 4, 1945
Lloyd B. Jensen
County Surveyor