


SURVEY NO. 1185

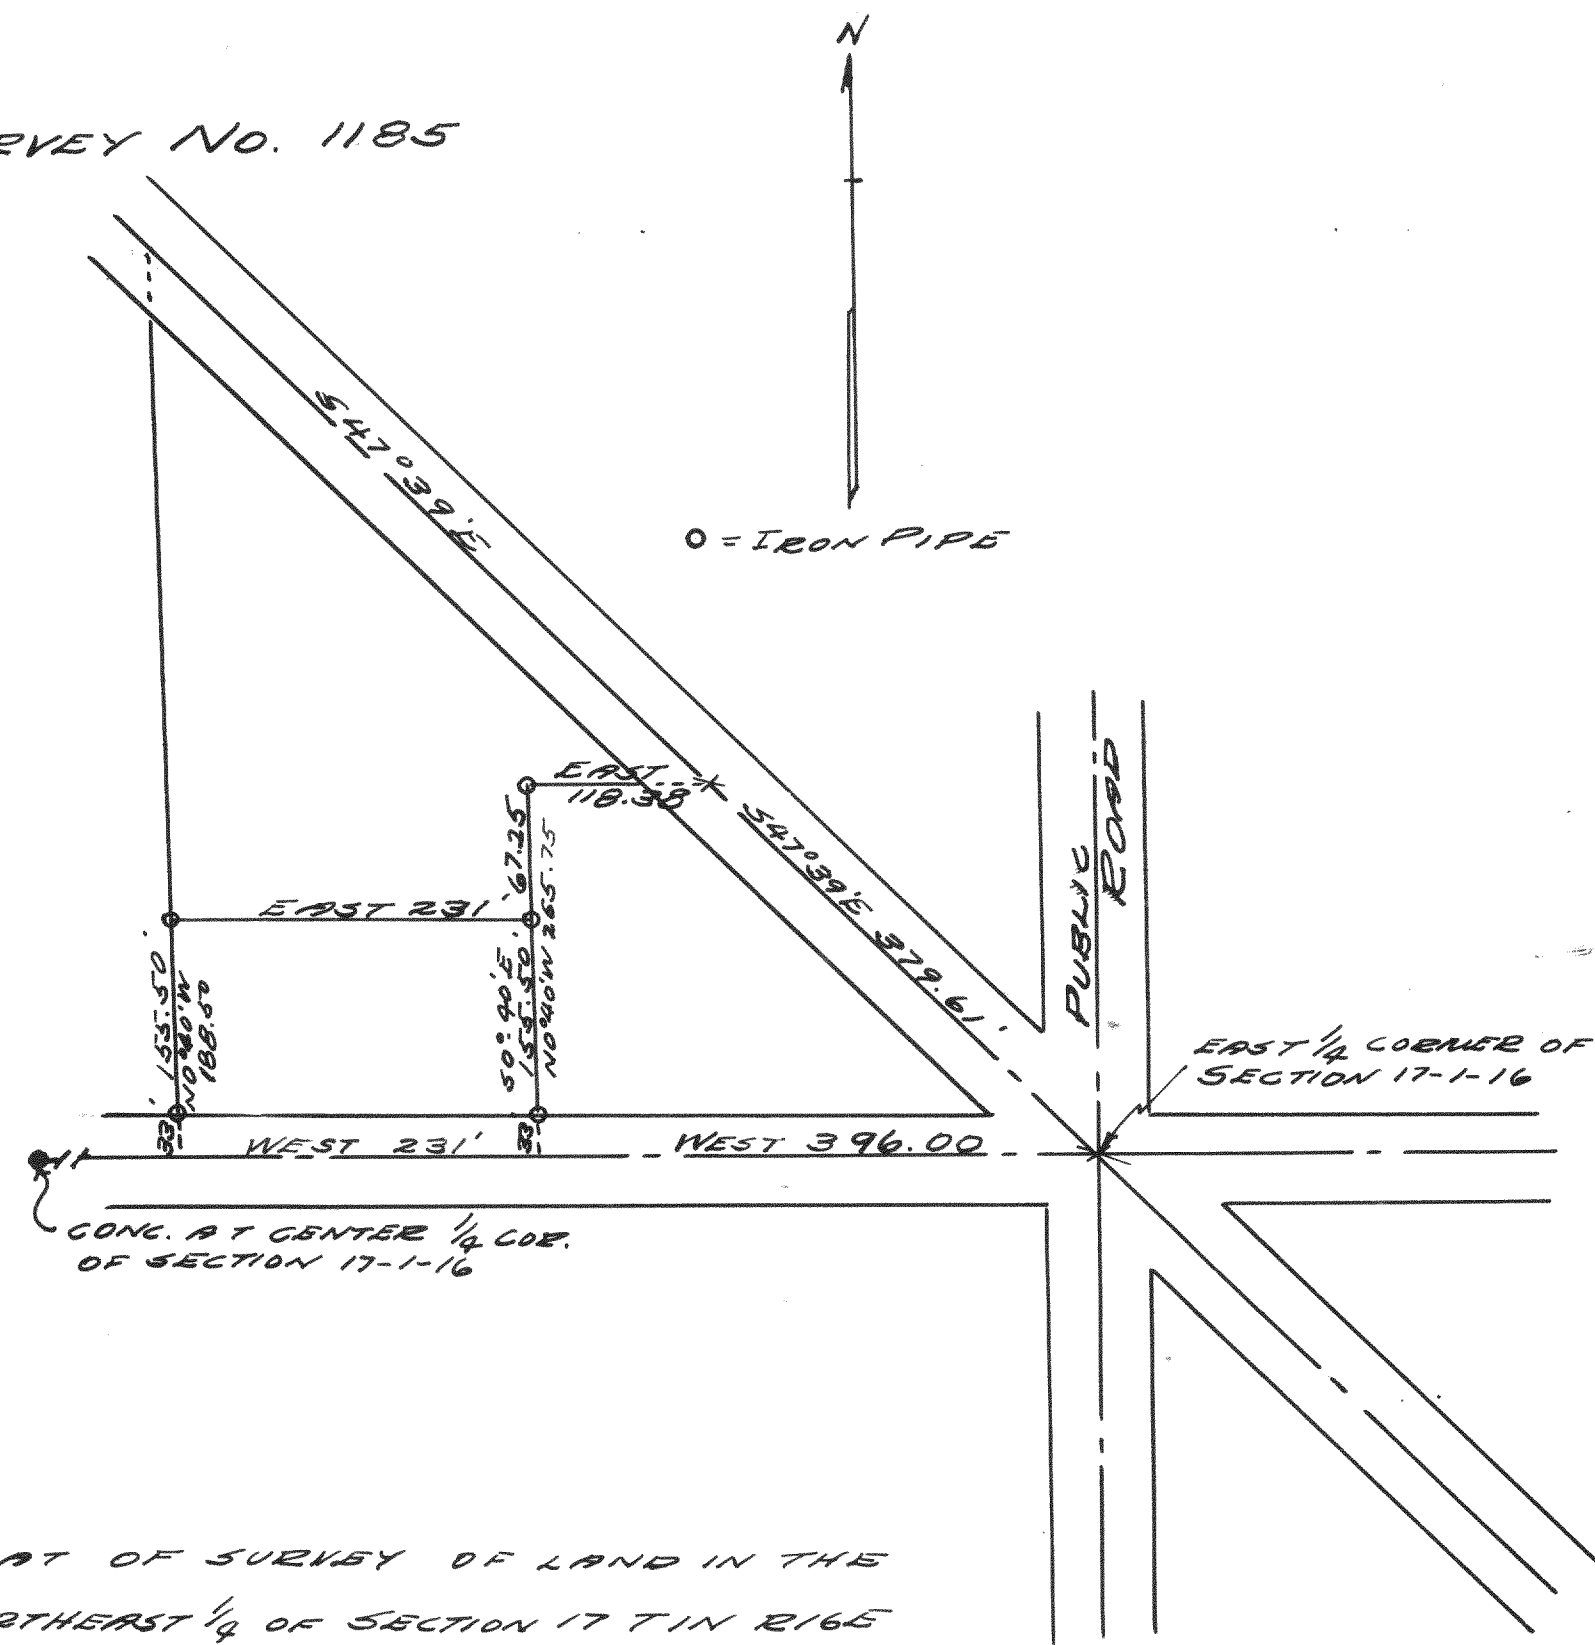


PLAT OF SURVEY OF LAND IN THE
NORTHEAST $\frac{1}{4}$ OF SECTION 17 T 16 E
OF WALWORTH COUNTY, WISCONSIN.

DEC. 12, 1941

Lloyd L. Jensen
N.E.J.

SURVEY NO. 1186

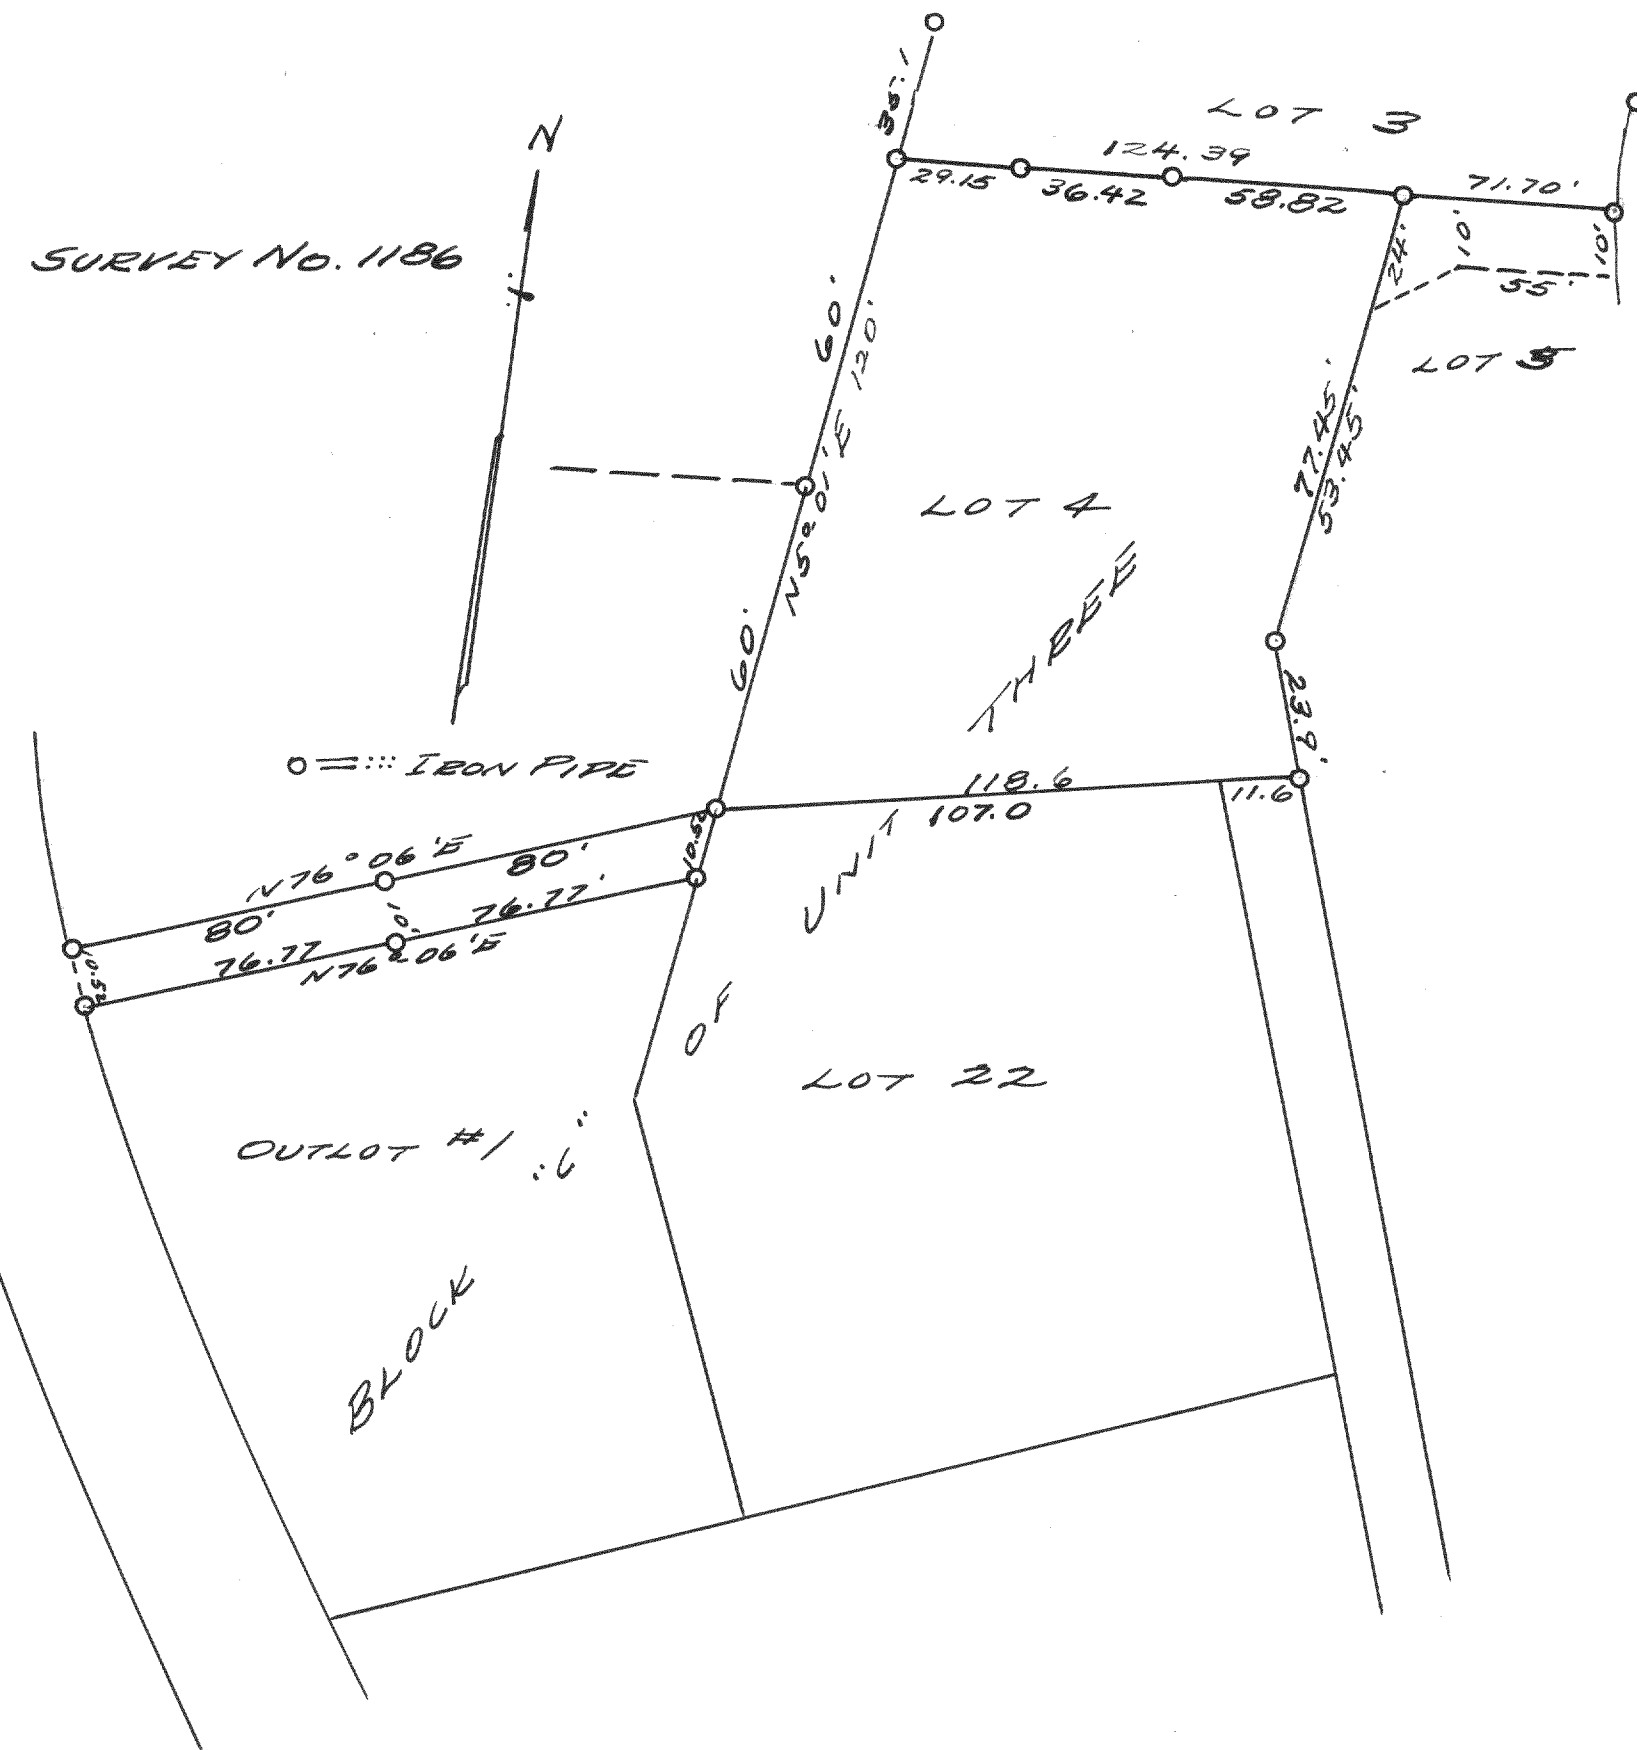

PLAT OF SURVEY OF PART OF
OUTLOT #1 AND LOT 5 AND OF ALL
OF LOT 4 ALL IN BLOCK "C" OF UNIT
3 OF COUNTRY CLUB ESTATES IN
THE VILLAGE OF FONTANA-ON-GENEVA
LAKE, WALWORTH CO. WISC.

SEPT 26, 1941

Lloyd L. Jensen
N.E.J.