




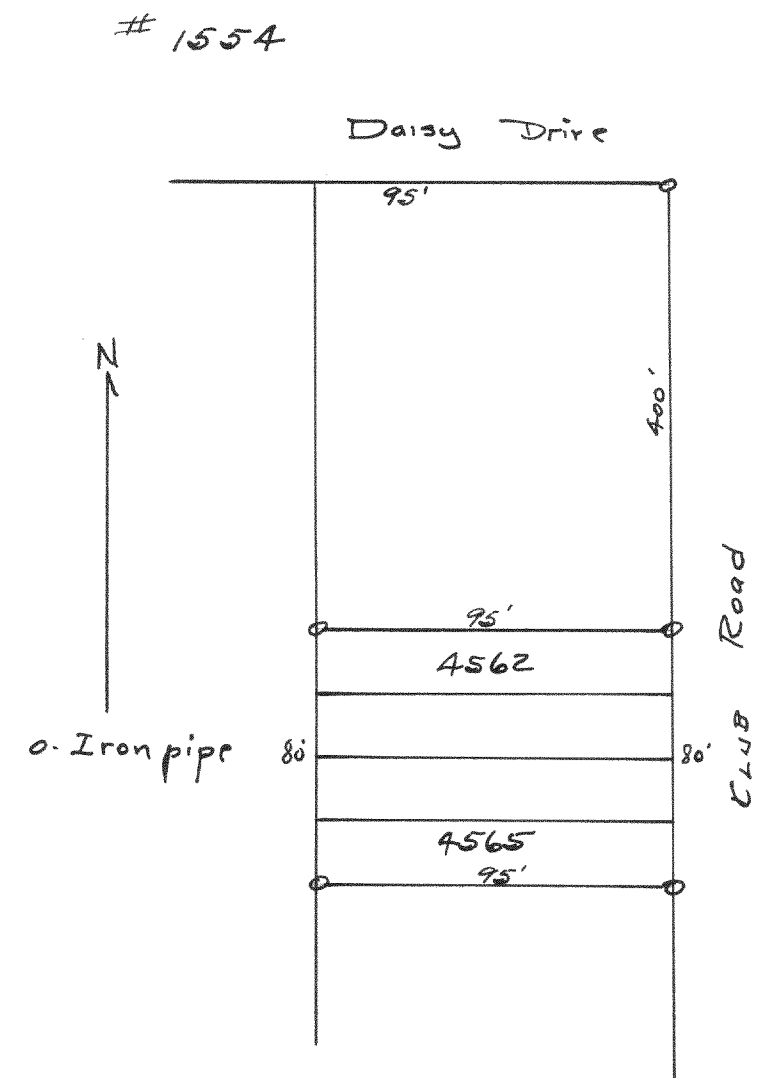

Plot of survey of lots in Lake Como Beach Subd.
Dec. 1945
Lloyd S. Jensen
County Surveyor

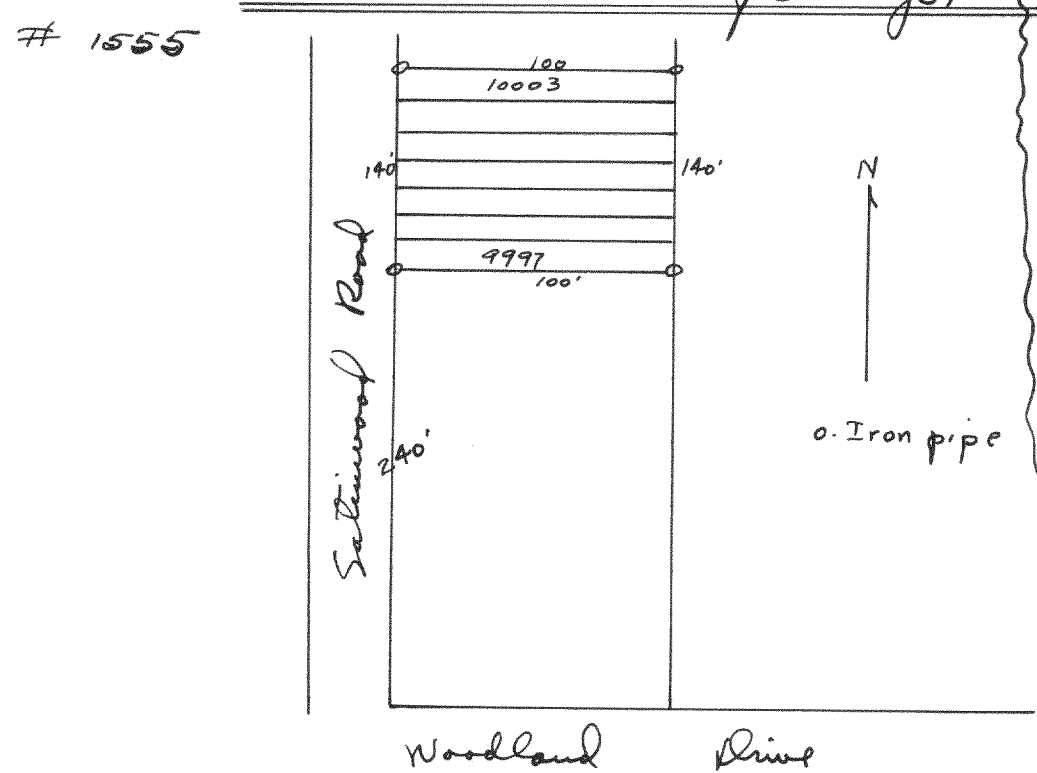


Plot of survey of lots in Lake Como Beach Subd.
10-15-45
Lloyd S. Jensen
County Surveyor

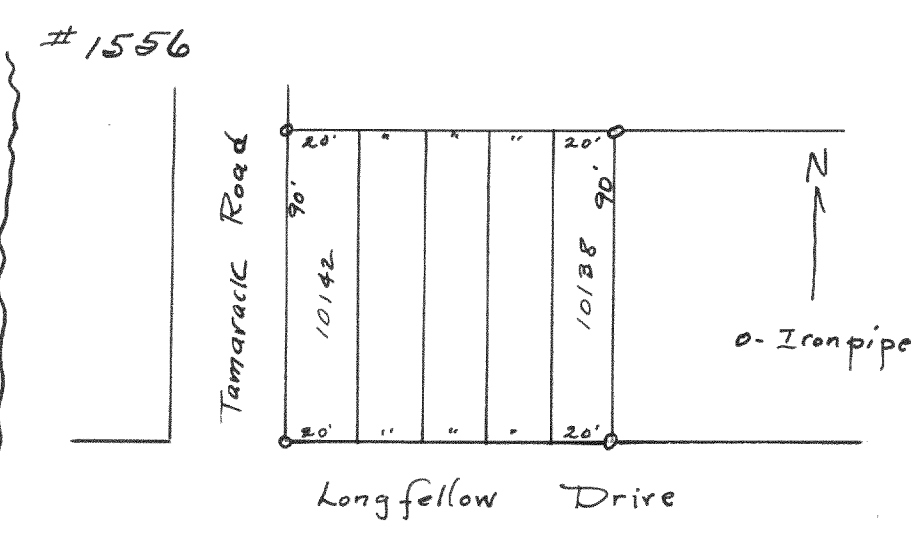


#1557


Plot of survey of lots in Lake Como Beach Subd.
Dec. 29-45
Lloyd S. Jensen
County Surveyor

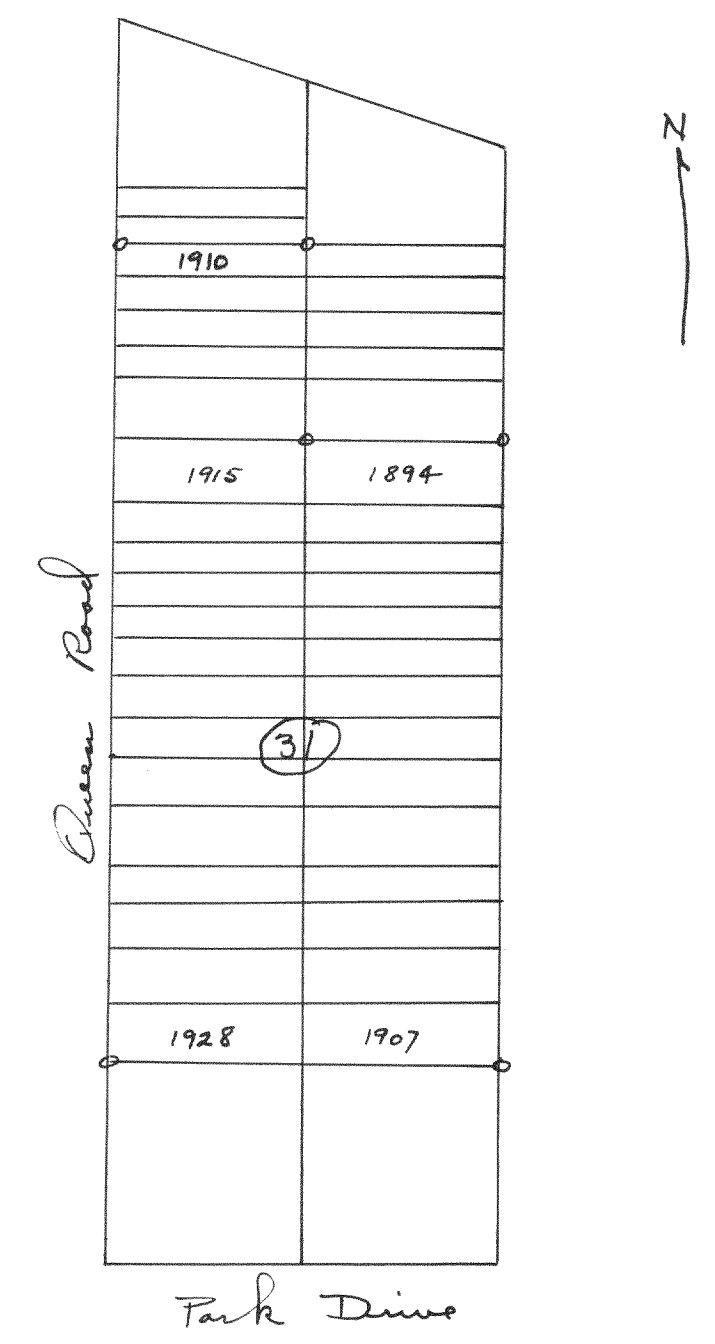

Plot of survey of lots at Lake Como Beach Subd.
Dec. 1945
Lloyd S. Jensen
County Surveyor

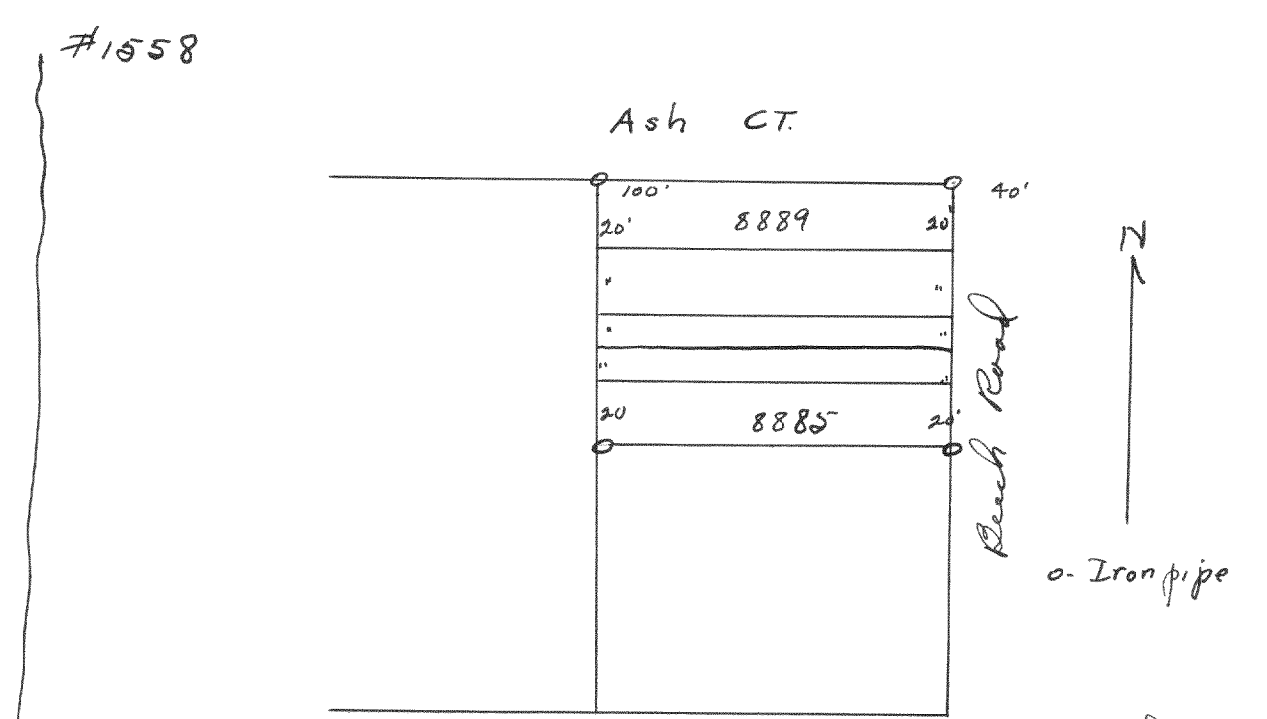

Plot of survey of lots in Lake Como Beach Subd.
10-31-45
Lloyd S. Jensen
County Surveyor

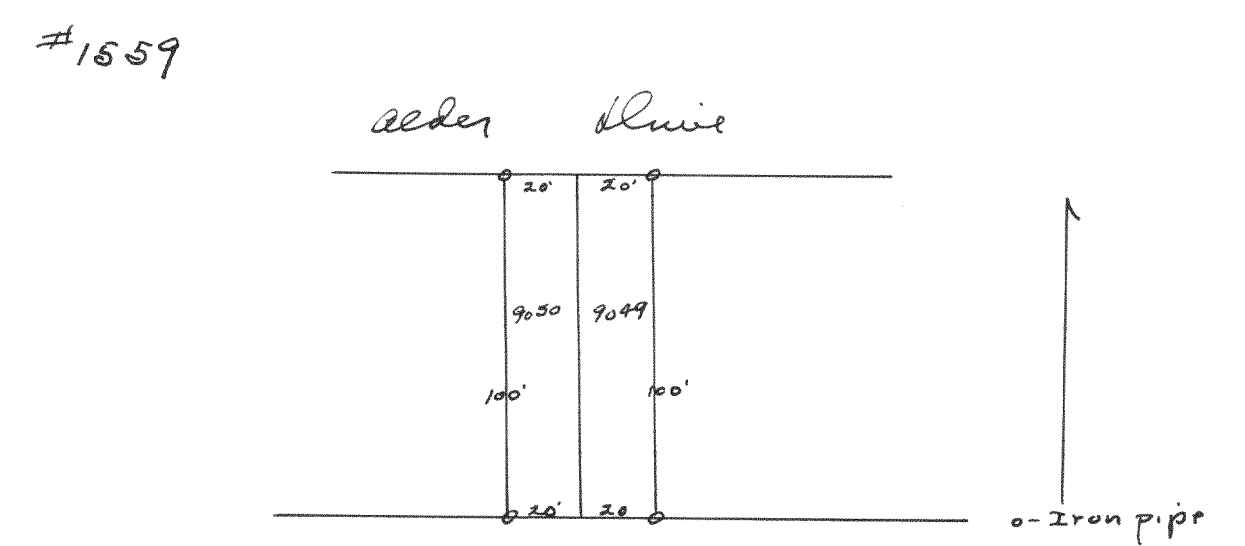

Plot of survey of lots at Lake Como Beach Subd.
10-31-45
Lloyd S. Jensen
County Surveyor