


#1560

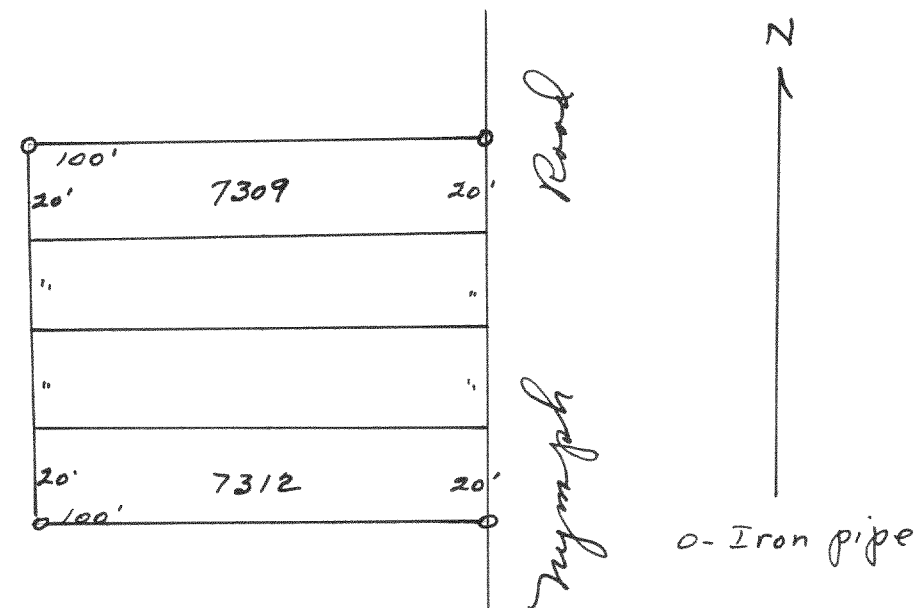


Plot of survey of lots in Lake Como Beach Subdivision.

Oct. 1945

Lloyd L. Jensen
County Surveyor

#1561

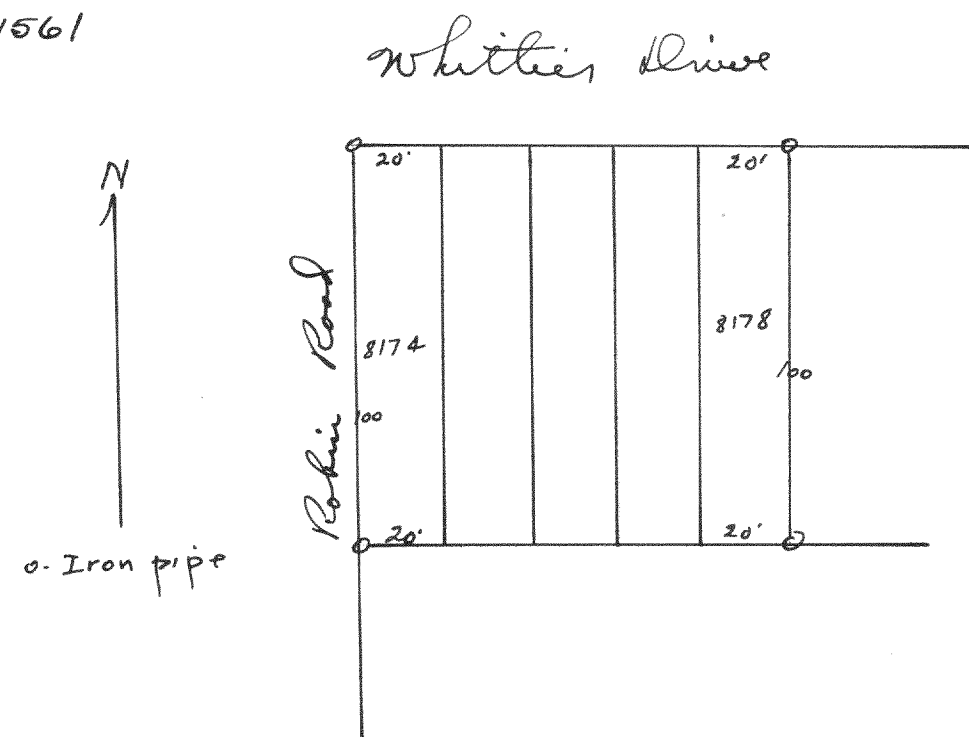


Plot of survey of lots in Lake Como Beach Subd.

Oct. 1945

Lloyd L. Jensen
County Surveyor

#1562

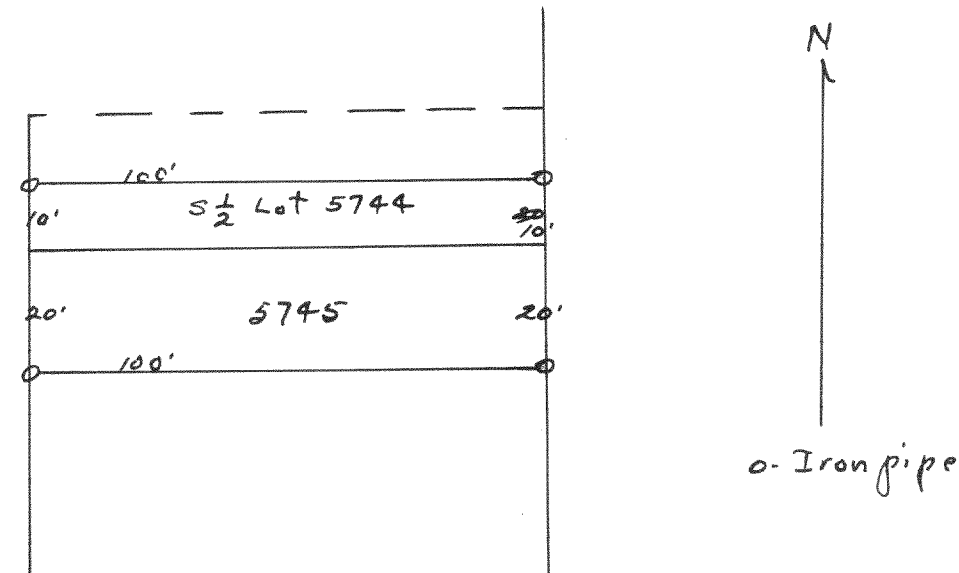


Plot of survey of lots in Lake Como Beach Subdivision.

10-29-45

Lloyd L. Jensen
County Surveyor

#1563

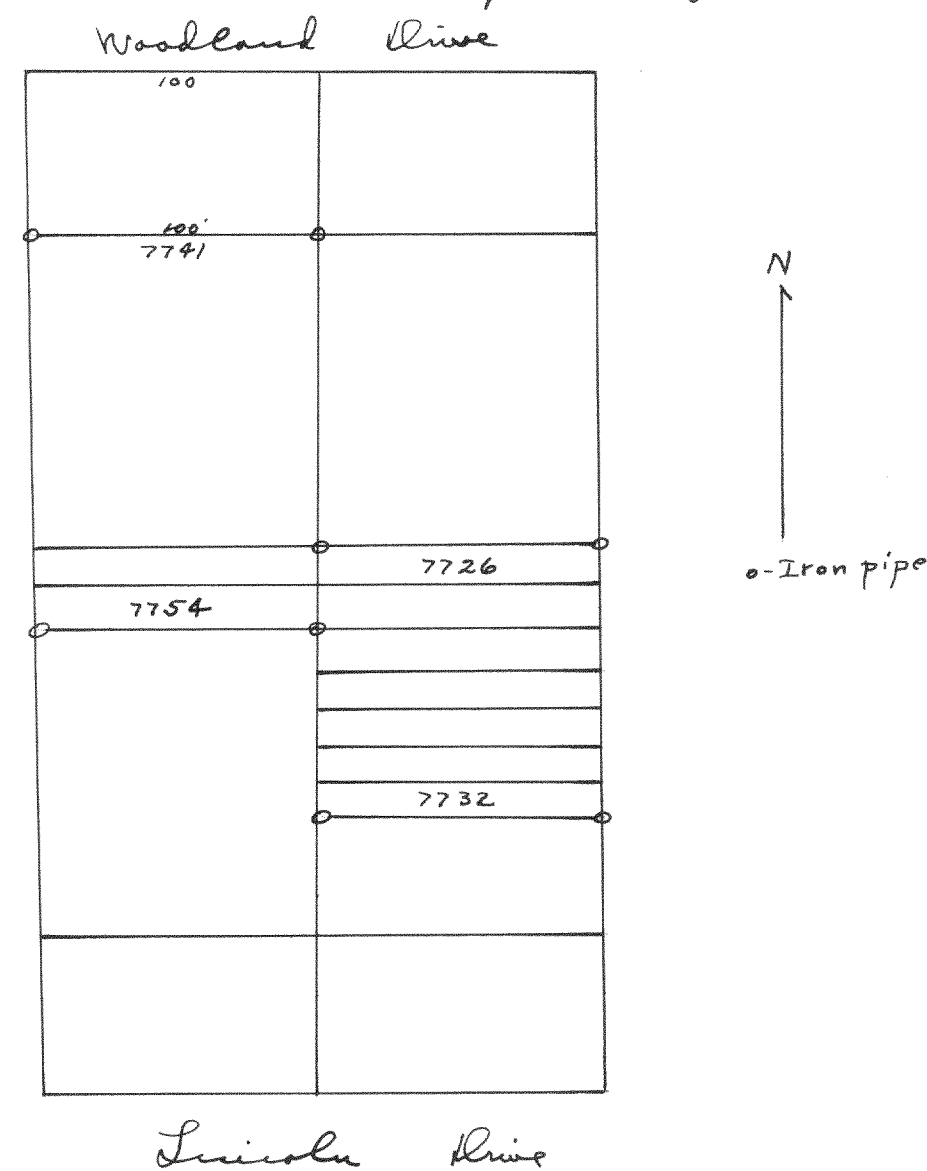


Plot of survey of lots in Lake Como Beach Subd.

10-15-45

Lloyd L. Jensen
County Surveyor

#1564

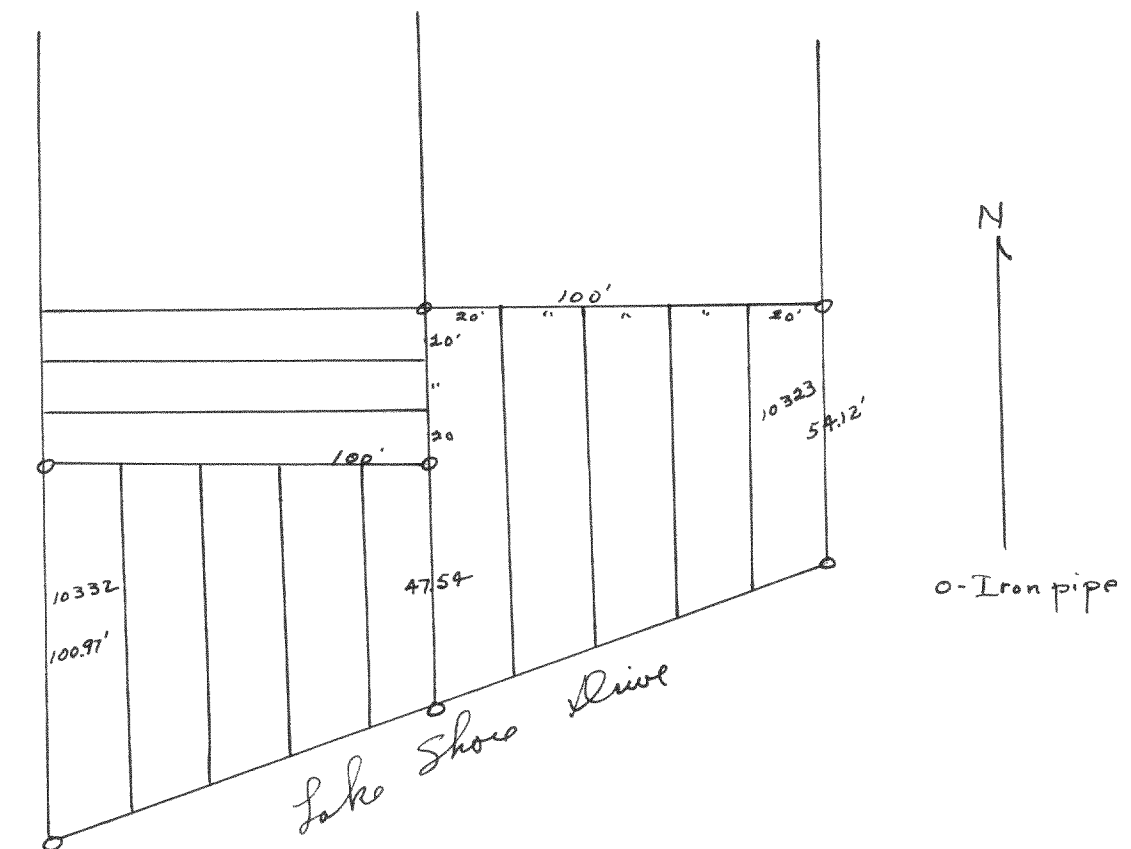


Plot of survey of lots in Lake Como Beach Subdivision.

Oct. 1945

Lloyd L. Jensen
County Surveyor

#1565

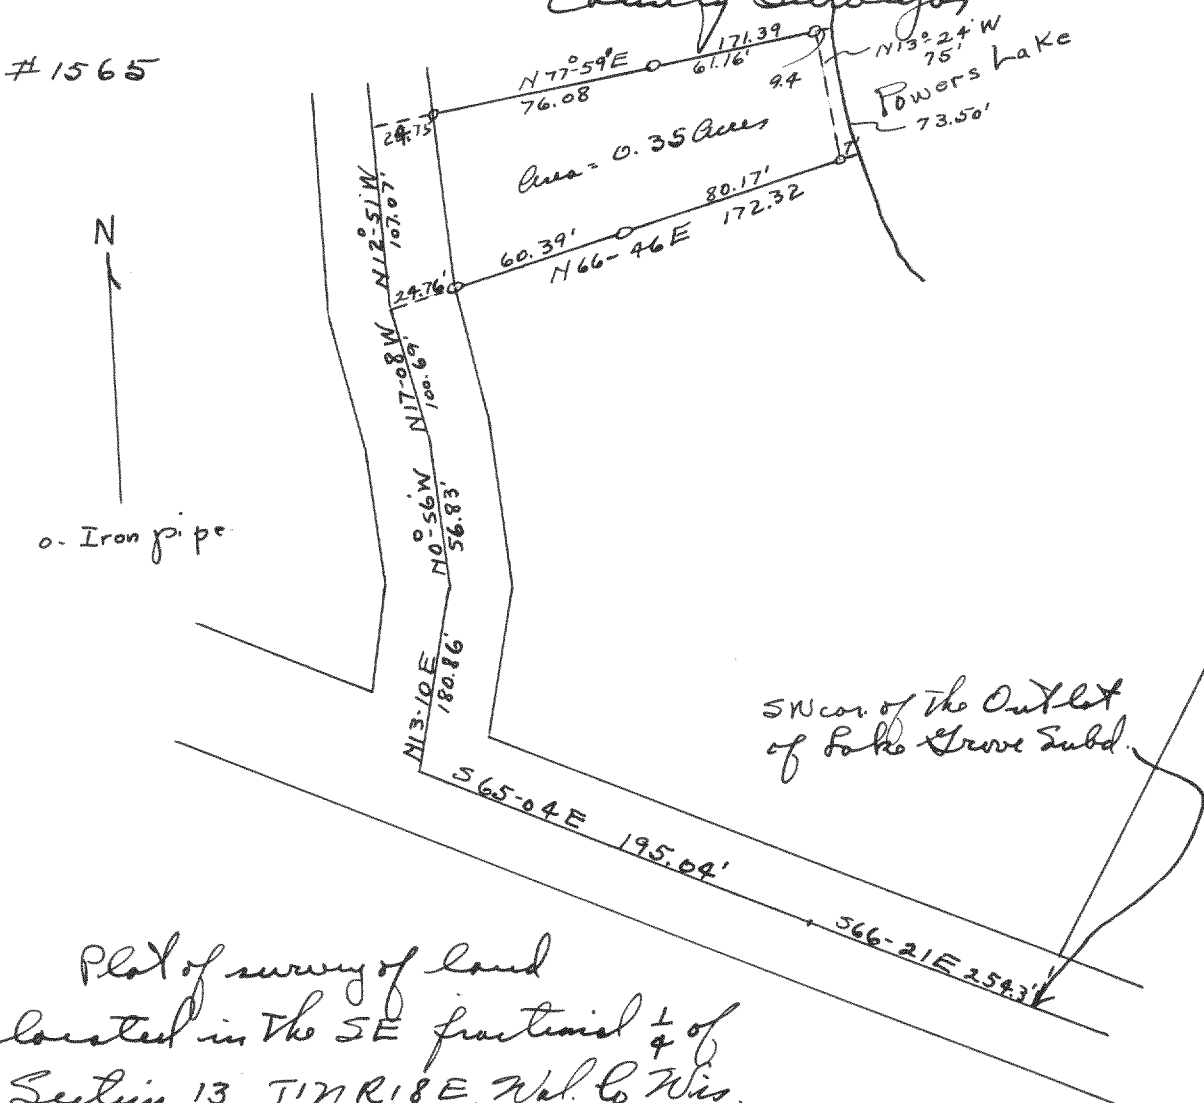

Plot of survey of land located in the SE fractional 1/4 of Section 13, T17N R18E, W4 to W10.

Sept. 22, 1945

Lloyd L. Jensen
County Surveyor