



#1570

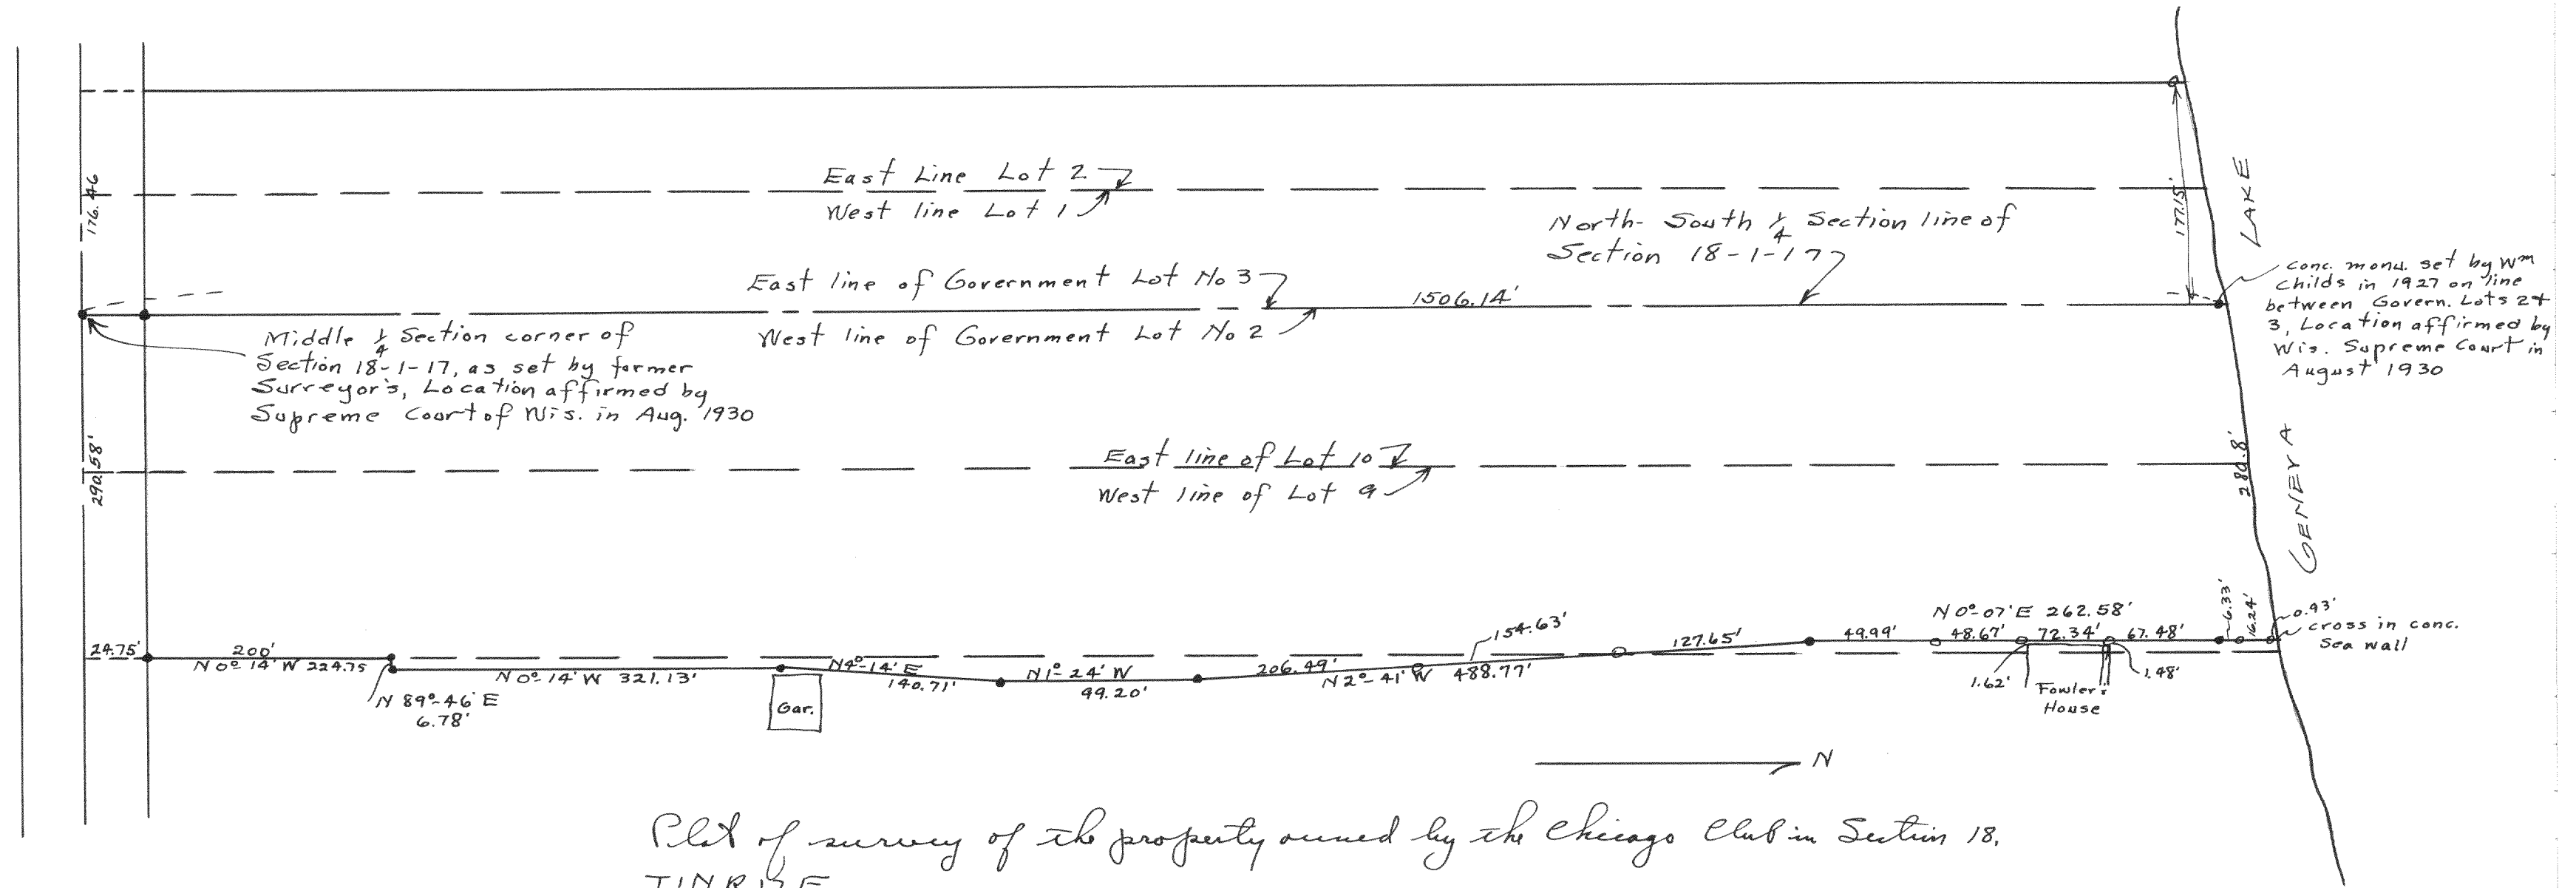

Plot of survey of the property owned by the Chicago Club in Section 18,
T1N R17E.
Nov. 1944

Lloyd S. Jensen
County Surveyor

#1571

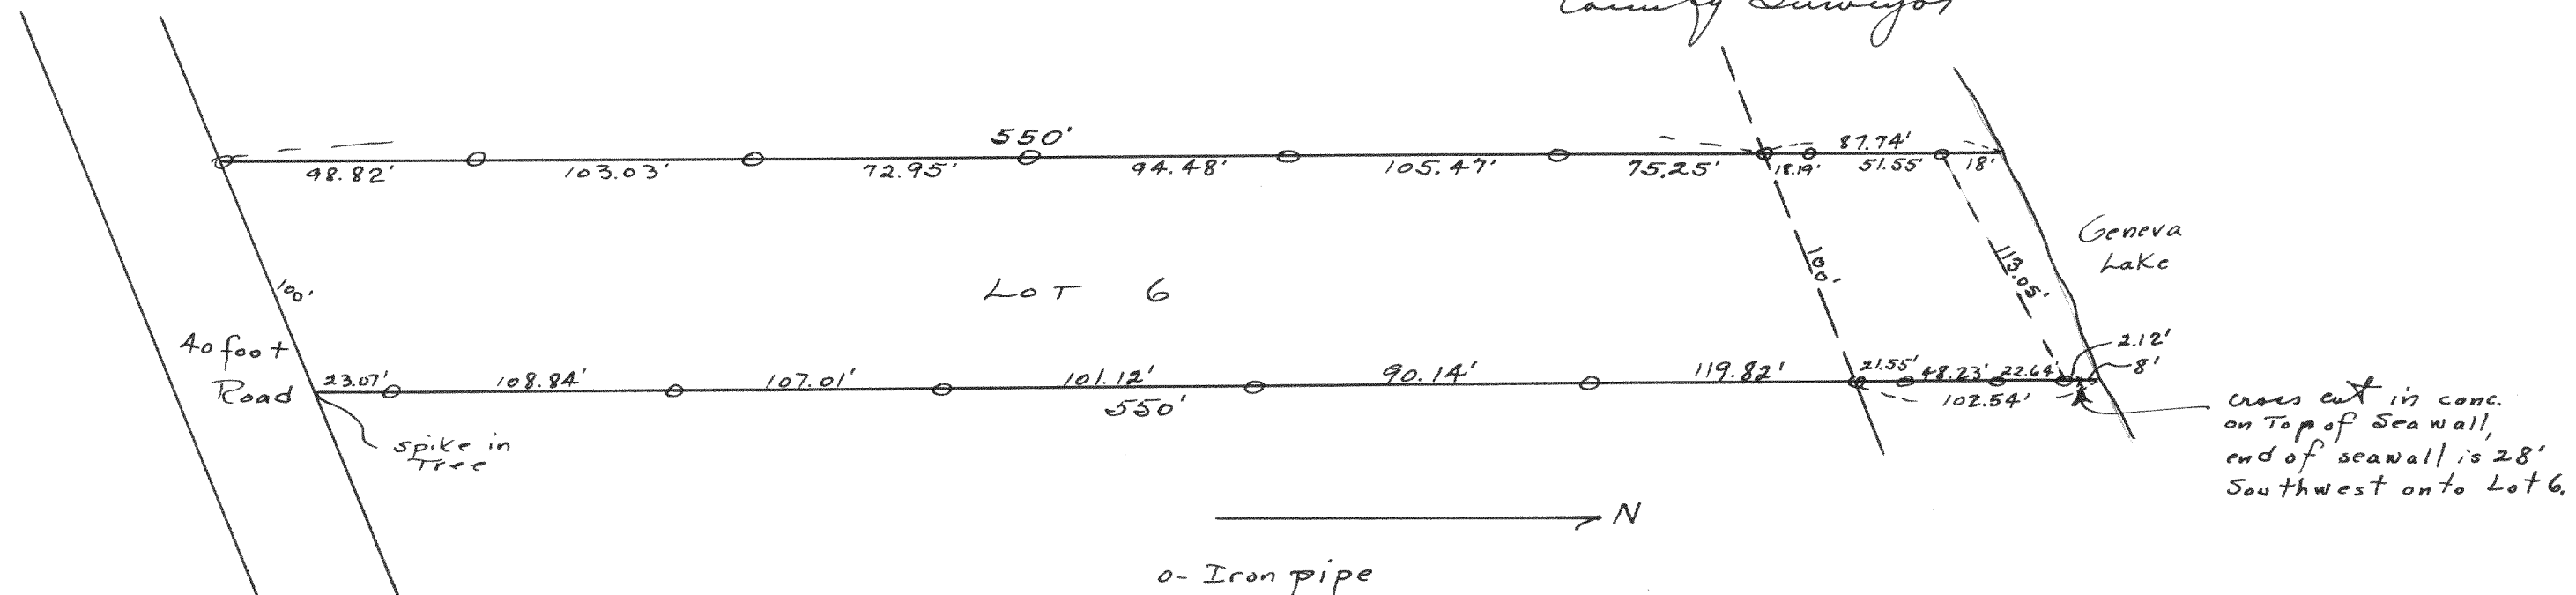

Plot of survey of Lot 6 of the Birches, a Subdivision located
in Section 10, T1N R17E, Walworth County Wisconsin.

Oct. 1, 1945

Lloyd S. Jensen
County Surveyor