


#1586

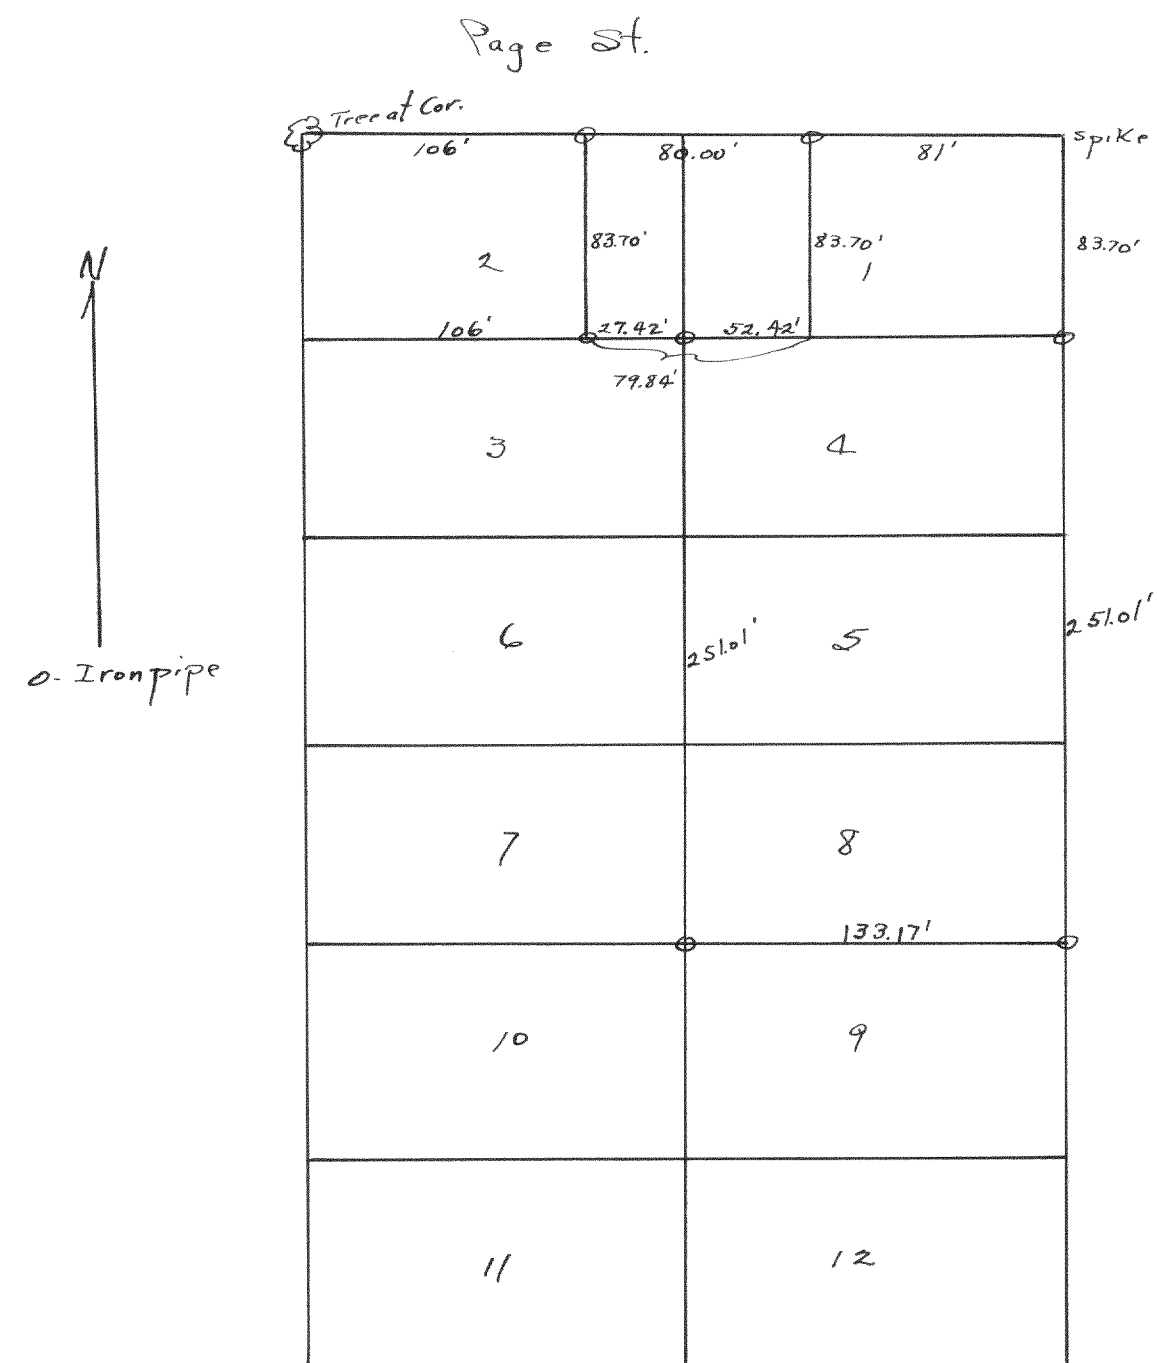


Plot of survey of part of Blk 12 of
Rockwell, Add. to City of
Elkhorn.

May 5, 1945

Lloyd S. Jensen
County Surveyor

#1587

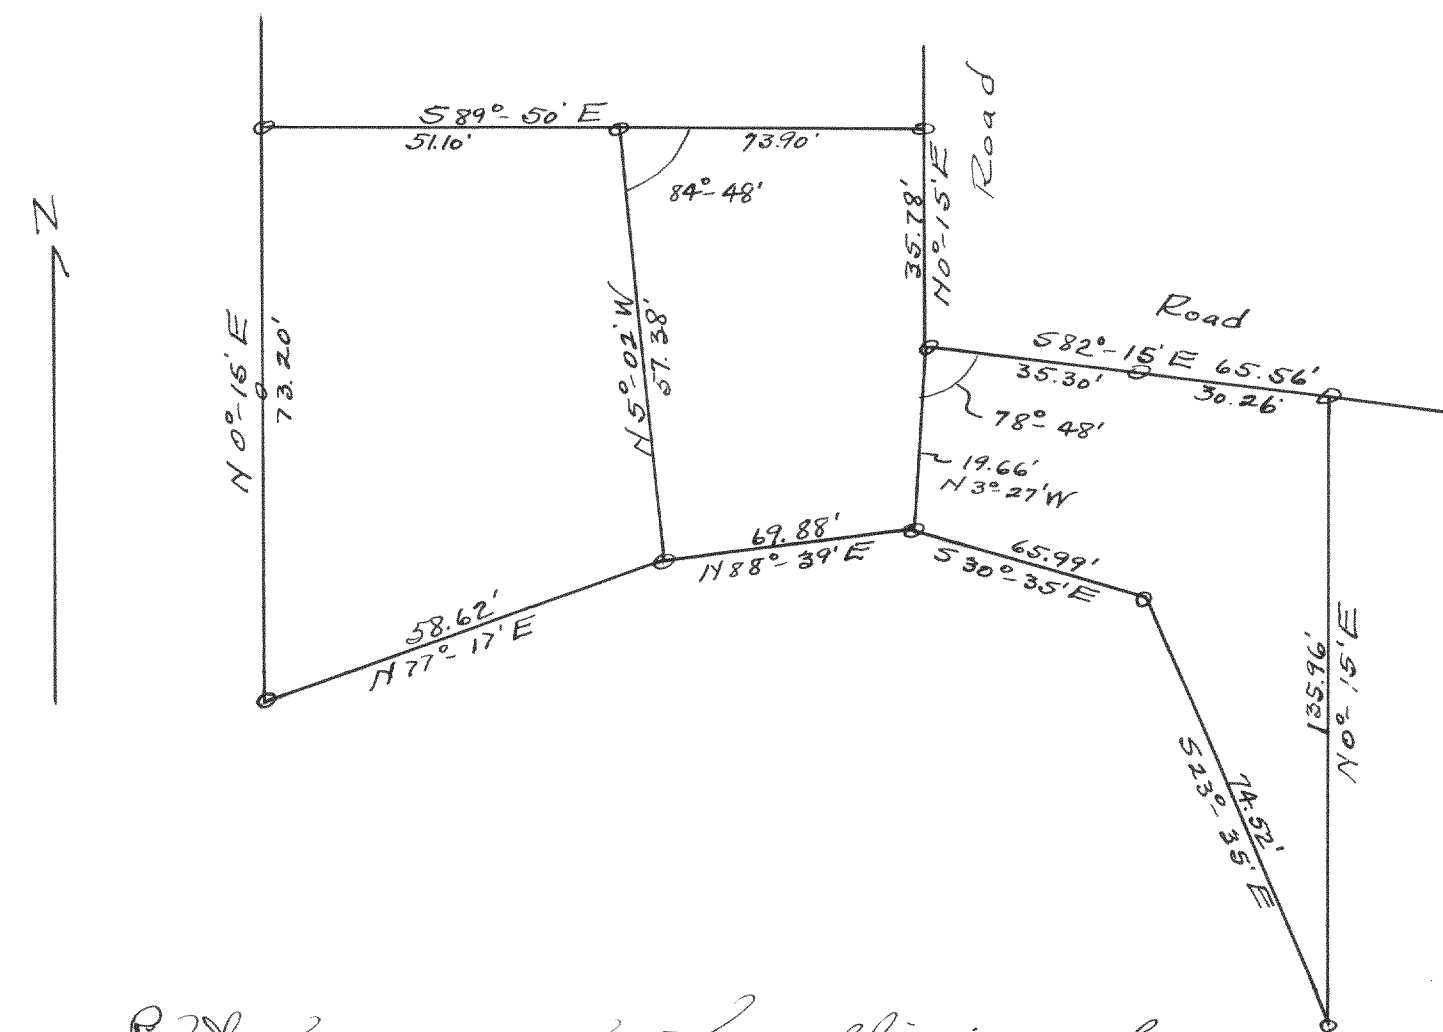

Plot of survey of the subdivision of
Lot 60 of the unrecorded plat of
Lockwoods Subd.

July 23, 1945

Lloyd S. Jensen
County Surveyor