


#1592

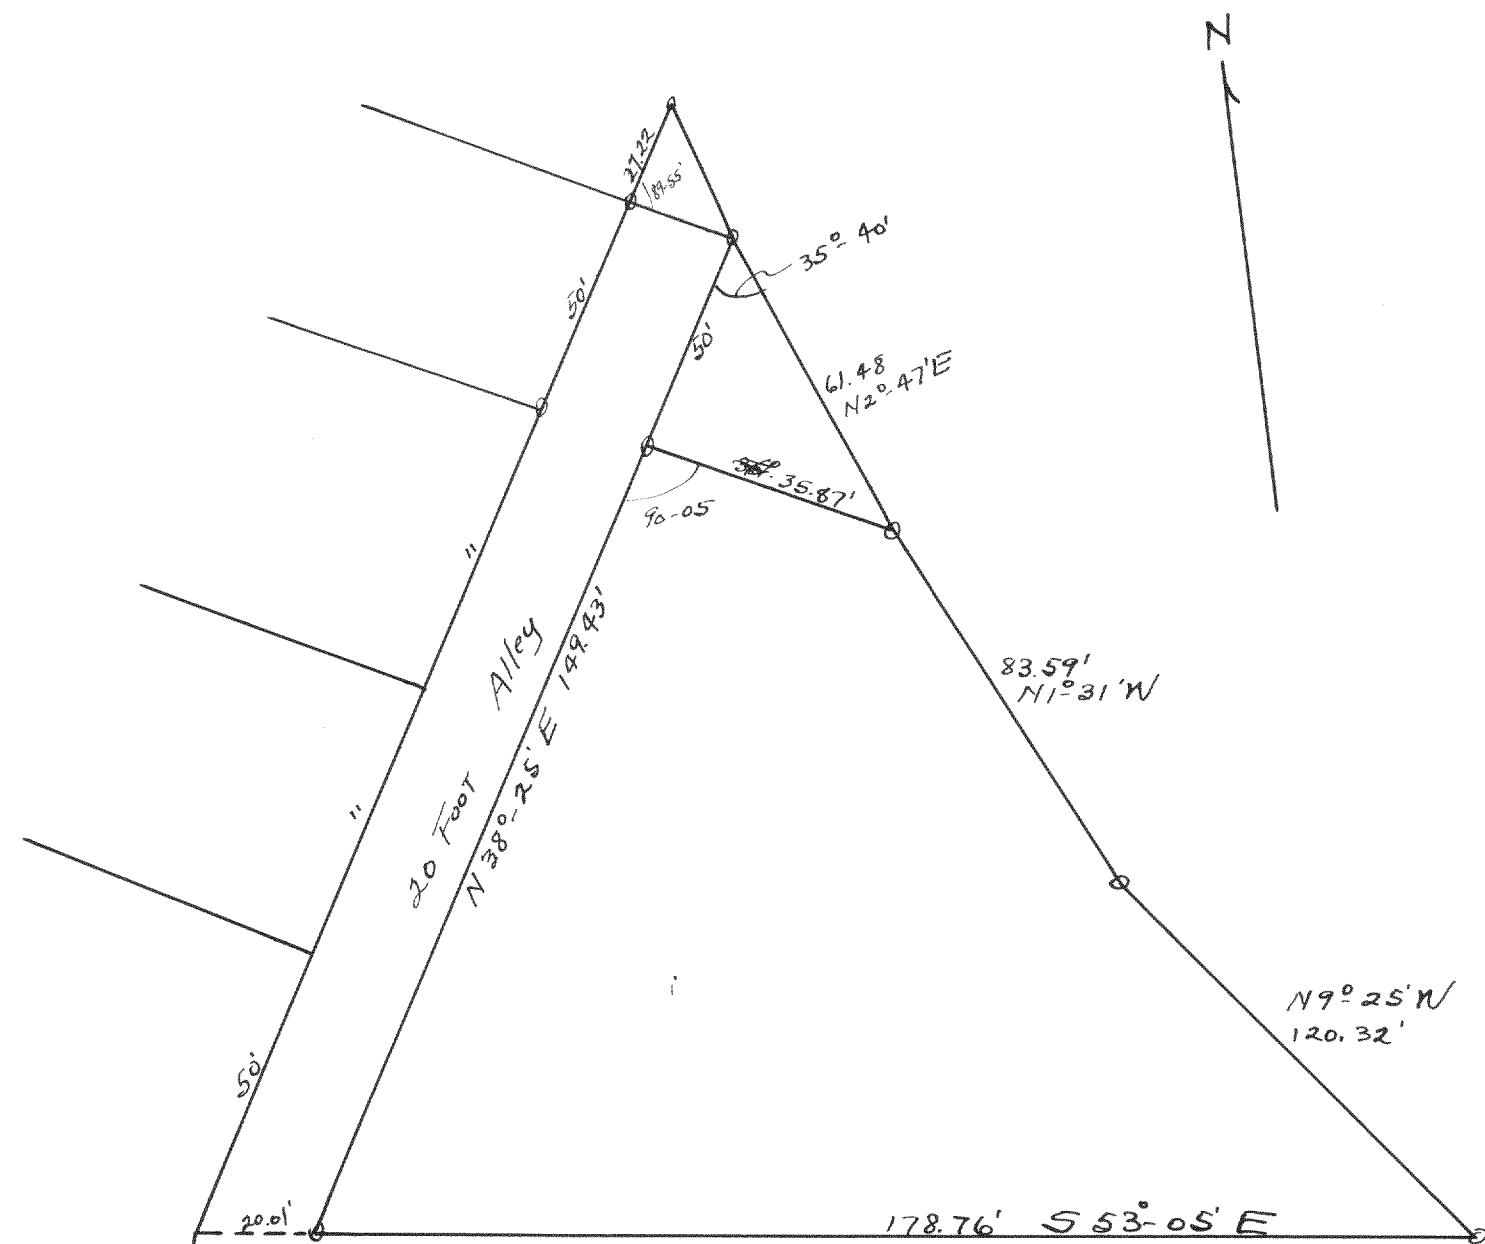


This point is located as follows -
Commencing at the SE. cor. of Mereness Springs
Subd.: Thence $N 66^{\circ} 25' E$ along a line which is the
S. line of said plat produced 152' to a pt. in the E.
of the public Road: Th $N 38^{\circ} 25' E$ alg. sd. E. 556';
Th $S 51^{\circ} 35' E$ 125' to p. o. b.

Plot of survey of a parcel of land located
in the Southeast fractional $\frac{1}{4}$ of Section 22,
T27N R16E.

Sept. 21, 1945

Lloyd L. Jensen
County Surveyor

#1593

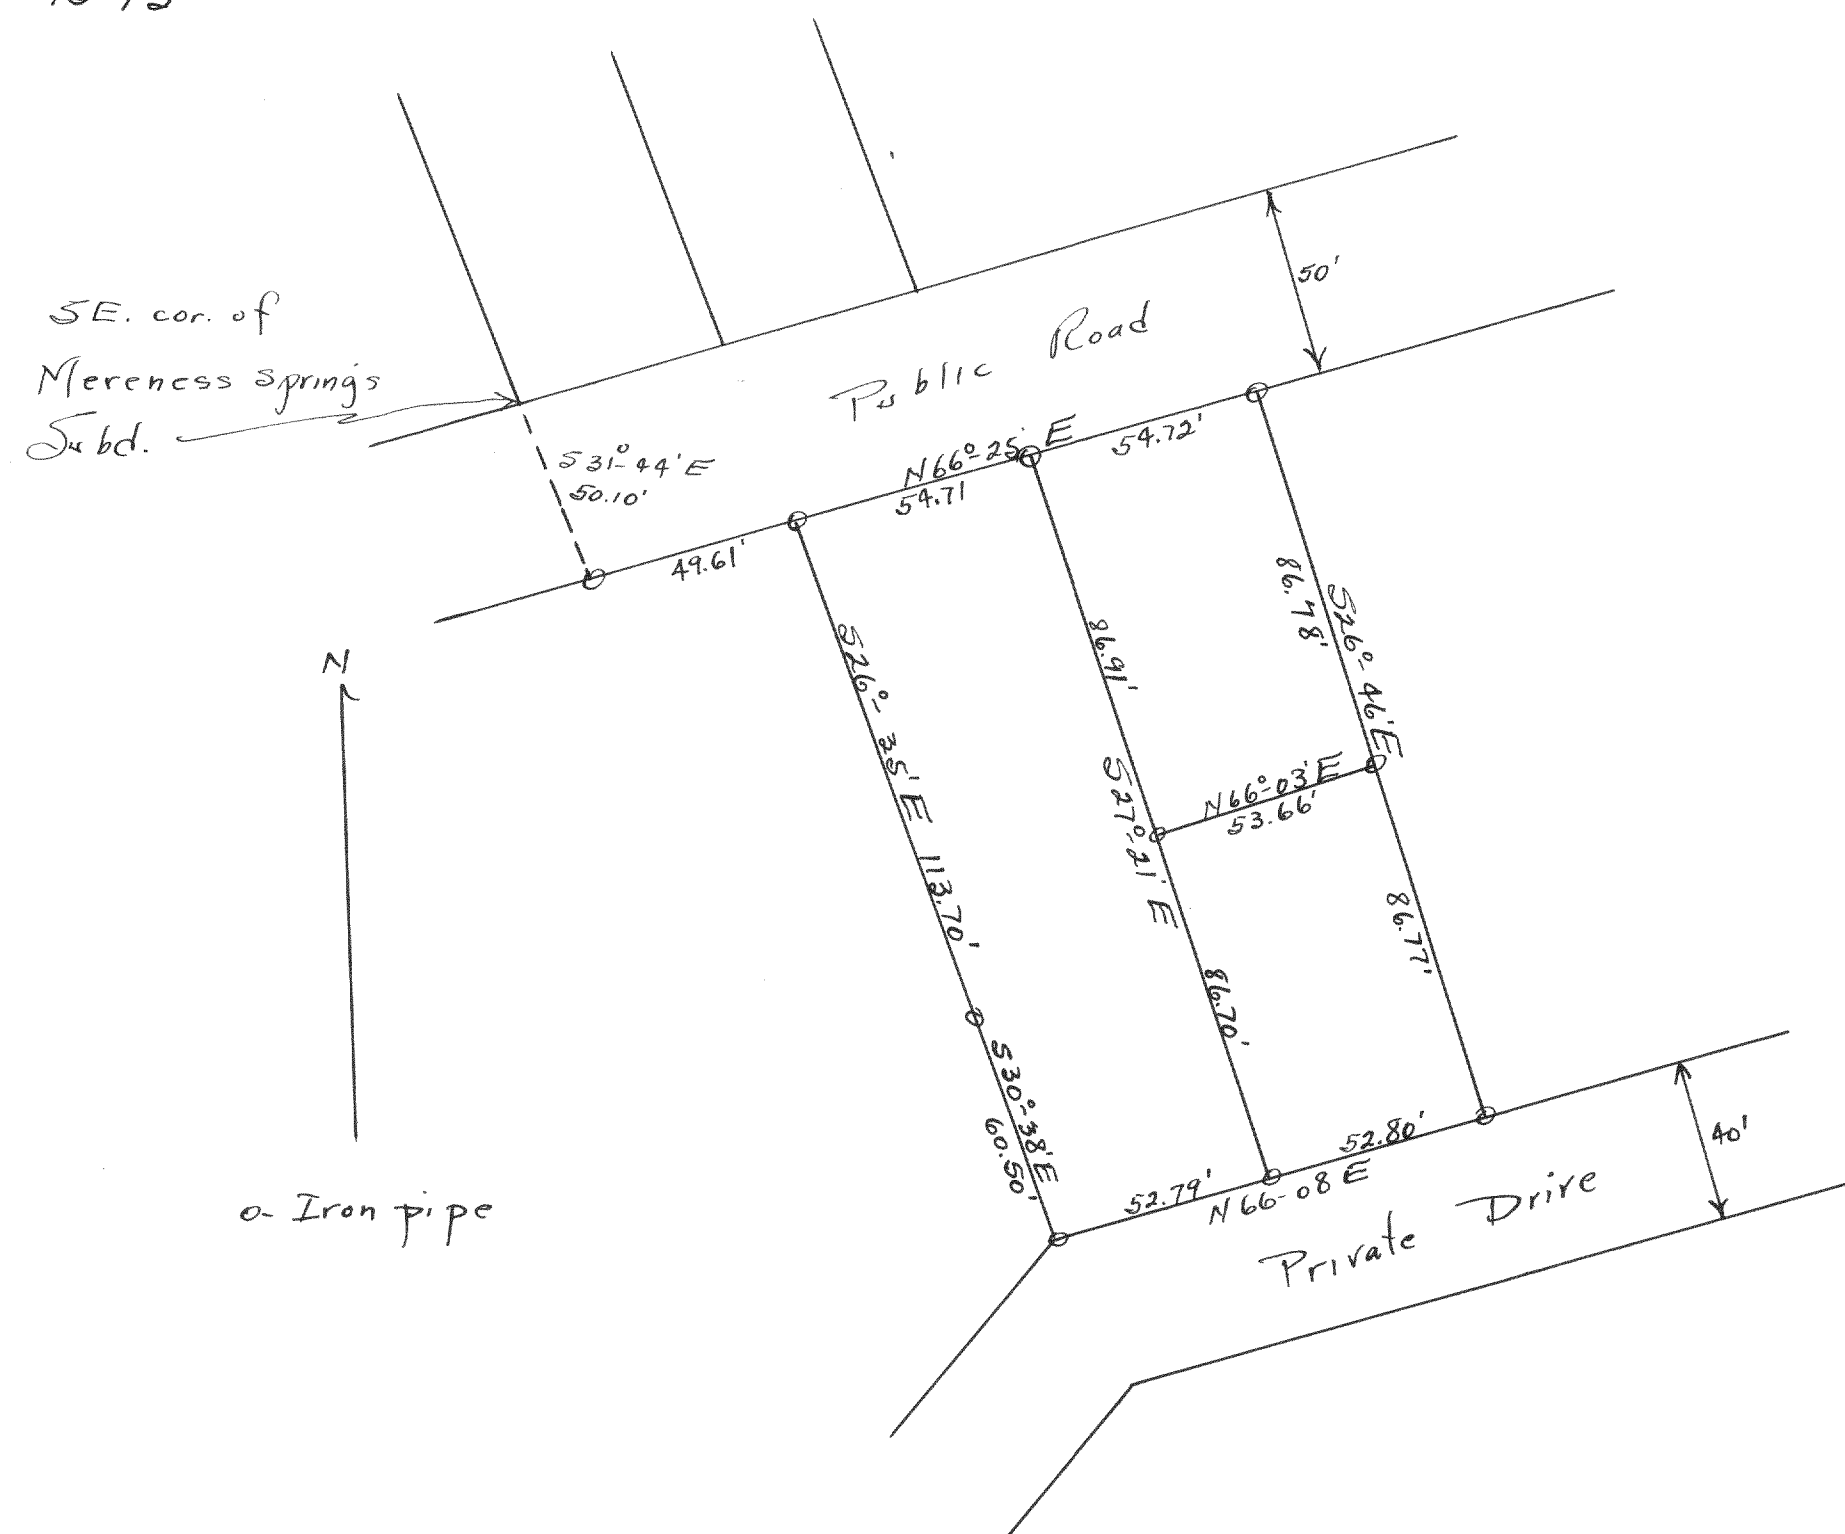

Plot of survey of 3 parcels of land
located in the Southeast $\frac{1}{4}$ of Section
22, T2N R16E, Walworth County
Wisconsin.

July 1945

Lloyd L. Jensen
County Surveyor