



#1596

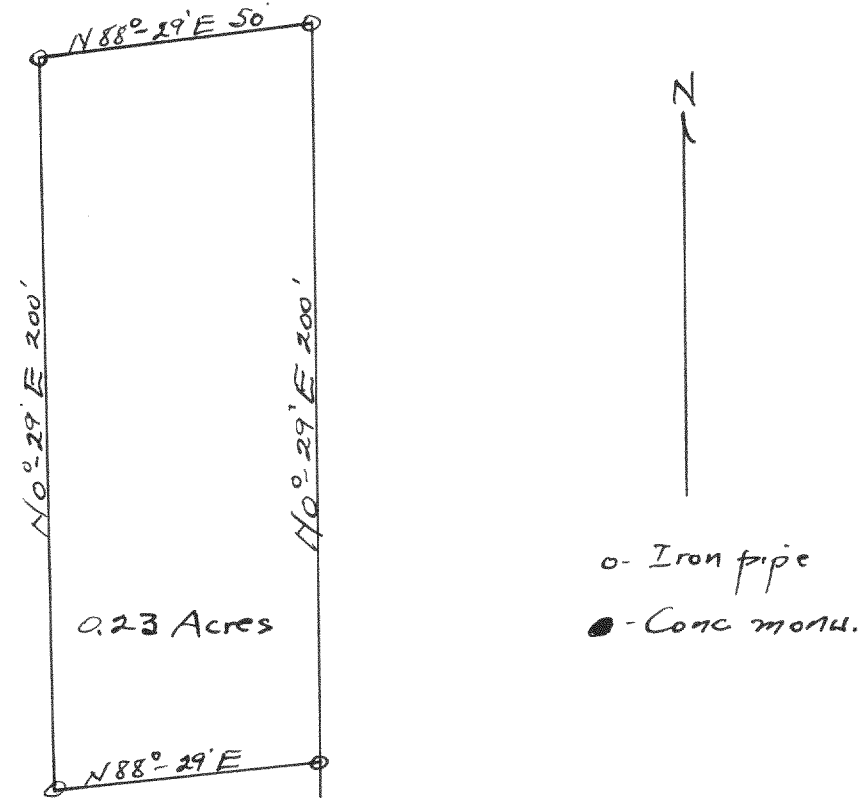

Plot of survey of a parcel of land
located in the SE $\frac{1}{4}$ of
fractional Section 22, T2N R16E
Sept. 20, 1945 Lloyd S. Jensen
County Surveyor

SE. cor. of Section 22

#1597

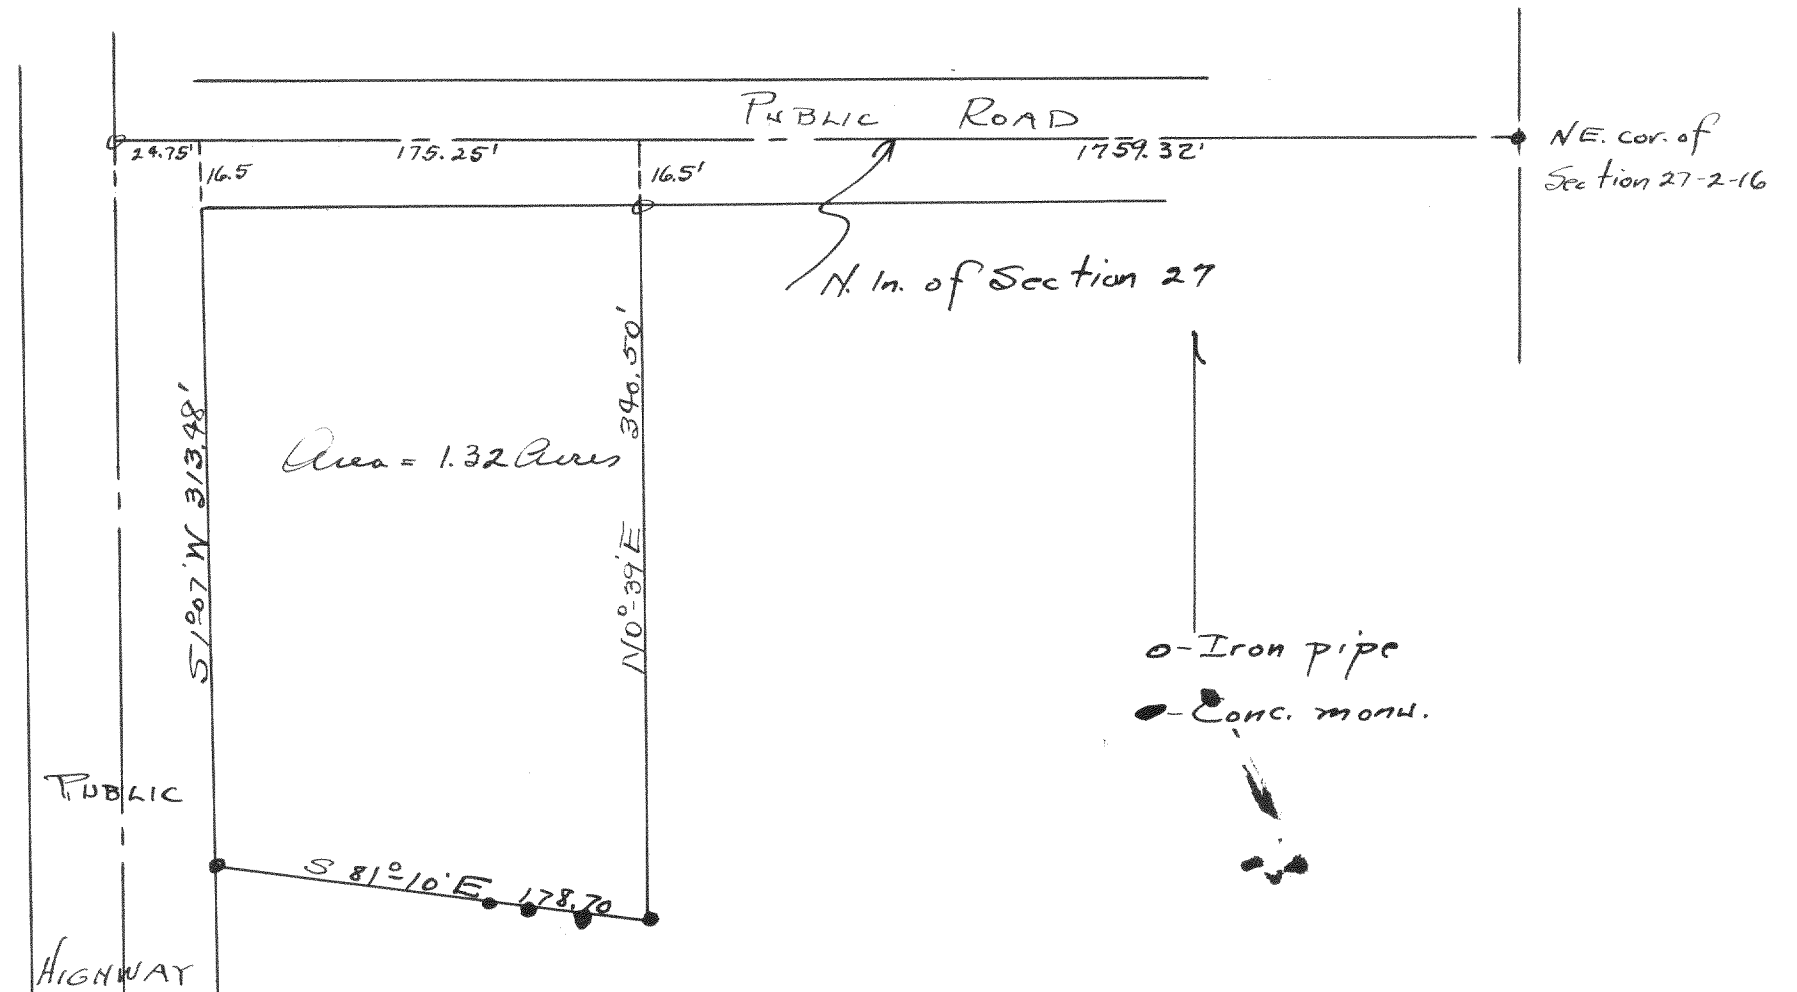

Plot of survey of part of the northeast
fractional $\frac{1}{4}$ of Section 27, T2N R16E.
Lloyd S. Jensen
Dec. 1945 County Surveyor