


#1598



#1599

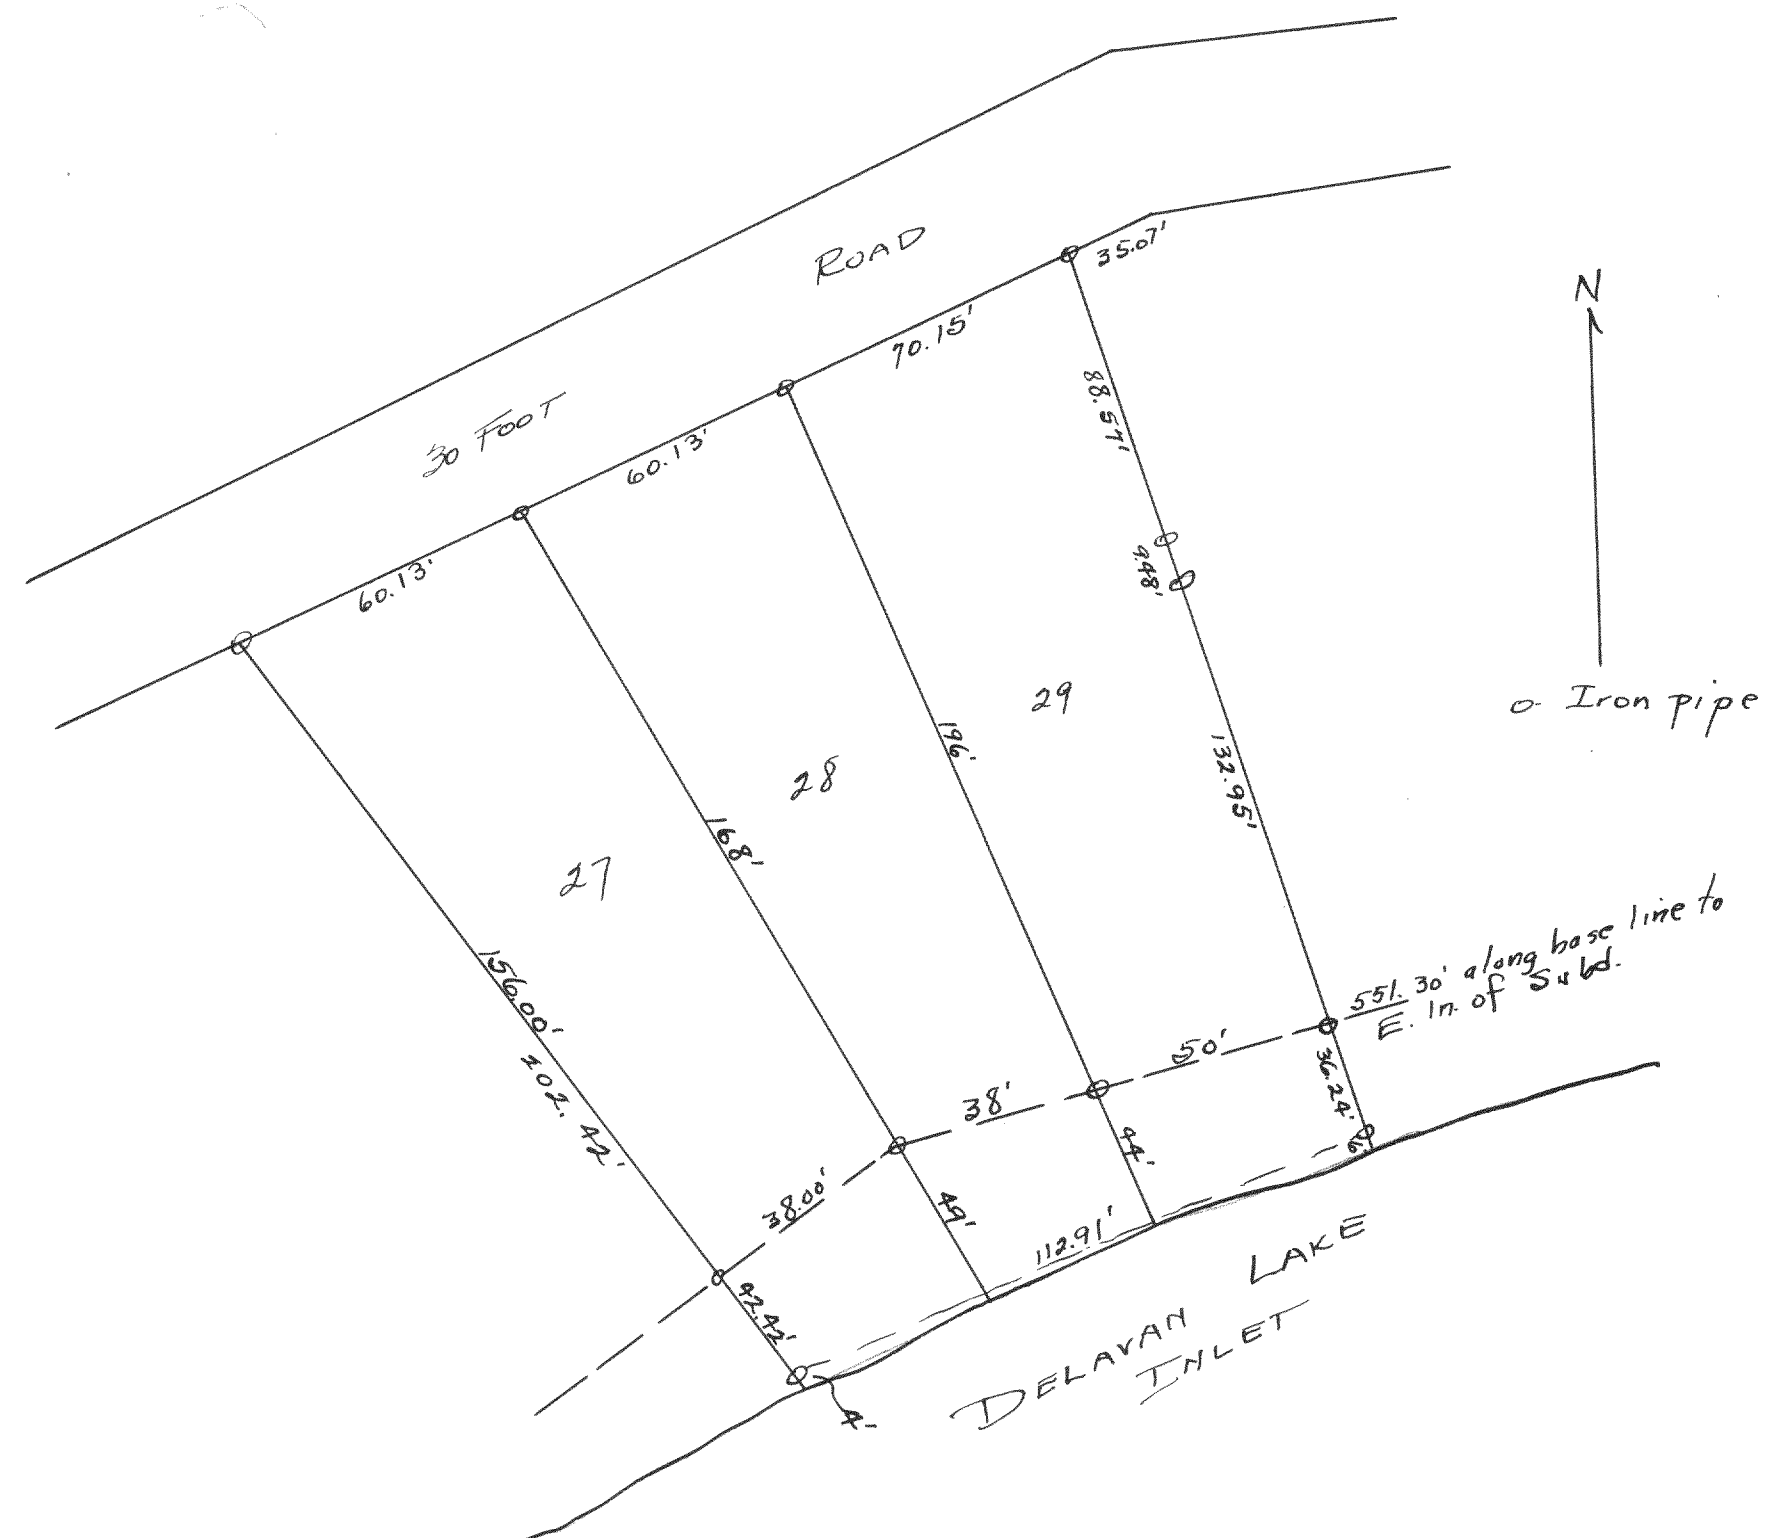