


#1600

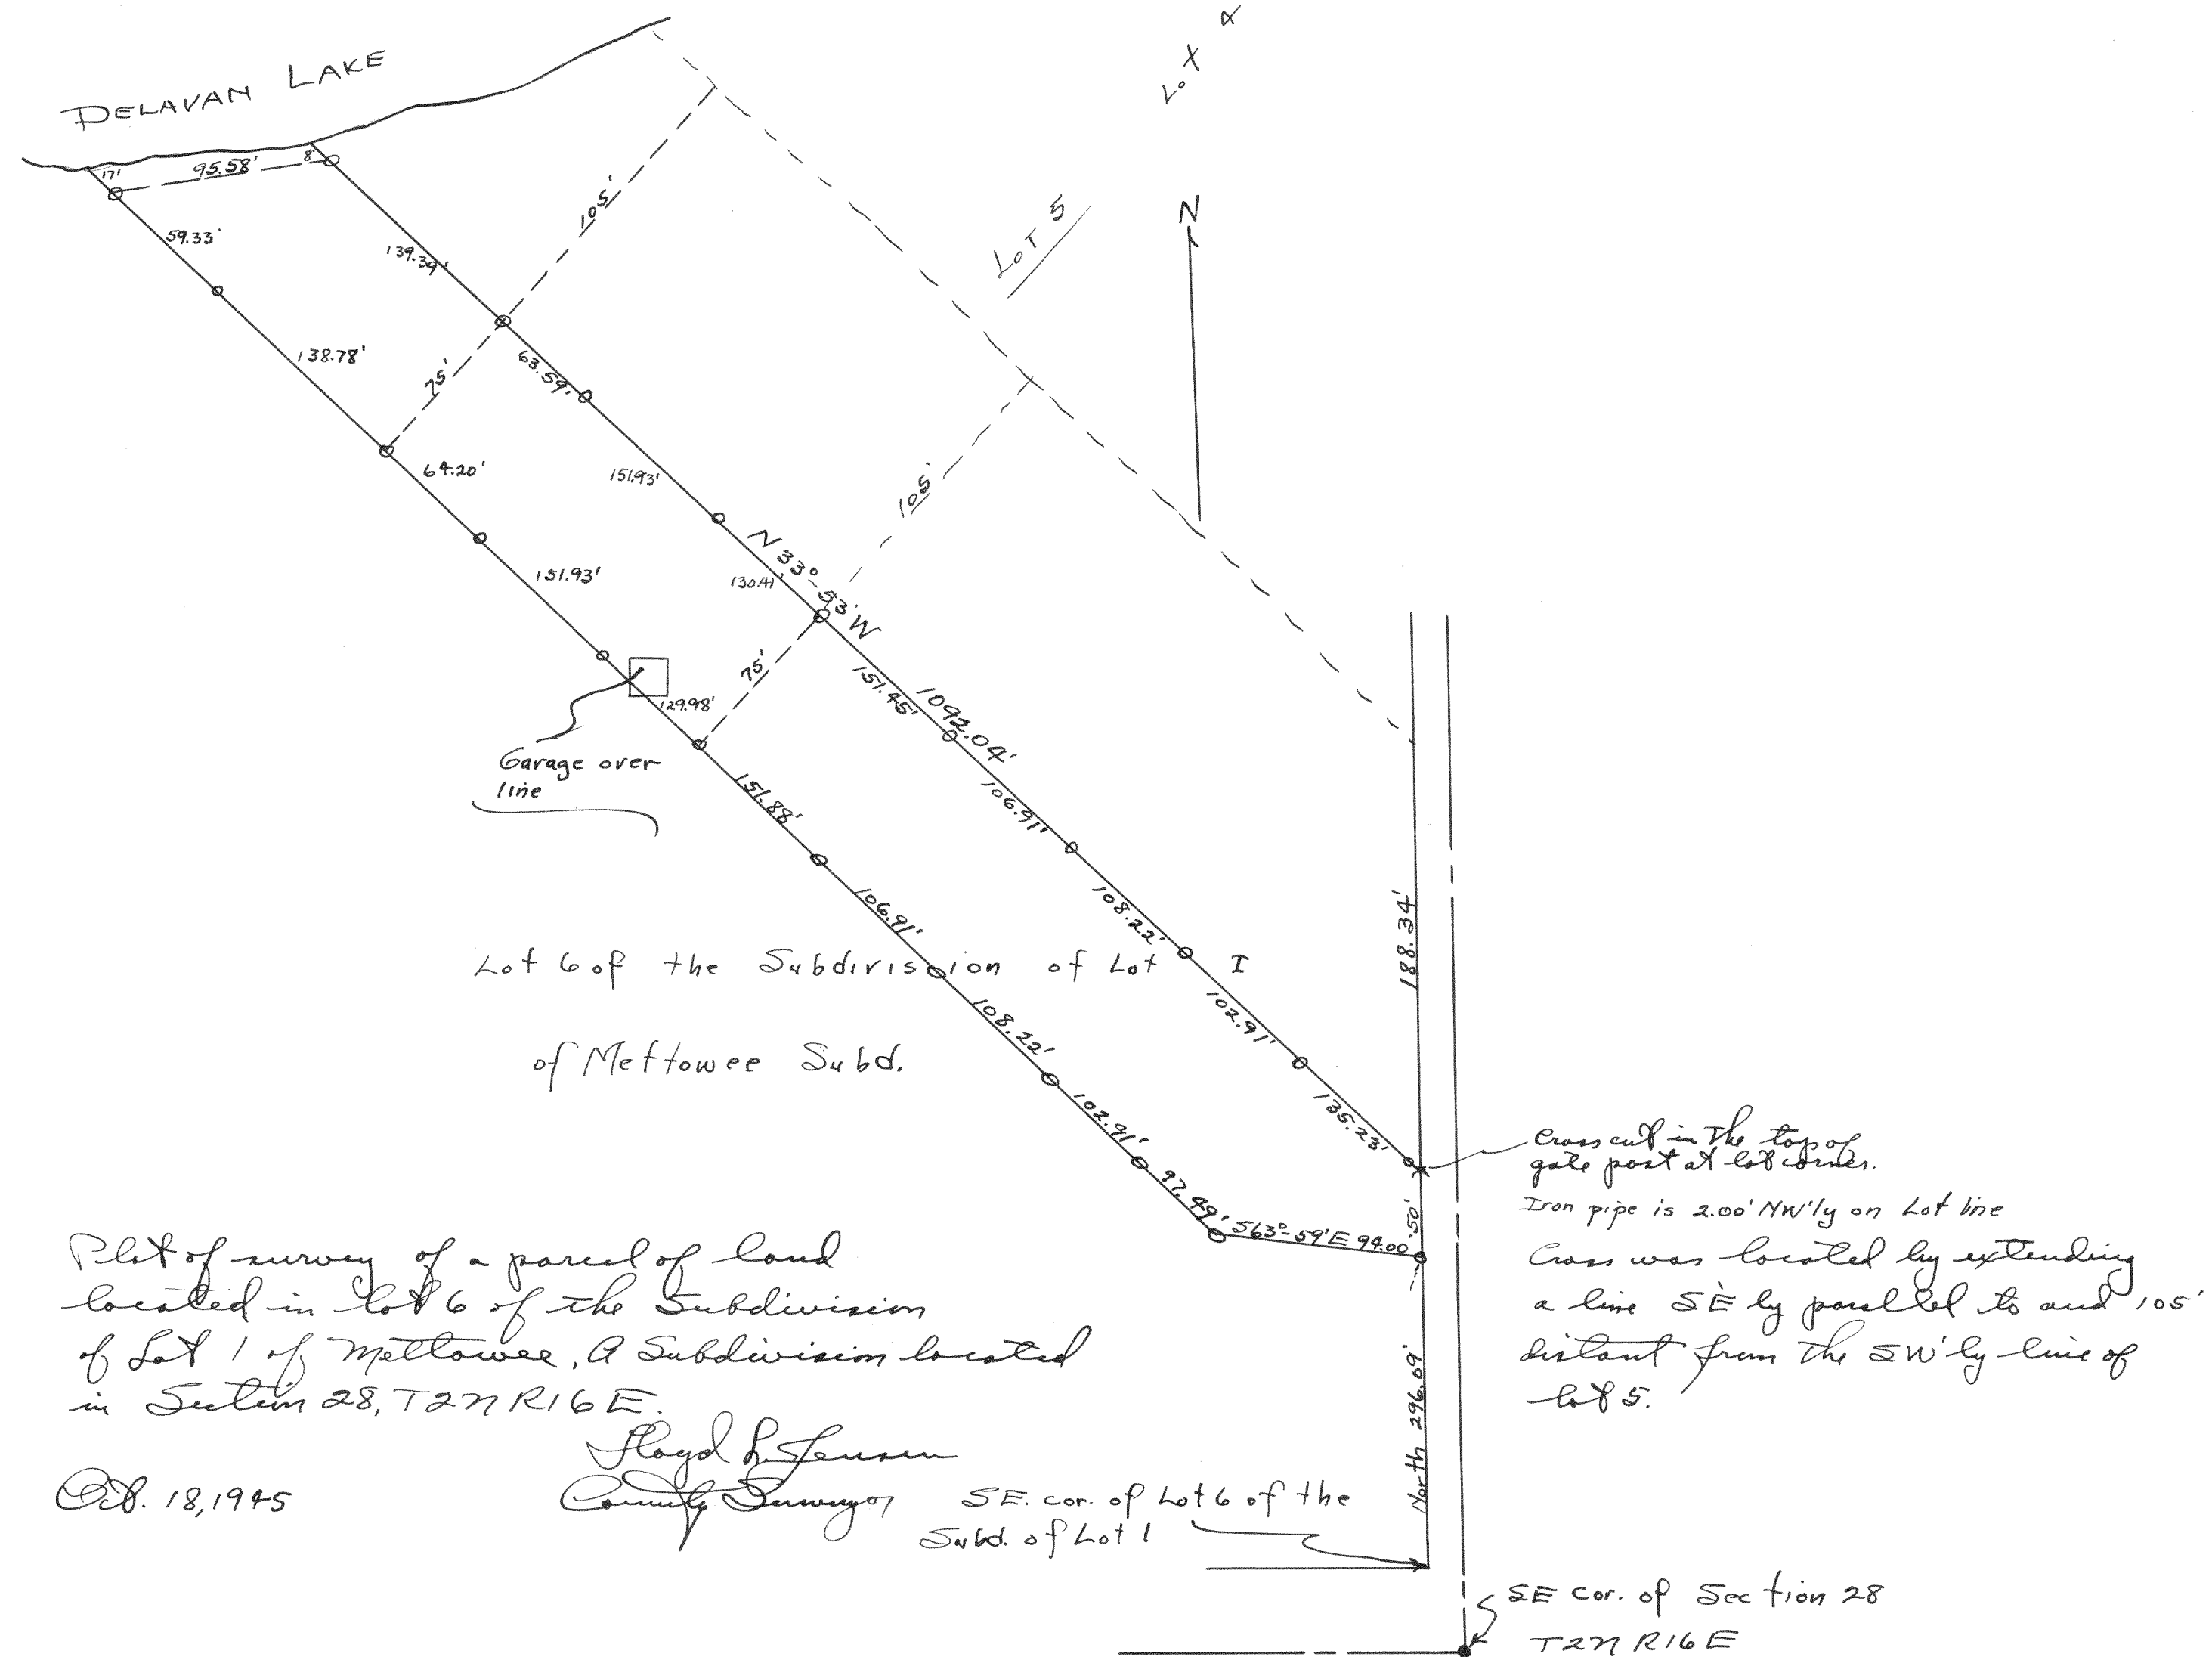

Oct. 18, 1945

Royal L. Jensen
County Surveyor

SE. cor. of Lot 6 of the
Subd. of Lot 1

SE. cor. of Lot 6 of the
Subd. of Lot 1