



#1601

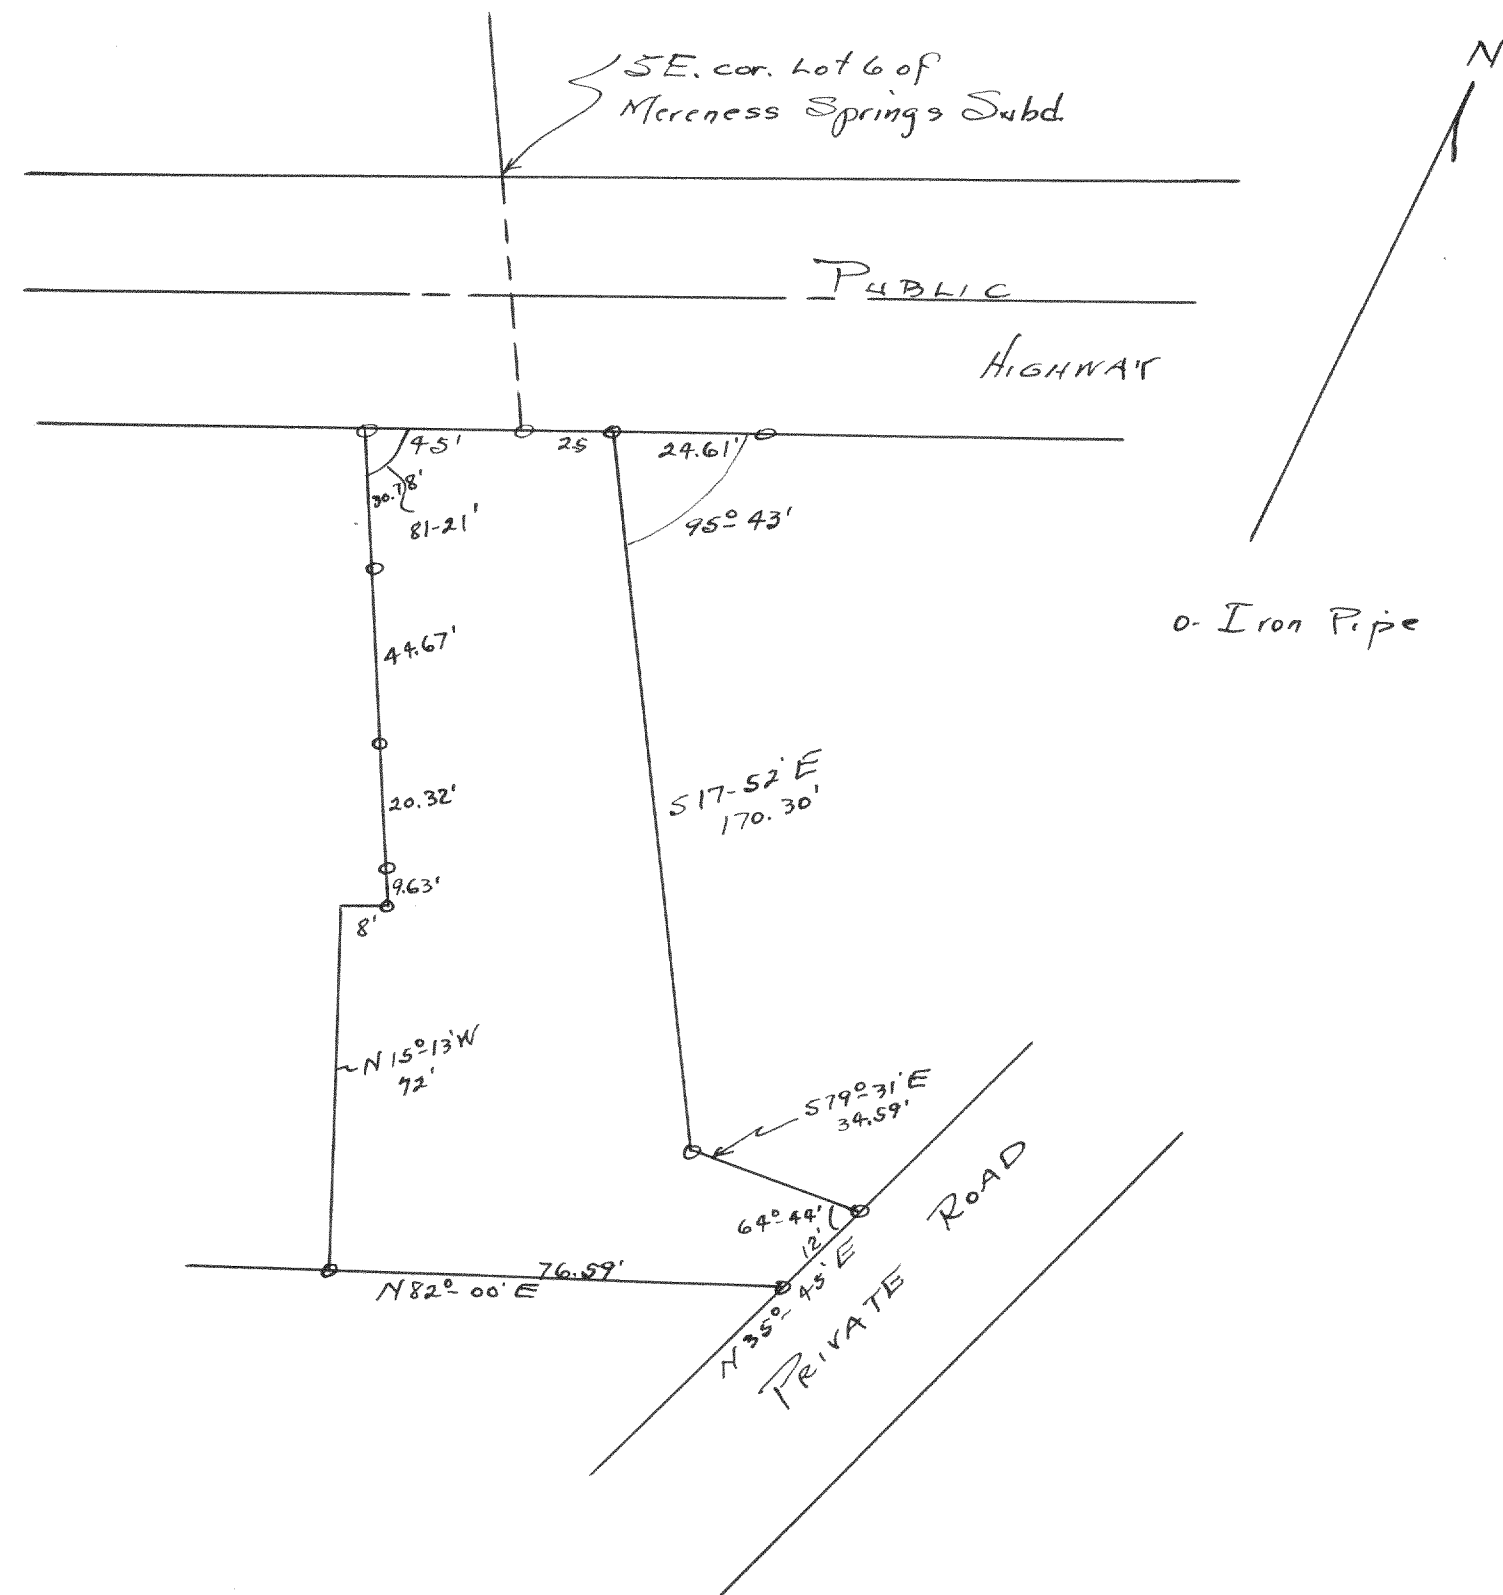

Plot of a survey of land located
in the SE $\frac{1}{4}$ of Section 22, T27N R16E
Lloyd R. Jensen
County Surveyor
Sept. 20, 1945

#1602

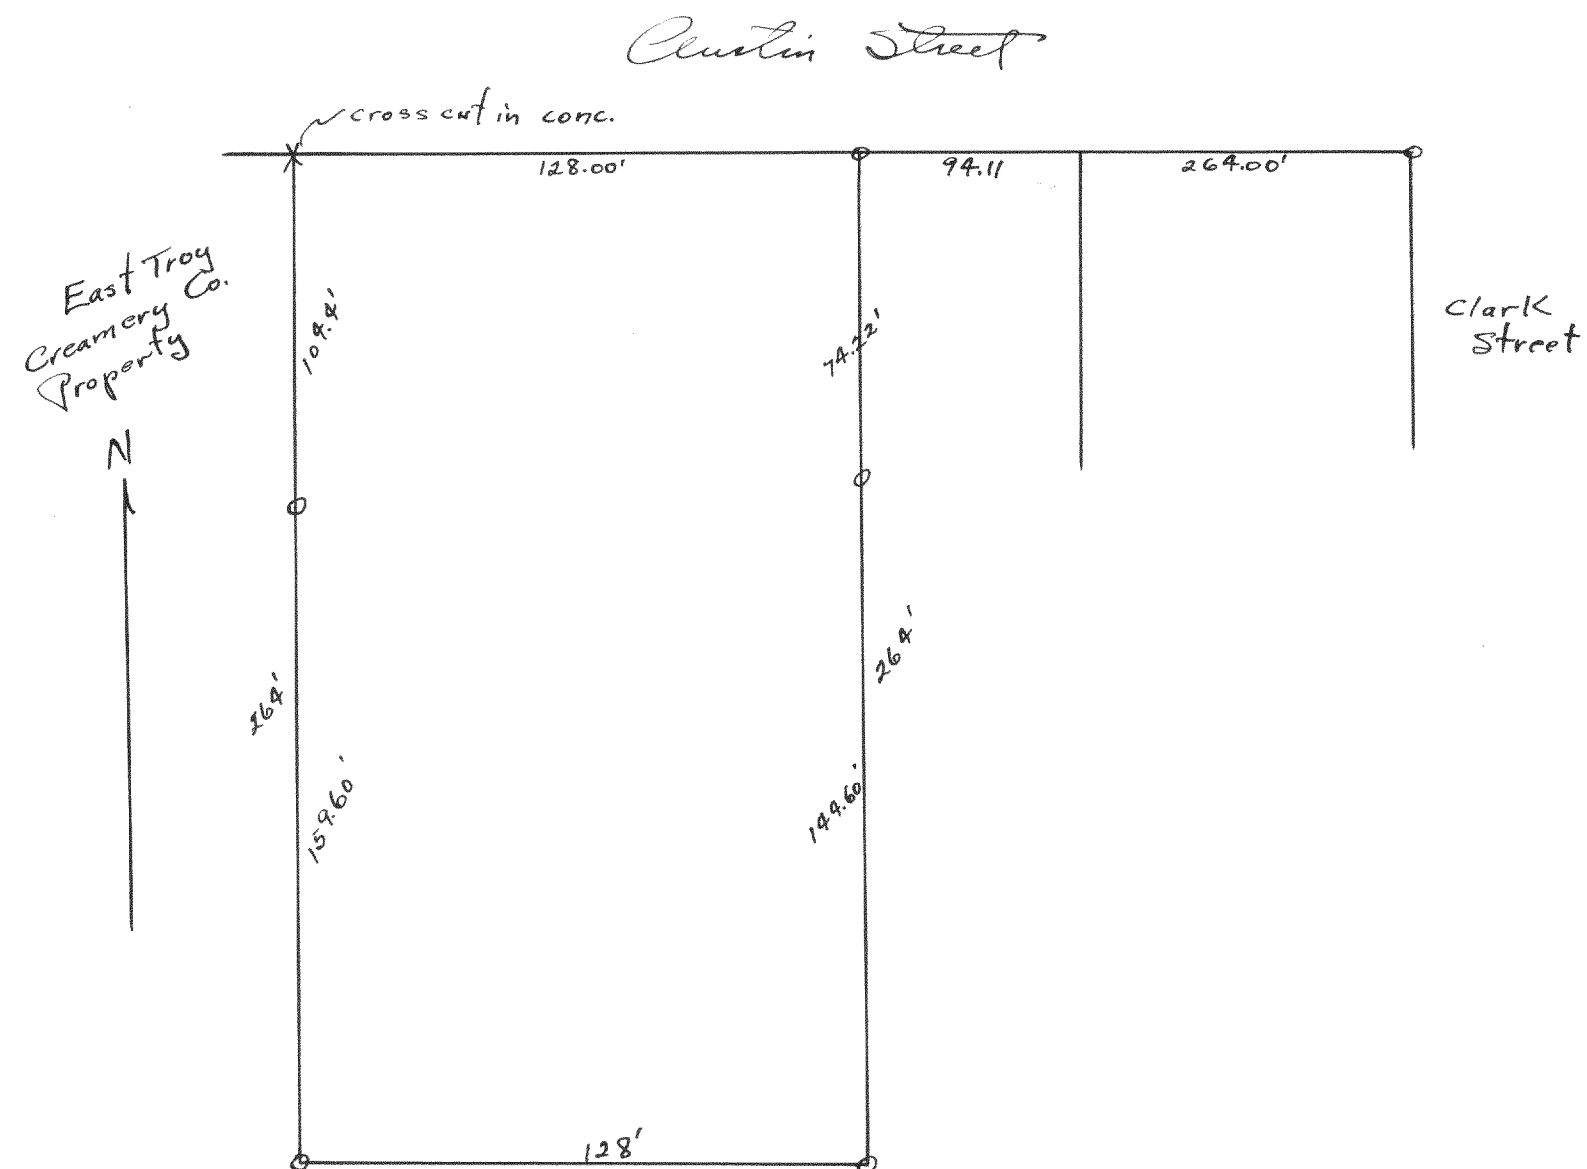

Plot of survey of a parcel of land located
in the Village of East Troy, Walworth
County Wis.

Oct. 17, 1945

Lloyd R. Jensen
County Surveyor