


#1605

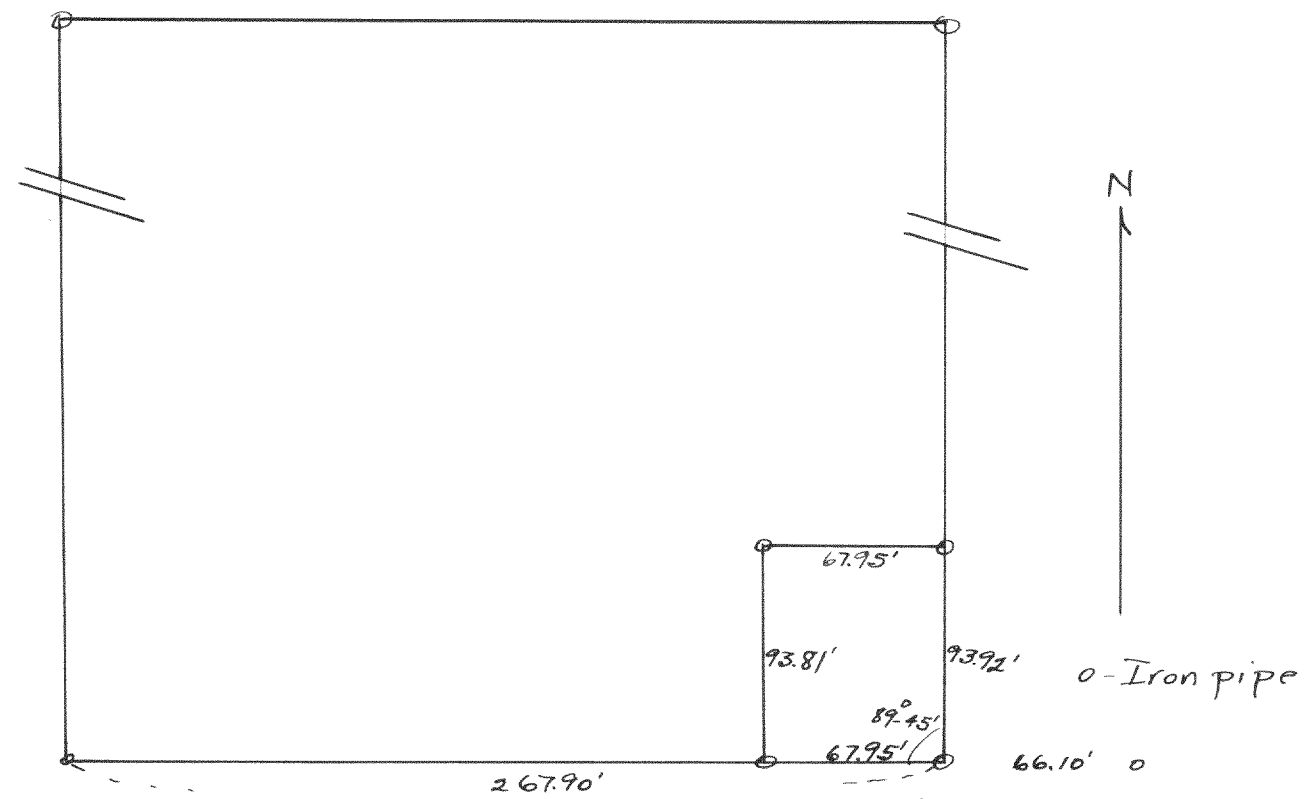


Plot of survey of the E. $\frac{1}{2}$ of Lot 4 of Blk. 3 of
the C. P. of the City of Oakhorn, also
here as all of the land lying E. of the
West 66' of said lot & Blk.

Oct. 1945

Floyd L. Jensen
County Surveyor

#1606

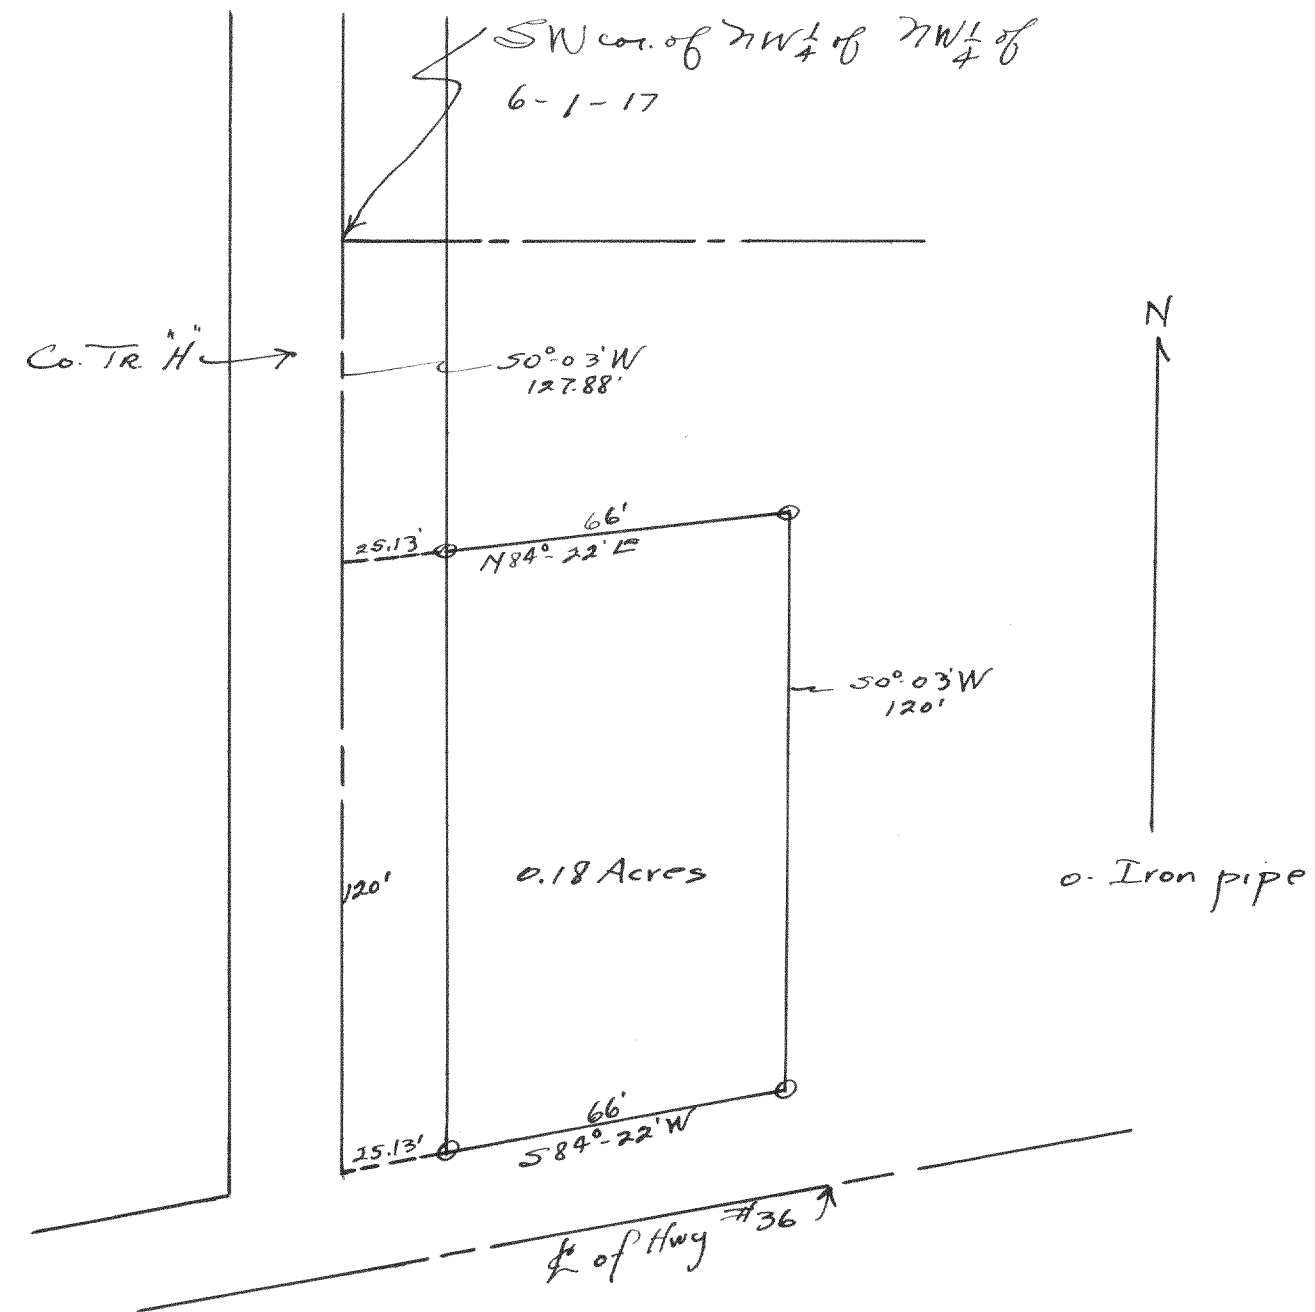

Plot of a survey of a parcel of land located
in the NW $\frac{1}{4}$ of Section 6-1-17 - Village of
Williams Bay Wisconsin.

Nov. 1945

Floyd L. Jensen
County Surveyor