



#1607

#1608

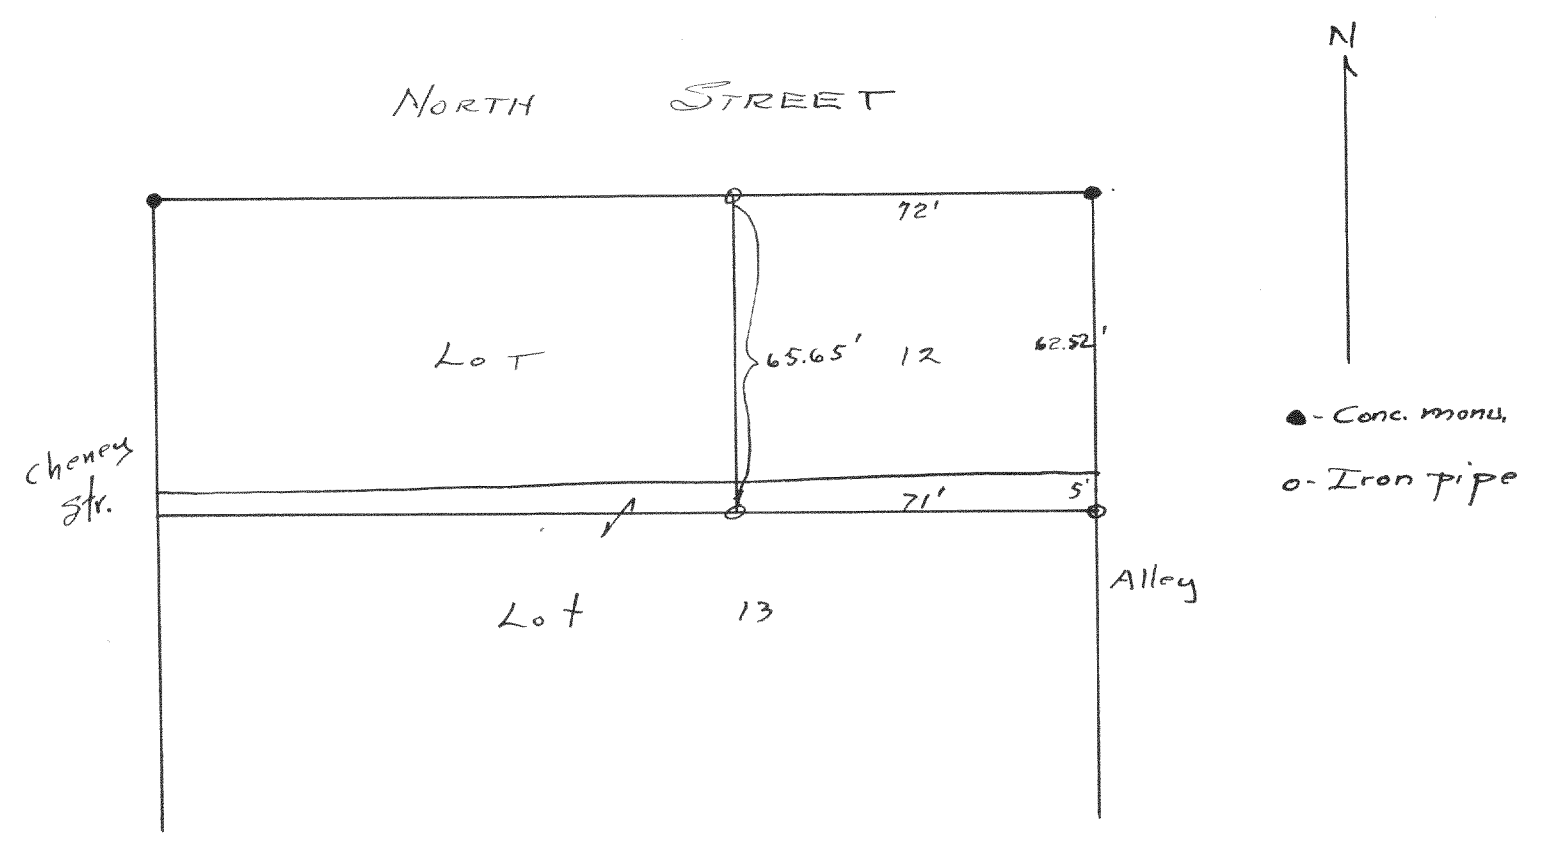

Plot of survey of part of lots 12 and 13
of Blk 2 of Supp's 2nd Add. to the
City of Whitewater.
Oct. 24, 1945
Lloyd L. Jensen
County Surveyor

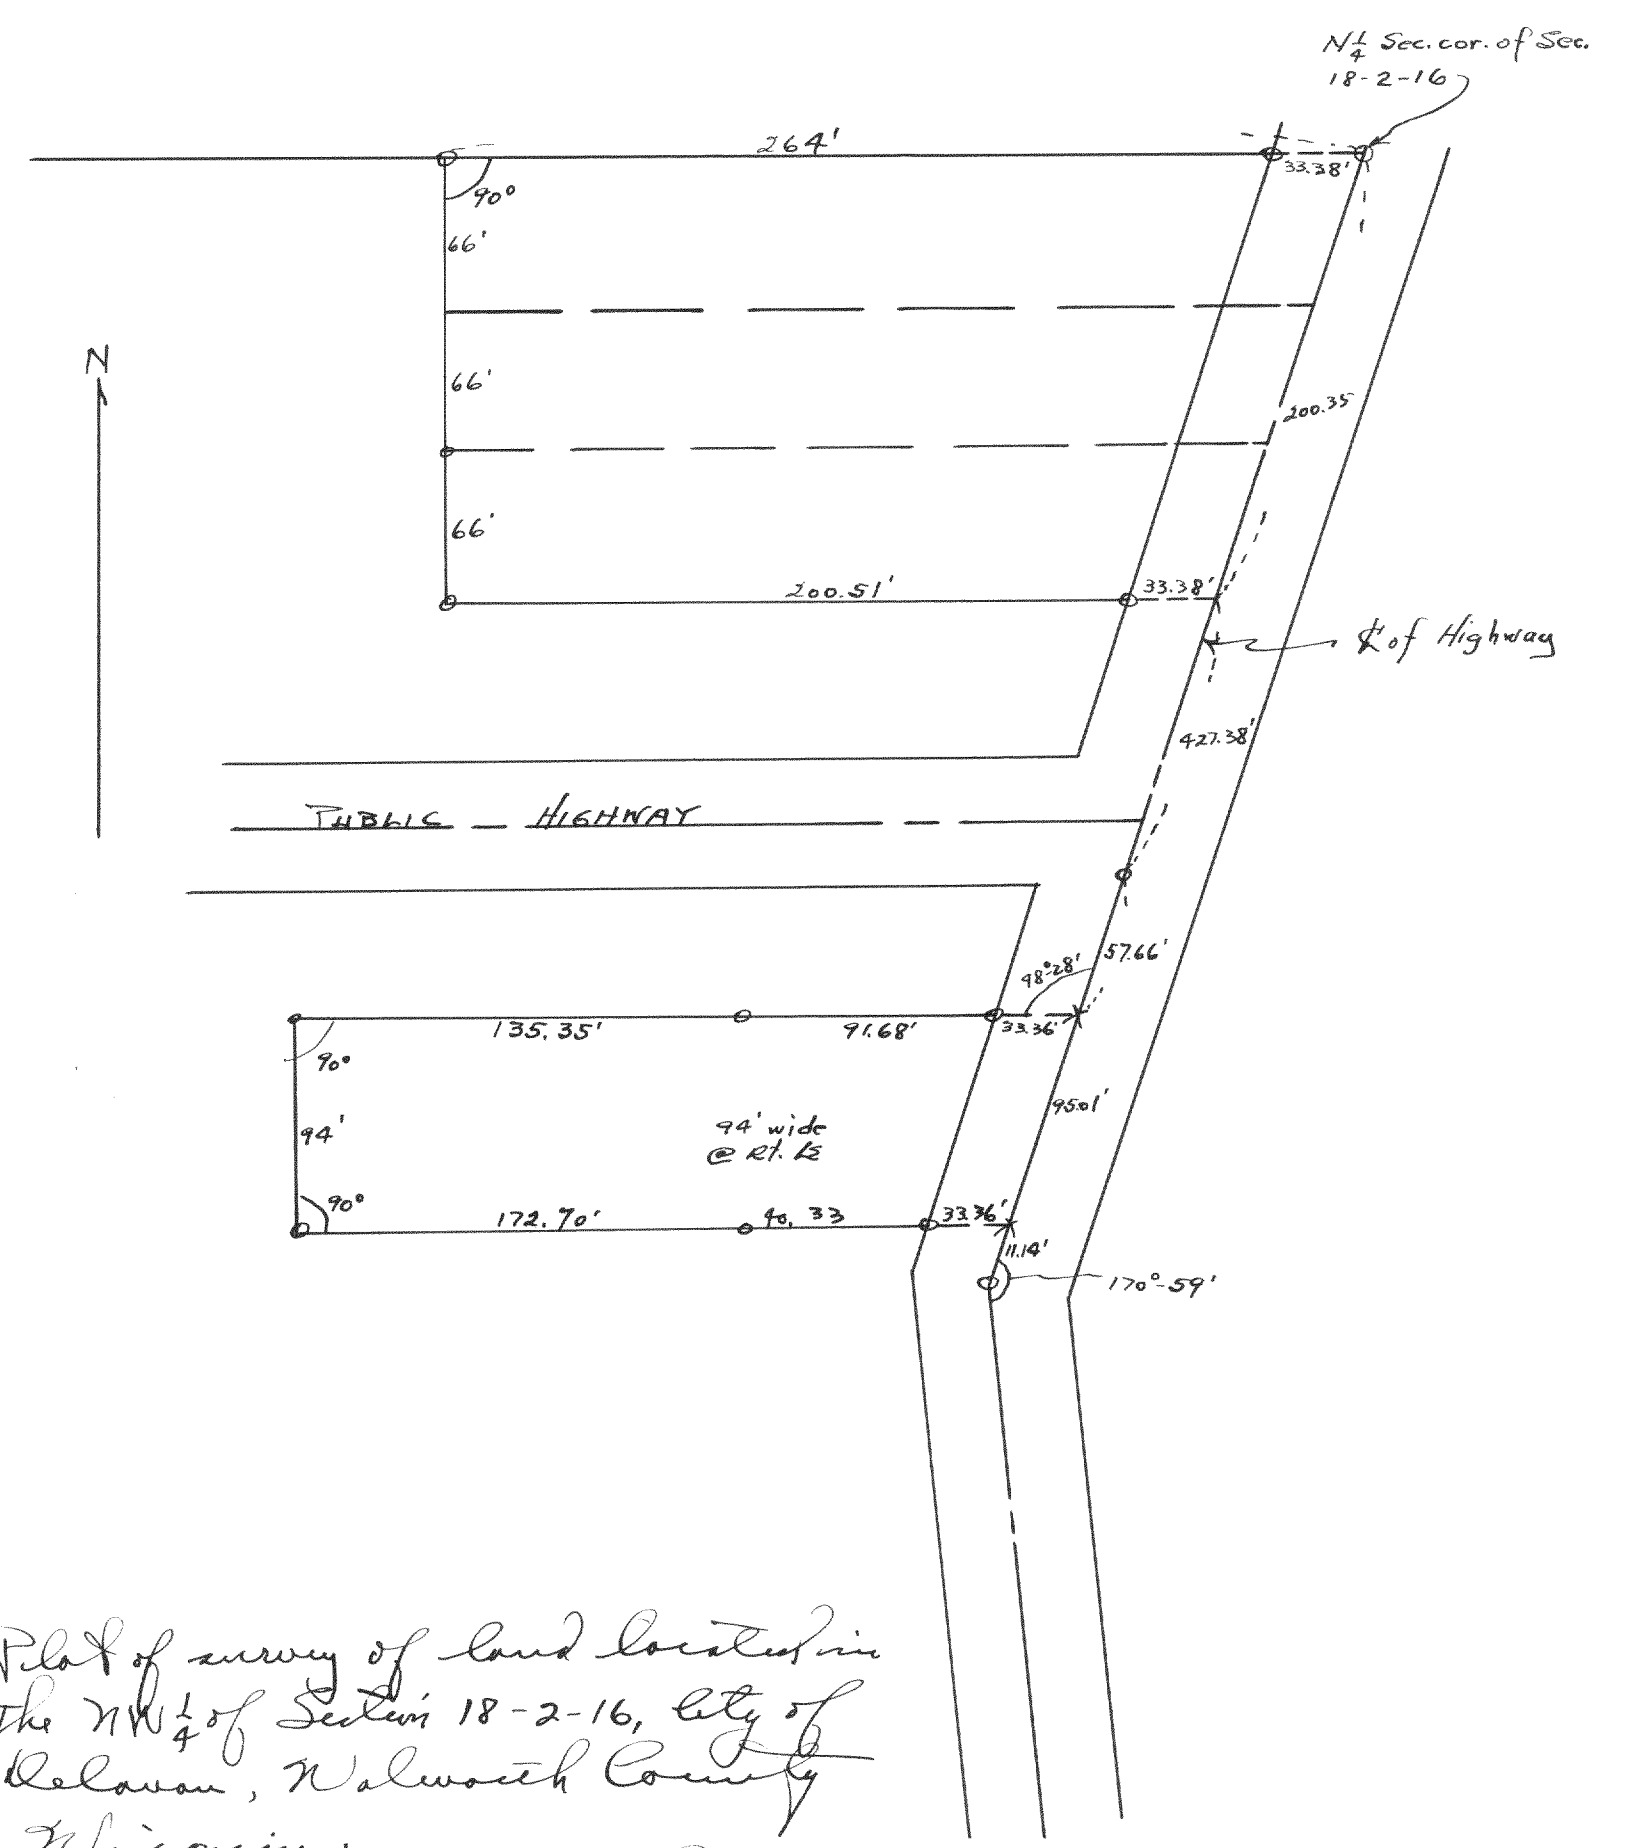

Plot of survey of land located in
the NW 1/4 of Section 18-2-16, City of
Delavan, Walworth County
Wisconsin.
May 19 45
Lloyd L. Jensen
County Surveyor