



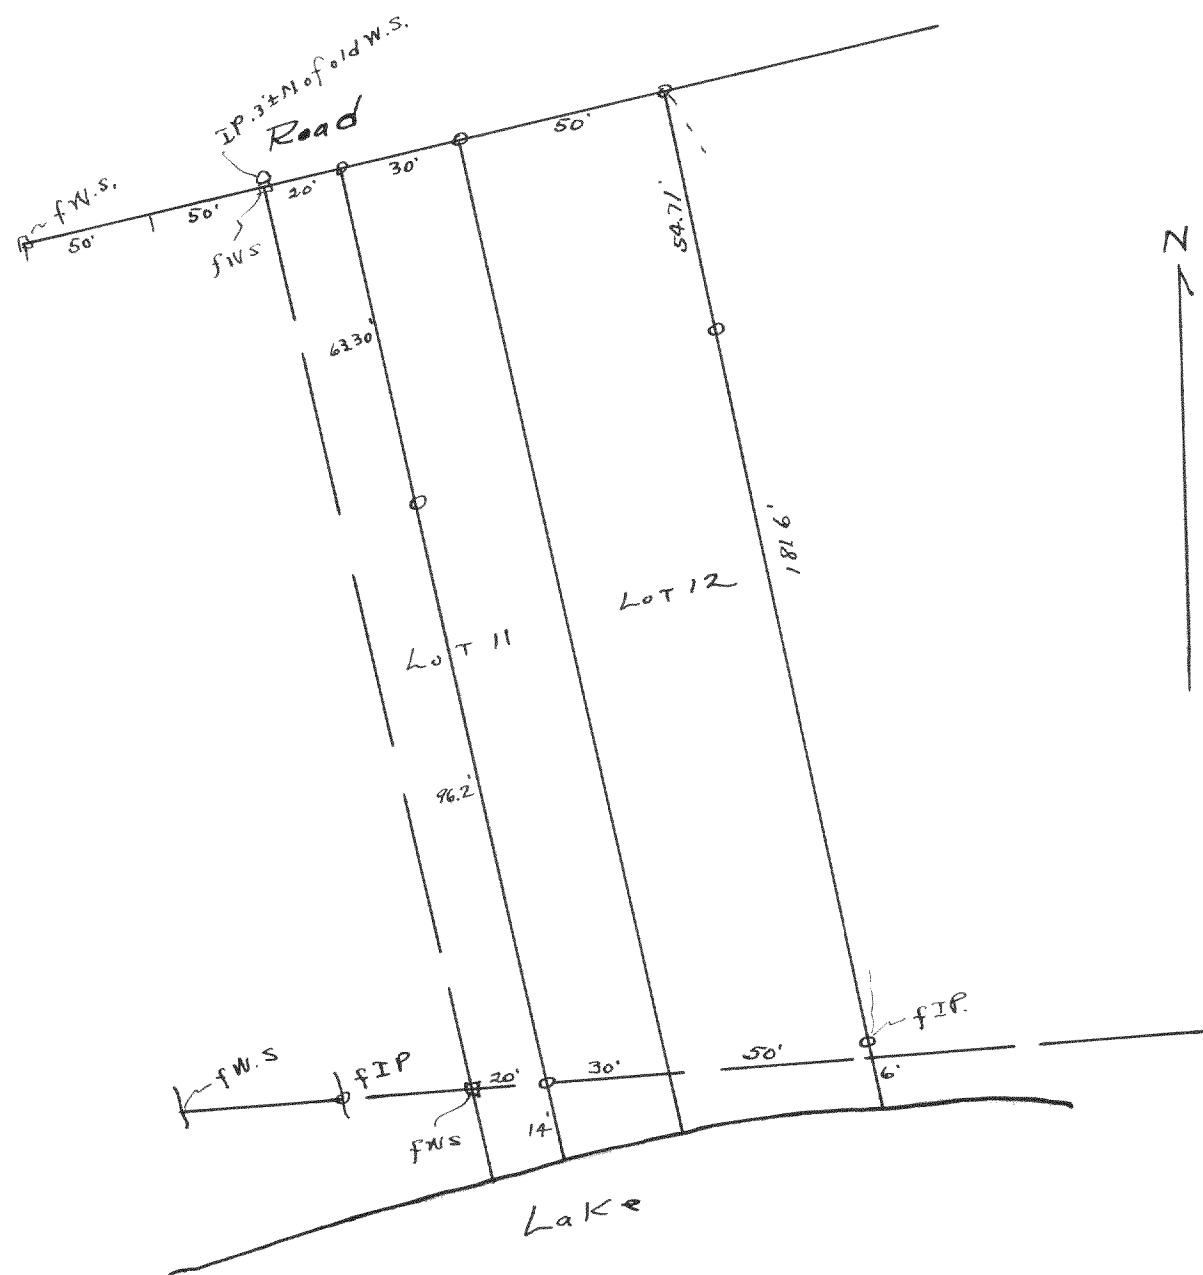

Plot of survey of Lot 12 and the
E. 30' of Lot 11 of the 1st. Add. to
Sandcastle Park.

June 1945

Lloyd L. Jensen
County Surveyor

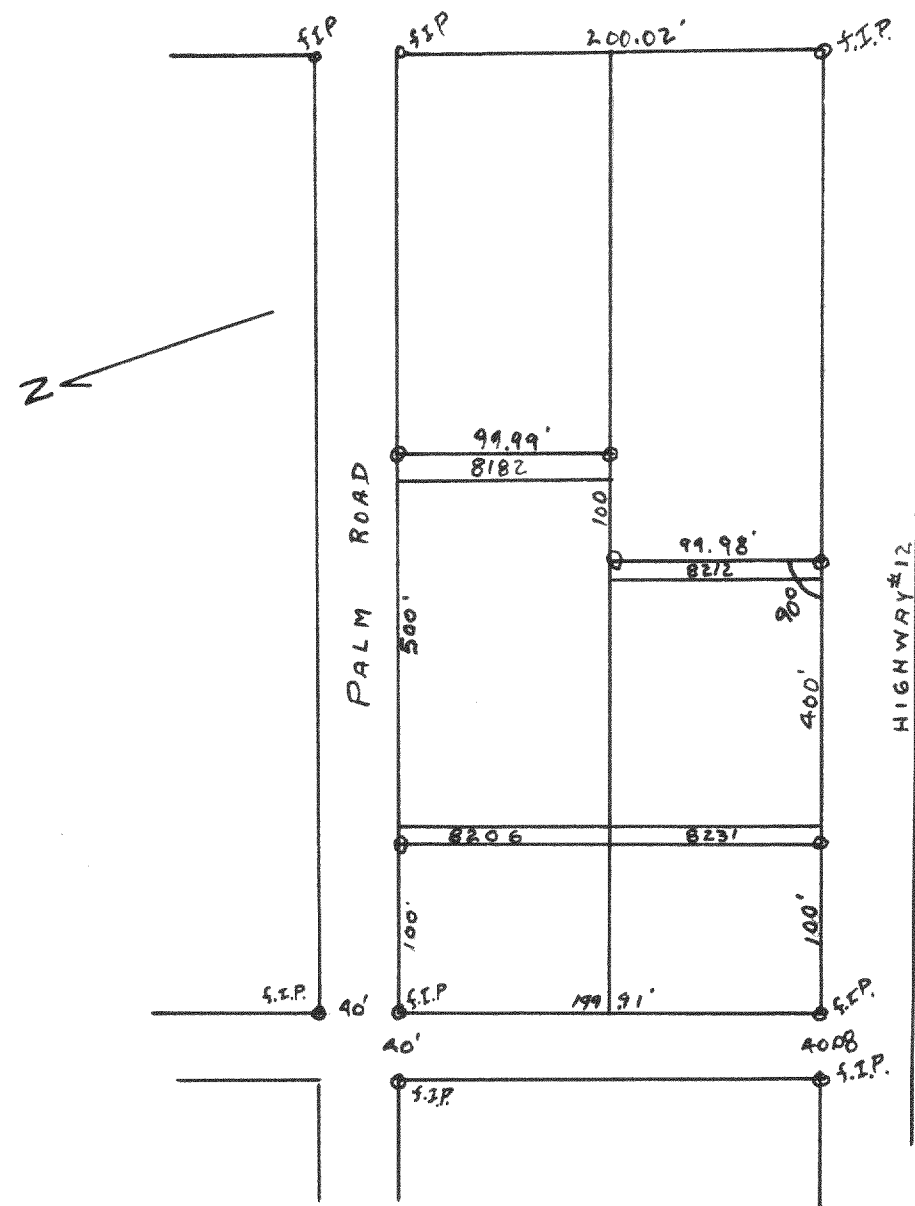

Plot of survey of Lots 8182 to 8206 and
Lots 8212 to 8231 in section 5 of Bell Lake
Subdivisions Walworth County, Wisc.

Oct. 1946

Lloyd Jensen
County Surveyor
G.T.D.