



1611

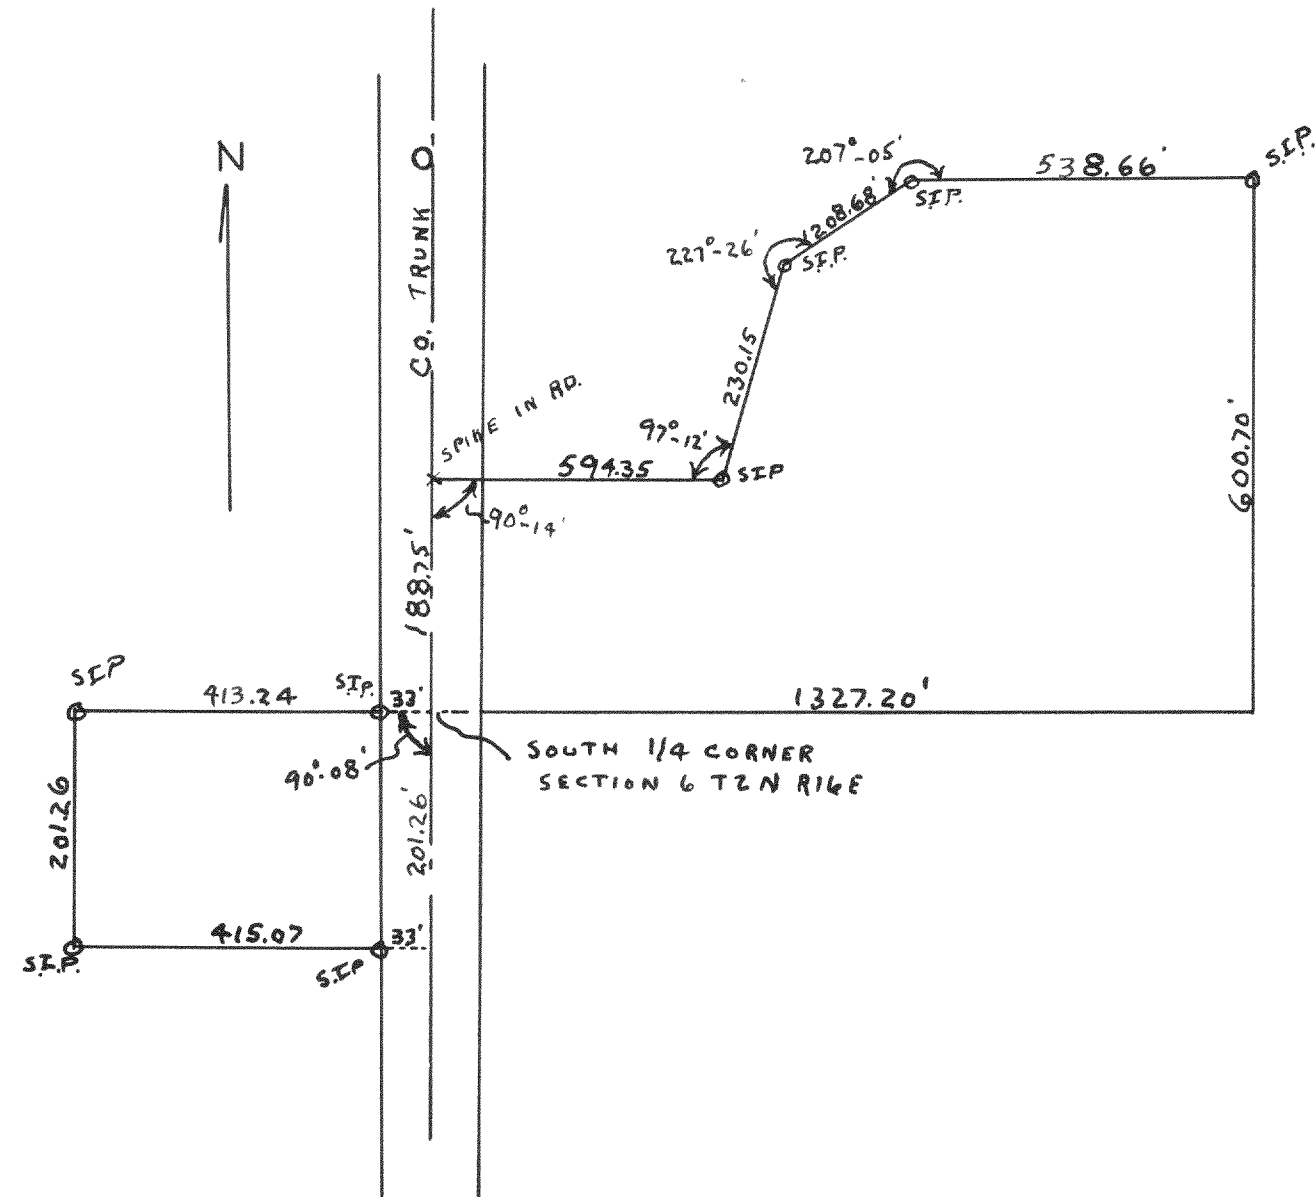

Plat of survey of a part of the Robbinswood Farm located in the SW 1/4 of the SE 1/4 of section 6-1-16 and the NE 1/4 of the NW 1/4 of section 7-1-16 in Walworth County, Wisconsin
June 1946
Lloyd Jensen
County Surveyor
G.T.D.

1612

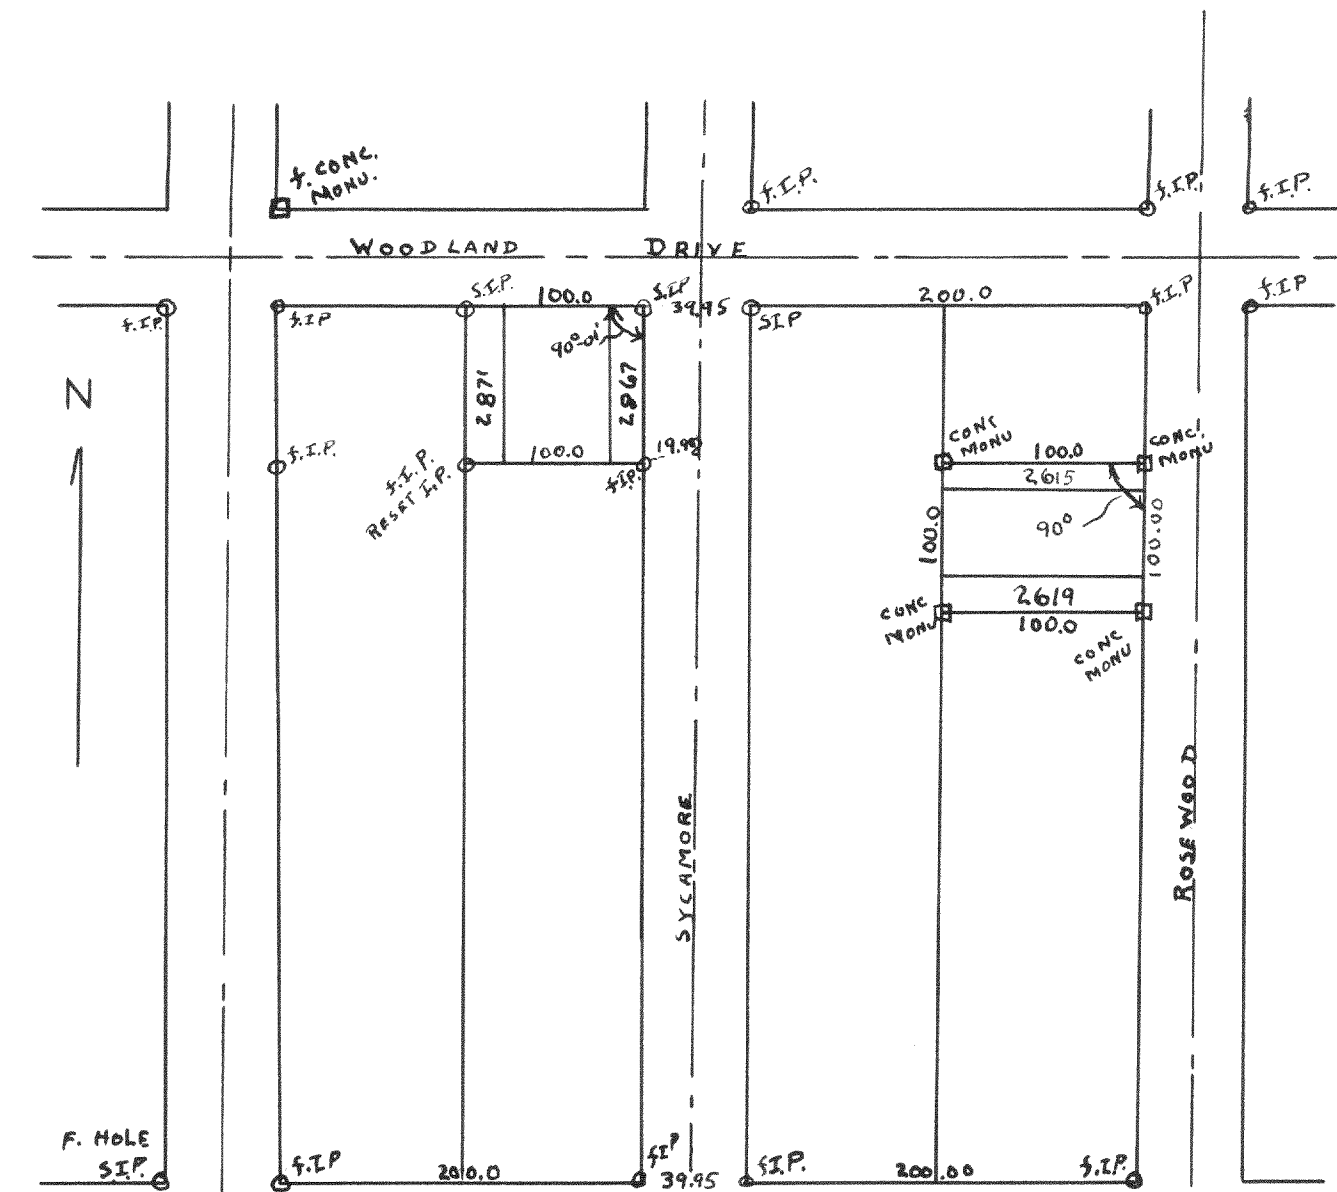

Plat of Survey of Lots 2615 to 2619 and 2867 to 2871 of Lake Como Beach subdivisions in Walworth County Wisconsin

Aug. 1946

Lloyd L Jensen
County Surveyor
G.T.D.