



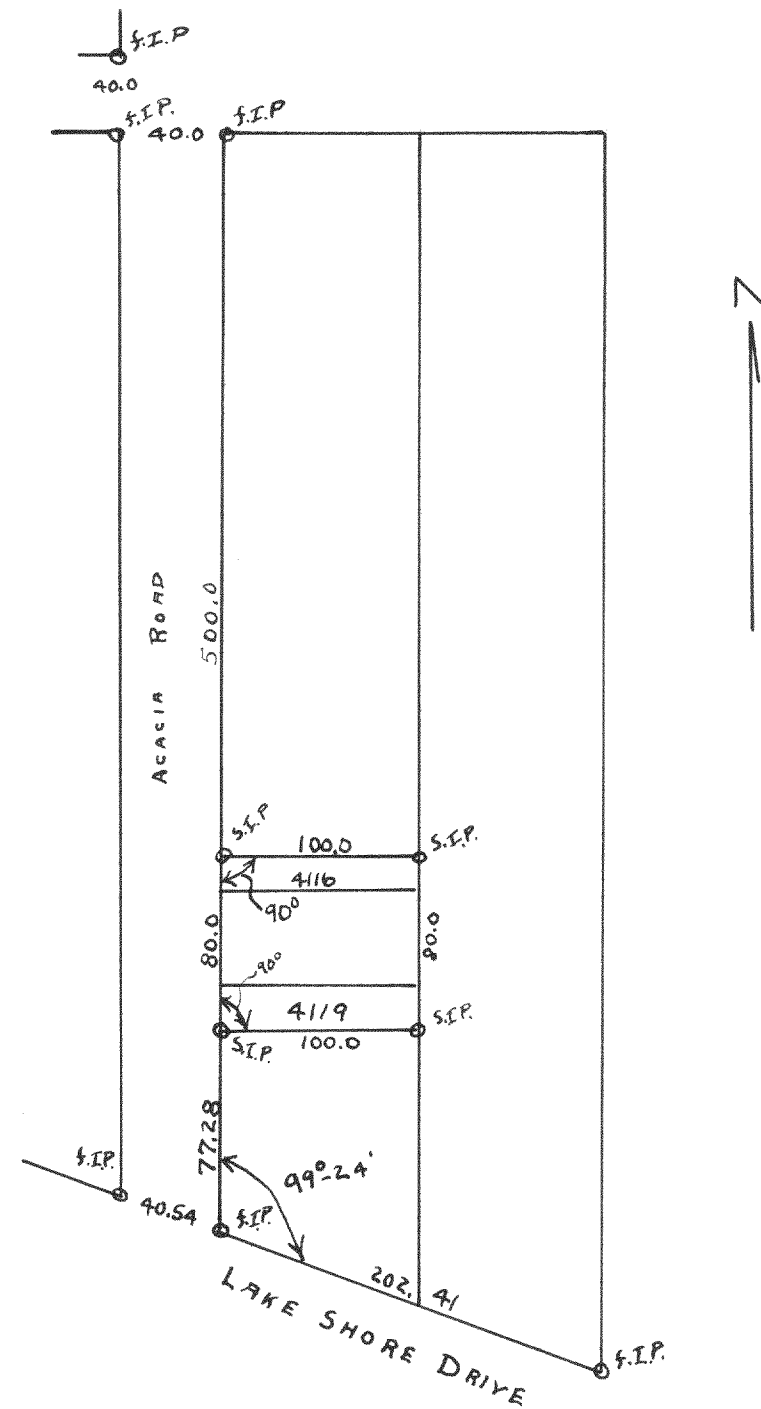

Plot of Survey of Lots 4116 to 4119 of
Lake Como Beach Subdivision, Walworth
County, Wisconsin

Aug. 1946

Lloyd I Jensen
County Surveyor
G.I.D

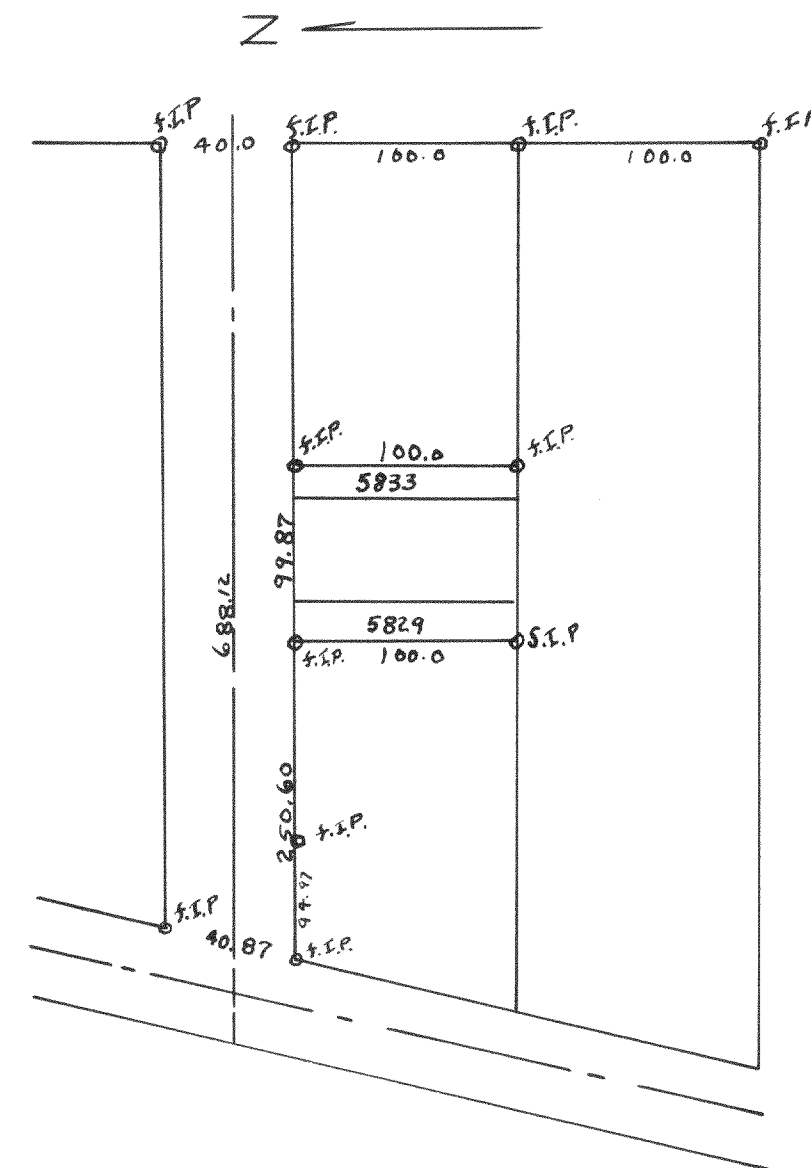

Plot of Survey of Lots 5829 to 5833 in Section 4
of Pell Lake Subdivision Walworth County, Wisconsin

Aug 1946

Floyd L Jensen
County Surveyor
G.T.D.